
GEORGE T. DUNHAM

SURVEYING & SUBDIVIDING

DELAVAN, WISCONSIN

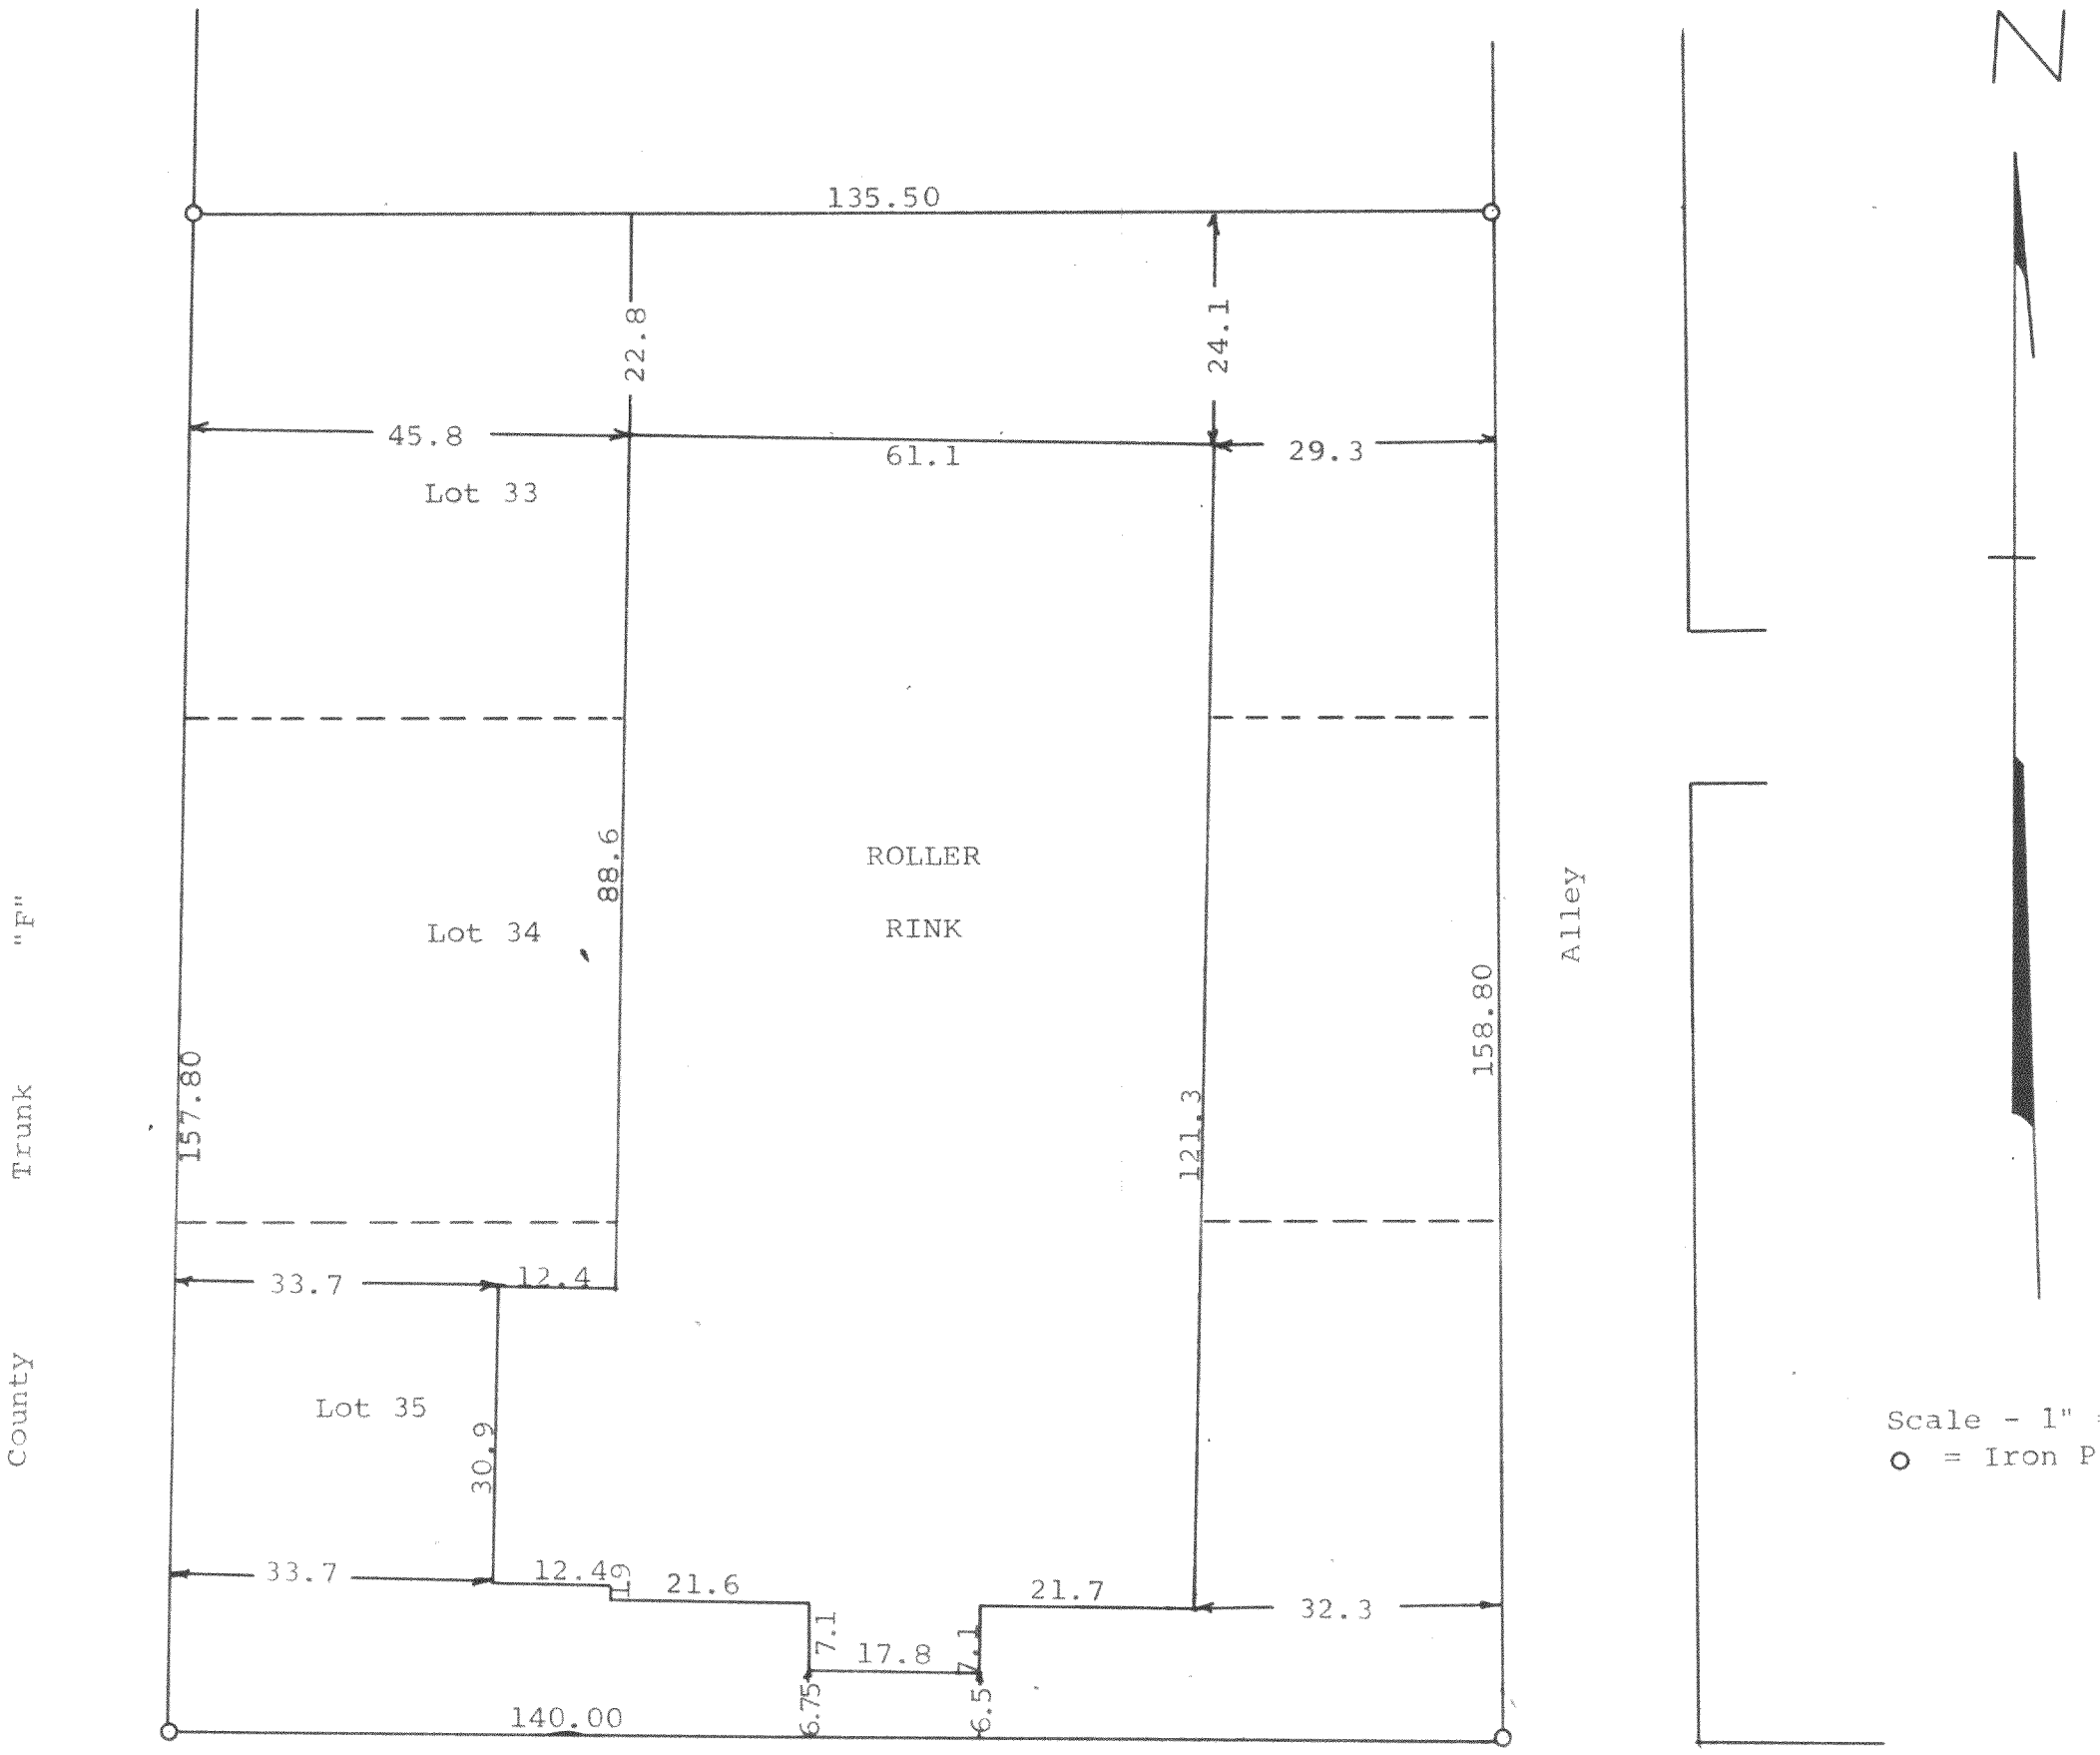

DELAVAN DRIVE

STATE OF WISCONSIN)
SS
COUNTY OF WALWORTH)

I, George T. Dunham, Surveyor, certify that I have surveyed the property described as follows,

Lots 33, 34, and 35 in Block 2 of Inlet Oaks Subdivision No. 4 located in Section 15, T 2 N, R 16 E, Walworth County, Wisconsin,

and that the above plat is an accurate survey and a true representation thereof and correctly shows the exterior boundary lines and location of buildings on said property and the correct measurements thereof.

April 23, 1970

George T. Dunham

George T. Dunham, Surveyor

216-349

FIN4-16