
GEORGE T. DUNHAM

SURVEYING & SUBDIVIDING

DELAVAN, WISCONSIN

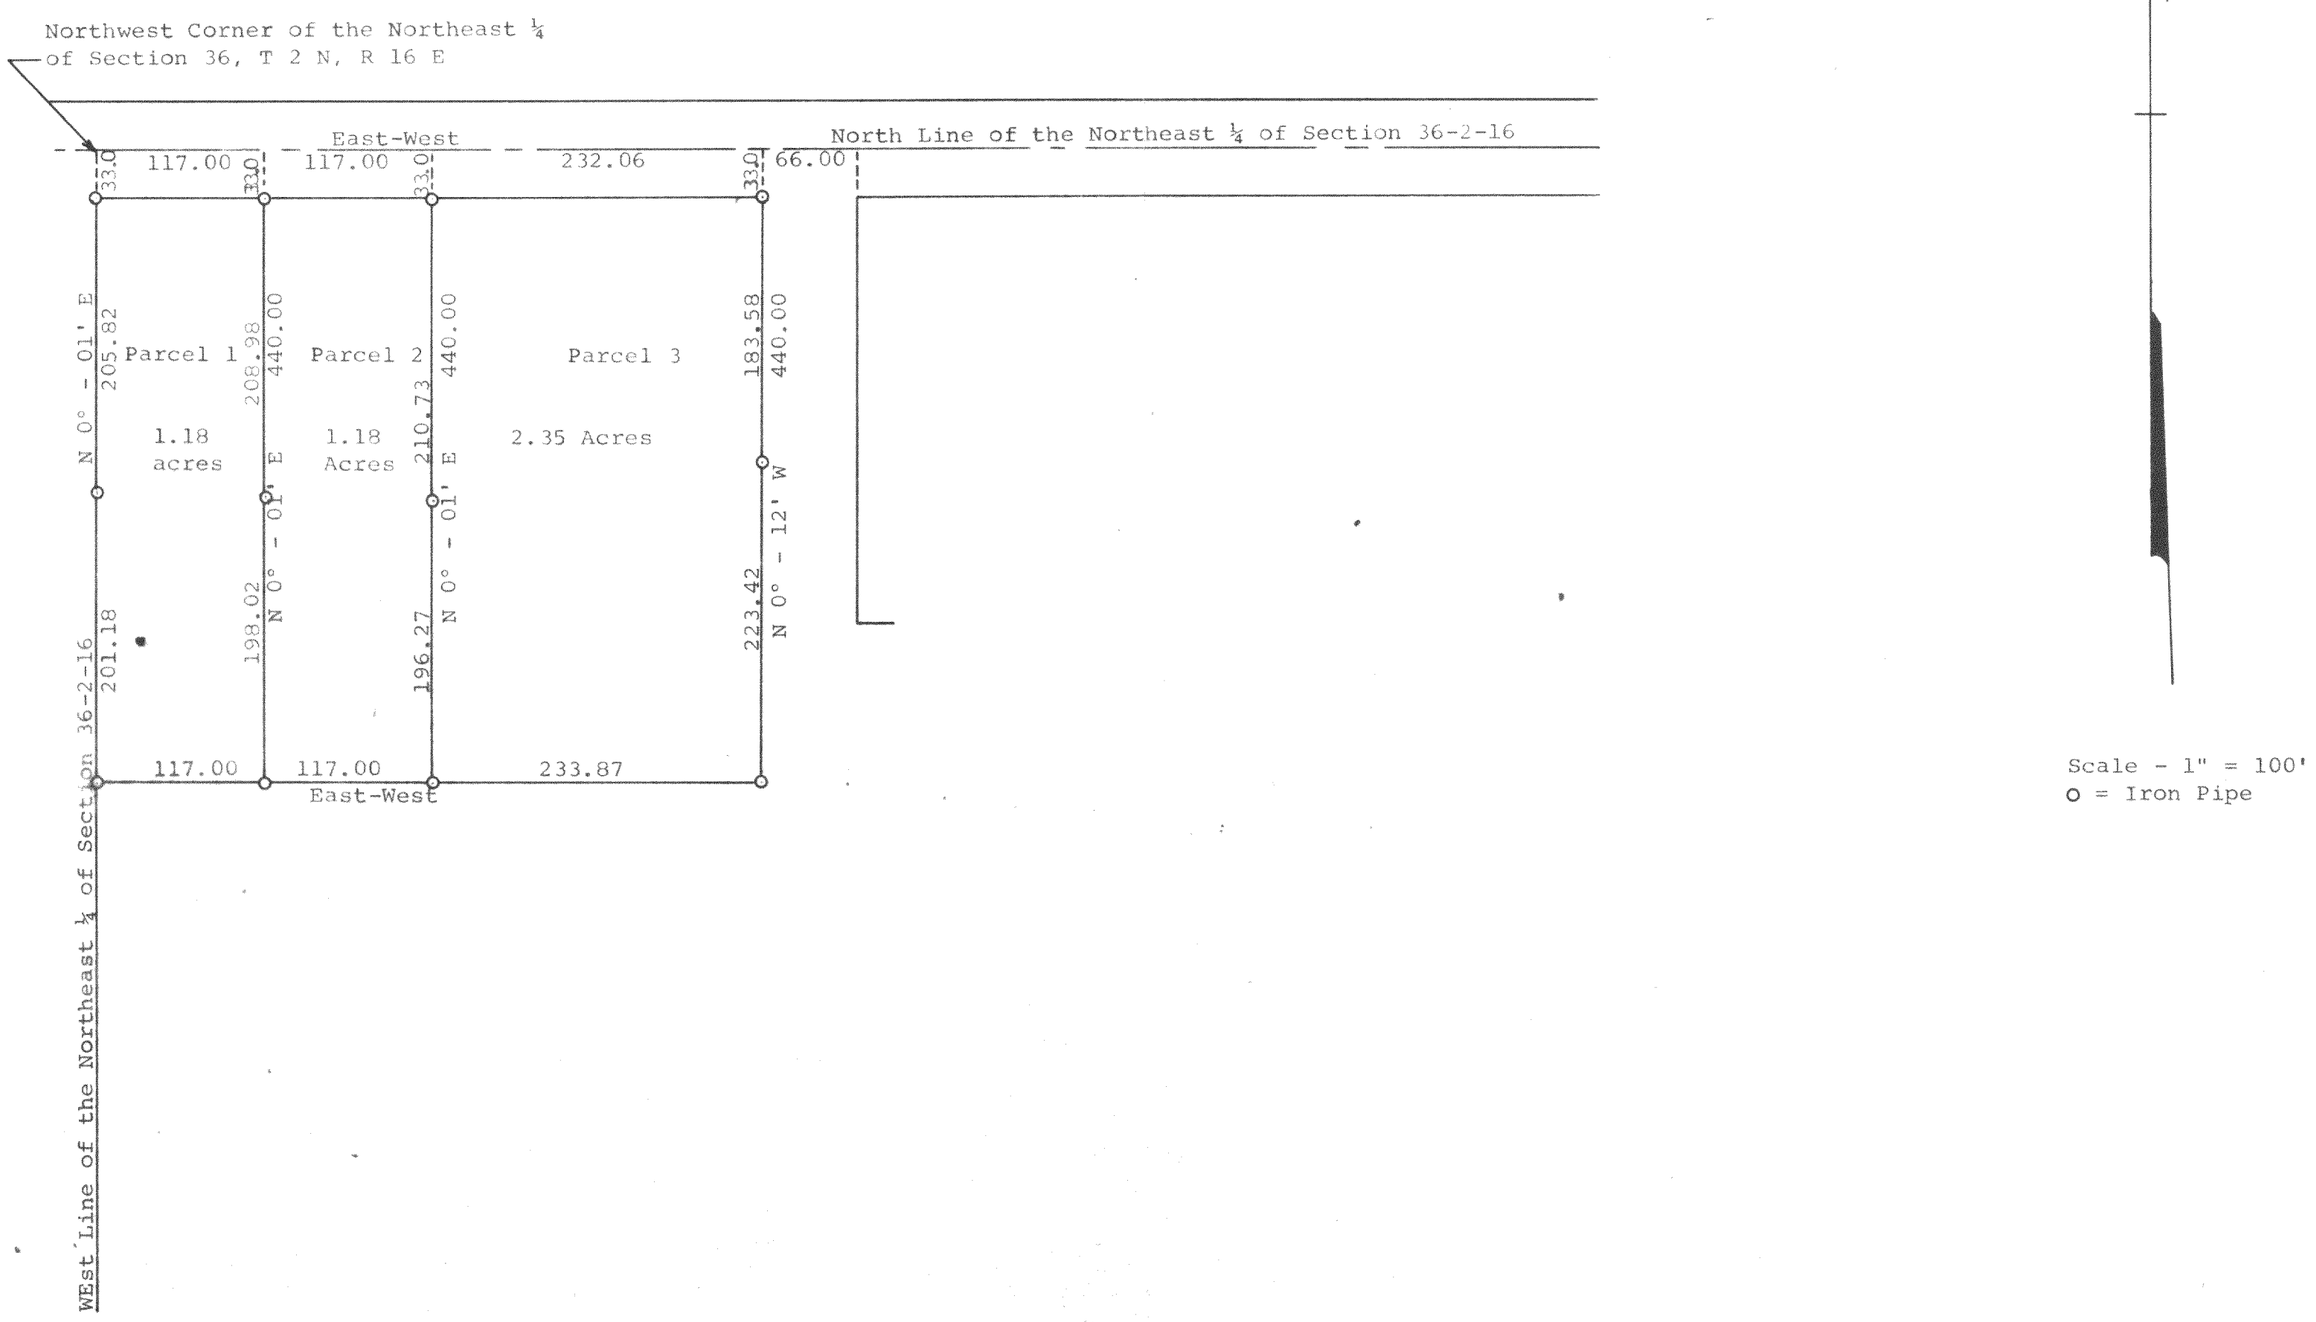

Plat of survey of several parcels of land located in the Northeast ¼ of Section 36, T 2 N, R 16 E, Walworth County, Wisconsin.
October 30, 1969

Jerry T. Dunham

George T. Dunham, Surveyor

D-36-113
D-36-114
D-36-115

K & E 10-7155 250-3-68

216-347