ABERNATHY and ASSOCIATES
Kenneth B. Abernathy Jr.
Wisconsin Registered Land Surveyor S-1594


W4056 BRAY RD.
ELKHORN, WI. 53121
PHONE: (262) 723-4260 (OFFICE)
(262) 723-7209 (FAX)
Email: abernathy@elknet.net

OWNERS: VERNON AND JEANETTE BARTELS
5355 DRIFTWOOD CT.
LISLE, IL. 60532-2049

PLAT OF SURVEY

LOT 370, LAKE DELAVAN HIGHLANDS
LOCATED IN T.2 N., R. 16 E., WALWORTH
COUNTY, WISCONSIN.

RECEIVED
AUG 19 2003
RP

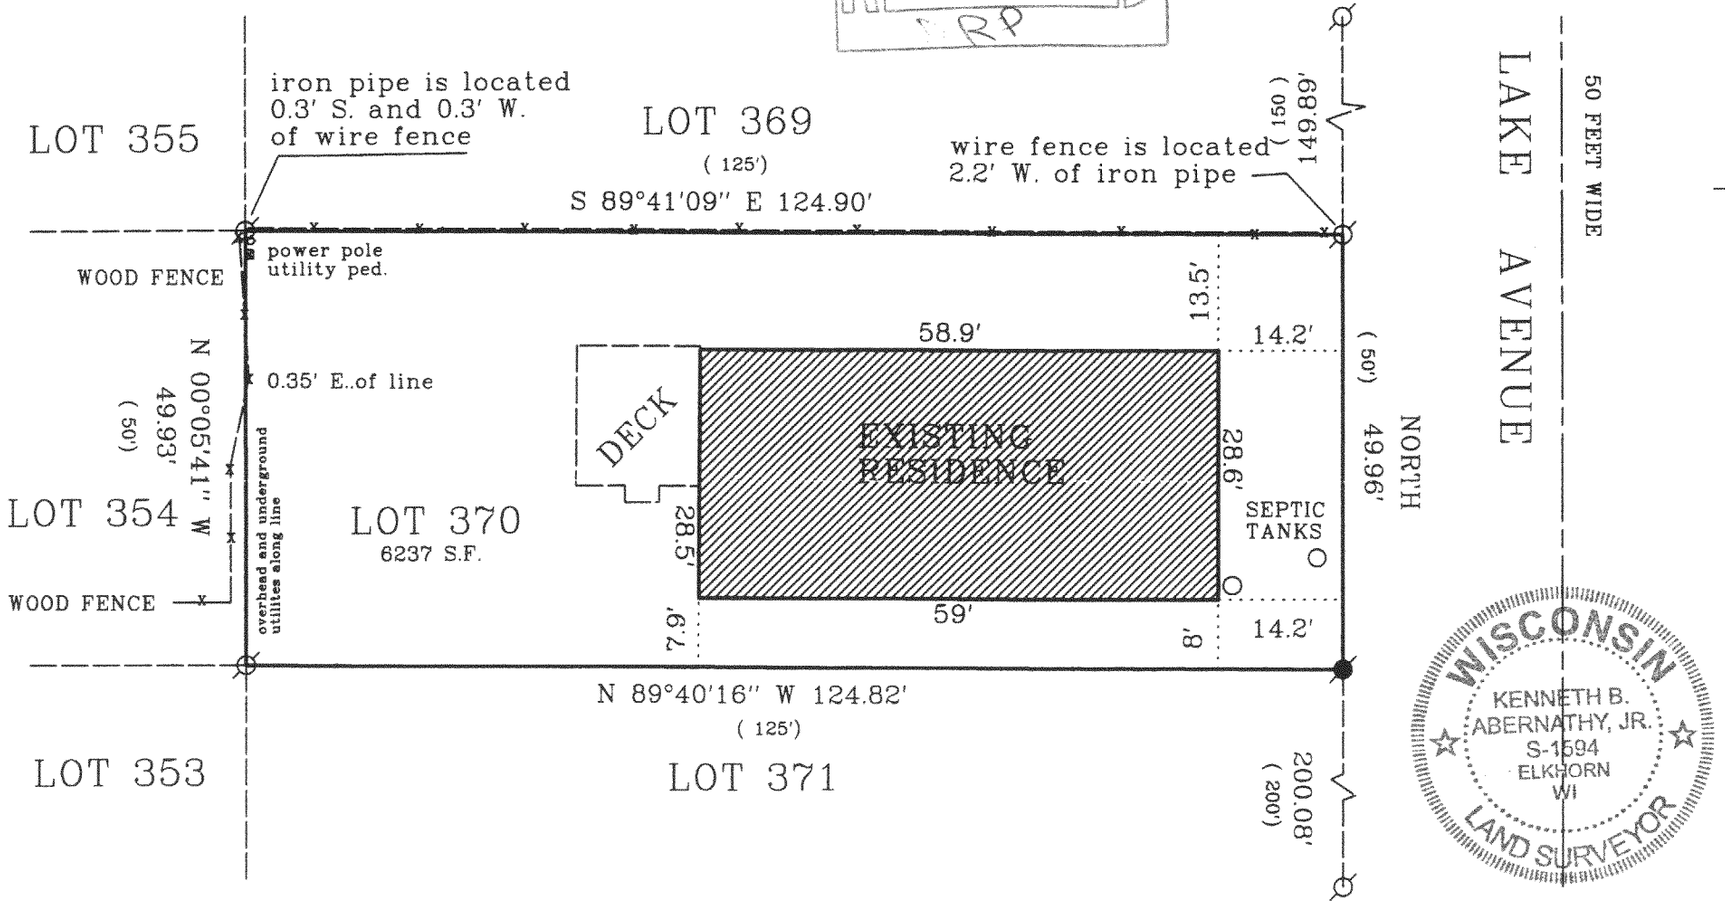

Legend

- ⌀ FOUND IRON PIPE
- ⌀ FOUND IRON ROD
- ⊠ FOUND BRASS CAPPED MONUMENT
- ⊗ FOUND CONCRETE MONUMENT
- \+ CHISEL CUT IN CONCRETE
- ● SET IRON ROD, 24" LONG, WEIGHING 1.5 LBS./LINEAL FT., 3/4" DIA.
- ● SET IRON ROD, 30" LONG, WEIGHING 4.5 LBS./LINEAL FT., 1-11/16" DIA.
- (x x) RECORDED AS DIMENSION
- EXISTING FENCE

N

WEST LINE OF LAKE AVENUE ASSUMED TO BEAR NORTH

SCALE: 1" = 20 FEET

"I hereby certify that the above described property has been surveyed by me or under my direction and that the above map is a true representation thereof and shows the size and location of the property, its exterior boundaries, the location of all visible structures and dimensions of all principal buildings thereon, boundary fences, apparent easements, roadways and visible encroachments, if any."
"This survey is made for the use of the present owners of the property, and also those who purchase, mortgage, or guarantee the title thereto within one year from the date hereof."

WISCONSIN
KENNETH B. ABERNATHY, JR.
S-1594
ELKHORN
WI
LAND SURVEYOR

KENNETH B. ABERNATHY, JR.
WISCONSIN REGISTERED LAND SURVEYOR
S-1594

Date: May 30, 2003 Job No. 03.508

FLAD-280

216-3577