FARRIS, HANSEN & ASSOCIATES, INC.


ENGINEERING – ARCHITECTURE – SURVEYING
7 RIDGWAY COURT – P.O. BOX 437 – ELKHORN, WISCONSIN 53121
PHONE: (262) 723–2098 FAX: (262) 723–5886

PLAT OF SURVEY

LOT 1 OF C.S.M. 1395, REC. IN VOL. 6,
PG. 259, AS DOC. NO. 108935

LOCATED IN SECTION 29, TOWN 2 NORTH,
RANGE 16 EAST, WALWORTH COUNTY, WISCONSIN

– WORK ORDERED BY –
PAM KURTZ – JK CONSTRUCTION
9117 DUSK DRIVE
ELKHORN, WI 53121

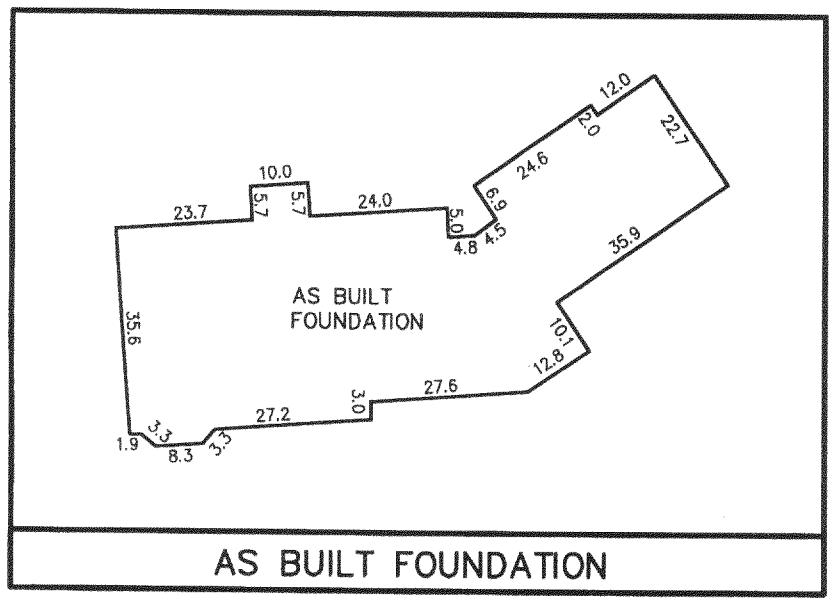

AS BUILT FOUNDATION

NORTH SHORE DRIVE
66' WIDE R.O.W.
N 89°32'46" E
166.96

PRIVATE DRIVE
66' WIDE R.O.W.
S 00°41'00" E
572.41

970.53'
N 00°41'00" W
1100.73'

S 32°14'50" E
C=62.83'
A=66.12'
R=60.00

LOT 1

S 00°39'05" E
377.52

LOT 3
C.S.M.
1395

AS BUILT
FOUNDATION
(SEE DETAIL)
70.5'
22.5
143'
N 81°07'39" W
202.41'
130' +/-
29.4' +/-

DELAVAN LAKE
211' +/- ALONG THE SHORE

LEGEND

○ = FOUND IRON PIPE STAKE
(XXX) = RECORDED AS
⊗ = FOUND NAIL IN PAVEMENT

N

ASSIGNED WEST LINE OF OUTLOT 1
OF C.S.M. 1395 REC. IN VOL. 6,
PG. 259, AS DOC. NO. 108935
N 00°41'00 W

NOV 20 2003

KW

NOTE: COPIES OF THIS MAP TO WHICH THE FOLLOWING CERTIFICATE WILL APPLY SHOW THE SURVEYOR'S ORIGINAL SEAL AND SIGNATURE IN RED INK. COPIES BY ANY OTHER MEANS MAY HAVE ALTERATIONS WHICH DO NOT REPRESENT THE SURVEYOR'S WORK PRODUCT.

I HEREBY CERTIFY THAT THE ABOVE DESCRIBED PROPERTY HAS BEEN SURVEYED UNDER MY DIRECTION AND THAT THE ABOVE MAP IS A TRUE REPRESENTATION THEREOF AND SHOWS THE SIZE AND LOCATION OF THE PROPERTY AND ITS EXTERIOR BOUNDARIES. THIS SURVEY IS MADE FOR THE USE OF THE PRESENT OWNERS OF THE PROPERTY, AND ALSO THOSE WHO PURCHASE, MORTGAGE, OR GUARANTEE THE TITLE THERETO WITHIN ONE YEAR FROM THE DATE HEREOF.

DATED: JULY 24, 2003

REVISED 10–28–03
TO SHOW SIZE & LOCATION OF
AS BUILT FOUNDATION

PETER S. GORDON R.L.S. 2101

100 50 0 100 200 300 400
MAP SCALE IN FEET ORIGINAL 1"= 100'

PROJECT: 6313
DATE: 07/24/2003
SHEET 1 OF 1

FA1395-1

216-3631