
ABELL
SURVEYING & MAPPING
1140 SEQUOIA STREET • DELAVAN, WISCONSIN 53115
262-728-6737

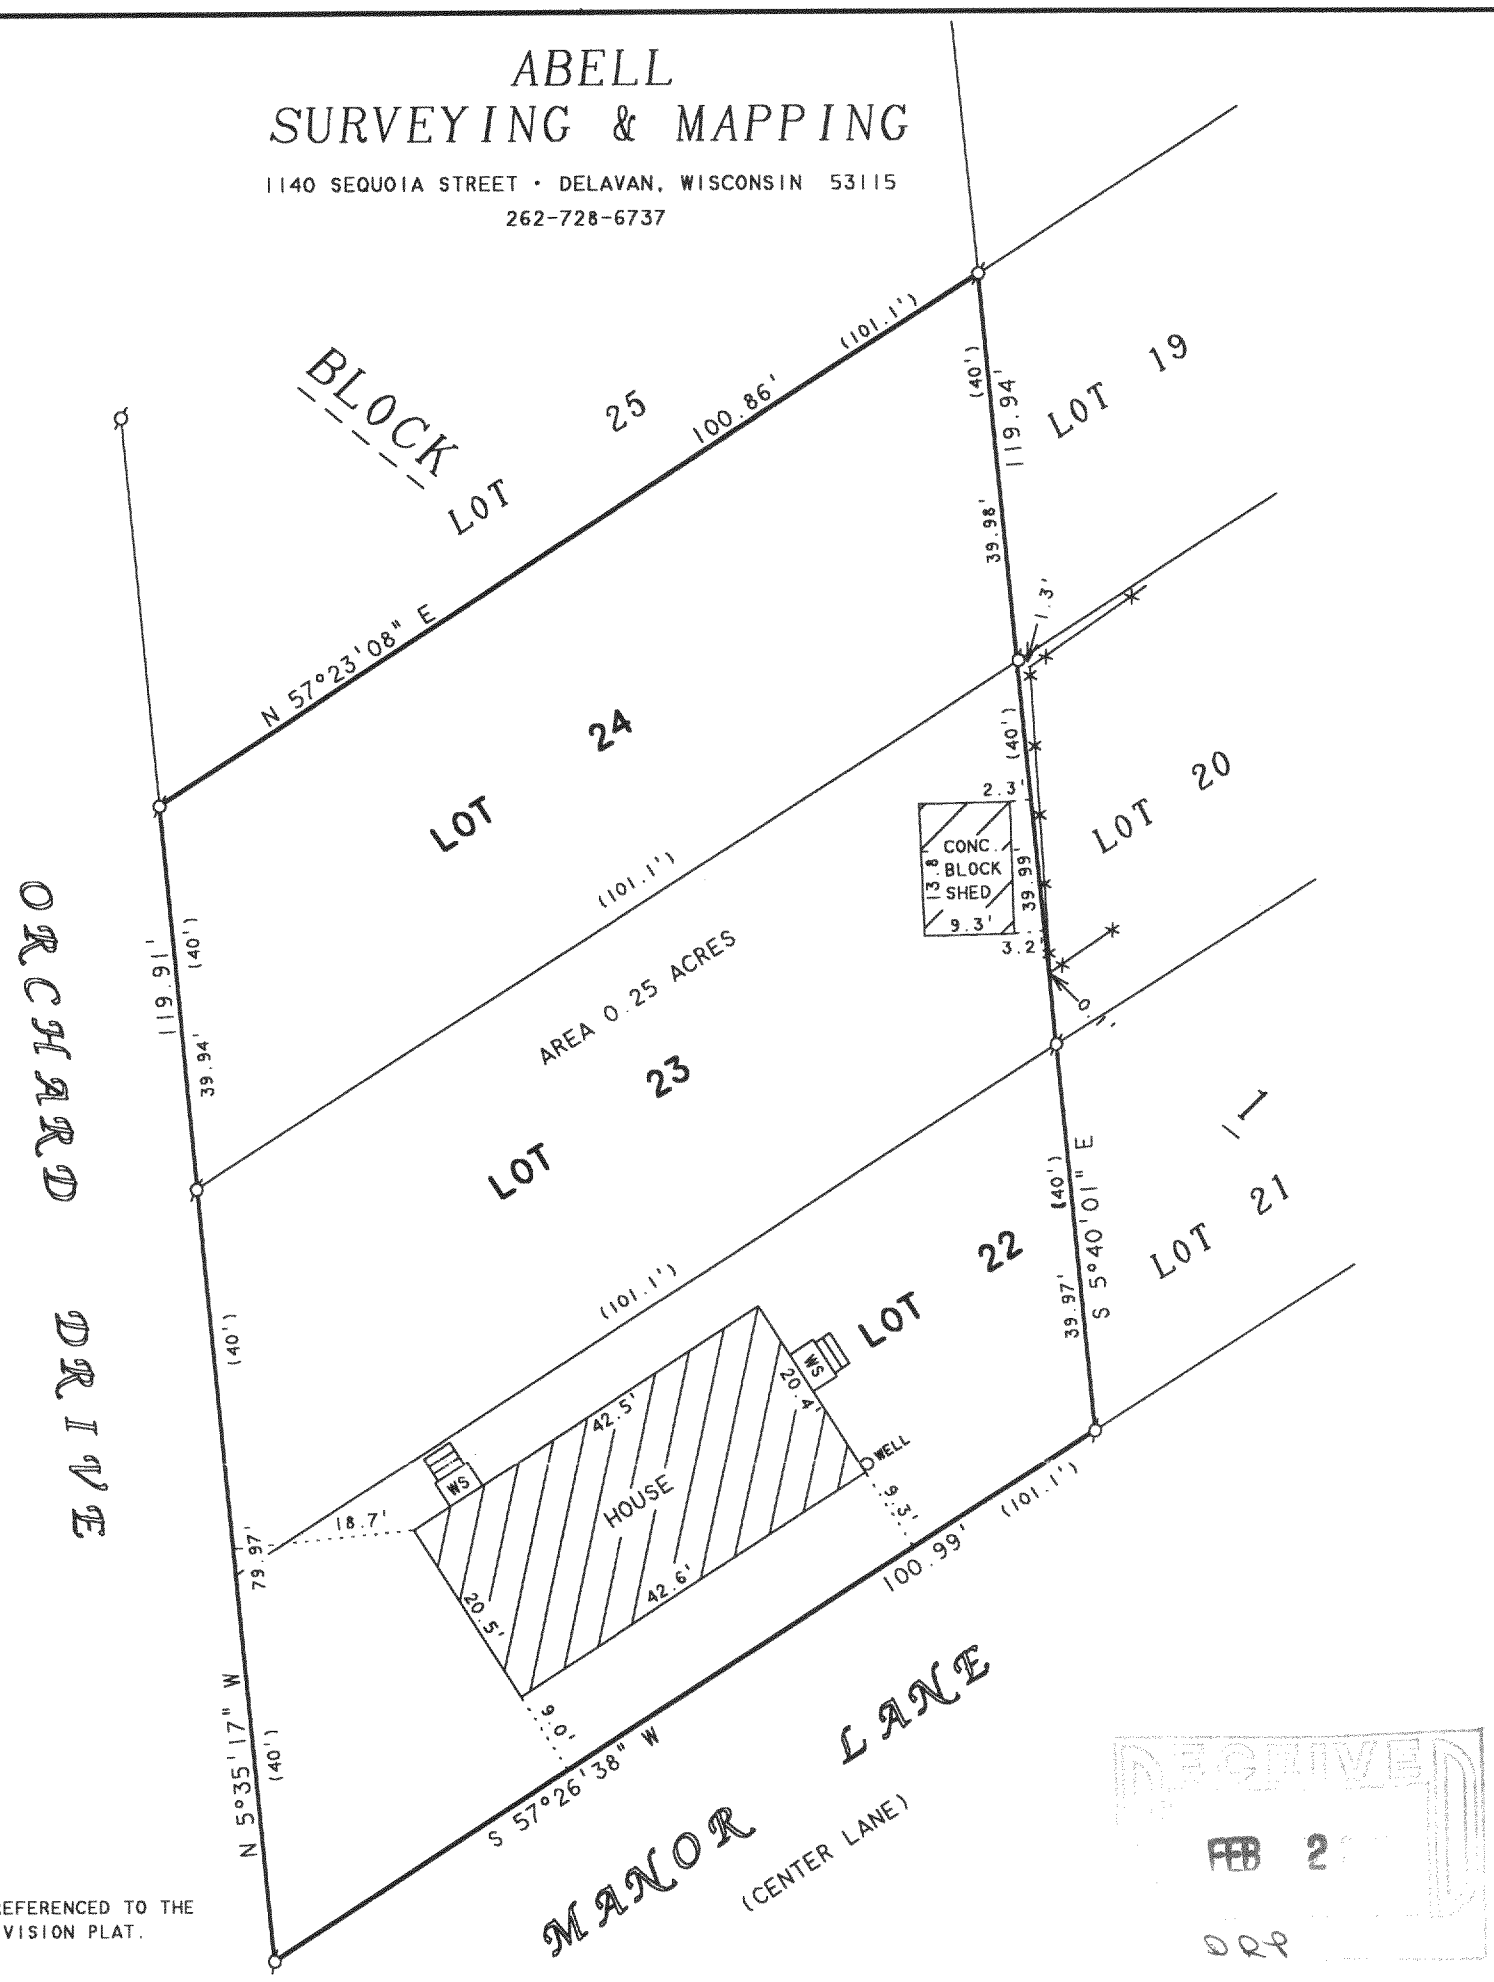

NOTE: BEARINGS ARE REFERENCED TO THE RECORDED SUBDIVISION PLAT.

RECEIVED
FEB 2
DRP

N

SCALE 1"=20'

LEGEND

- ⌀ - IRON PIPE FOUND
- -x-x- - CHAINLINK FENCE
- WS - WOOD STOOP
- ( )- RECORDED AS

ORDERED BY: ATTY. LOUIS H. SCHERB
234 WAUKEGAN ROAD
GLENVIEW, IL 60025

PLAT OF SURVEY OF

LOTS 22-24, BLOCK 1, SOUTH SHORE MANOR, LOCATED IN T2N,R16E, WALWORTH COUNTY, WISCONSIN.

I HEREBY CERTIFY THAT I HAVE SURVEYED THE ABOVE DESCRIBED PROPERTY AND THAT THE ABOVE MAP IS A TRUE REPRESENTATION THEREOF AND SHOWS THE SIZE AND LOCATION OF THE PROPERTY, ITS EXTERIOR BOUNDARIES, THE LOCATION OF ALL VISIBLE STRUCTURES AND DIMENSIONS OF ALL PRINCIPAL BUILDINGS THEREON, BOUNDARY FENCES, APPARENT EASEMENTS, ROADWAYS AND VISIBLE ENCROACHMENTS, IF ANY, TO THE BEST OF MY KNOWLEDGE AND BELIEF.

THIS SURVEY IS MADE FOR THE USE OF THE PRESENT OWNERS OF THE PROPERTY, AND ALSO THOSE WHO PURCHASE, MORTGAGE, OR GUARANTEE THE TITLE THERETO WITHIN ONE (1) YEAR FROM DATE HEREON.

David F. Abell

DAVID F. ABELL
WISCONSIN REGISTERED LAND SURVEYOR, S-1596

September 10, 2003

DATE JOB NUMBER - 03142

NOTE: THIS IS NOT A CERTIFIED COPY UNLESS SEALED.

FSS-18

216-3690