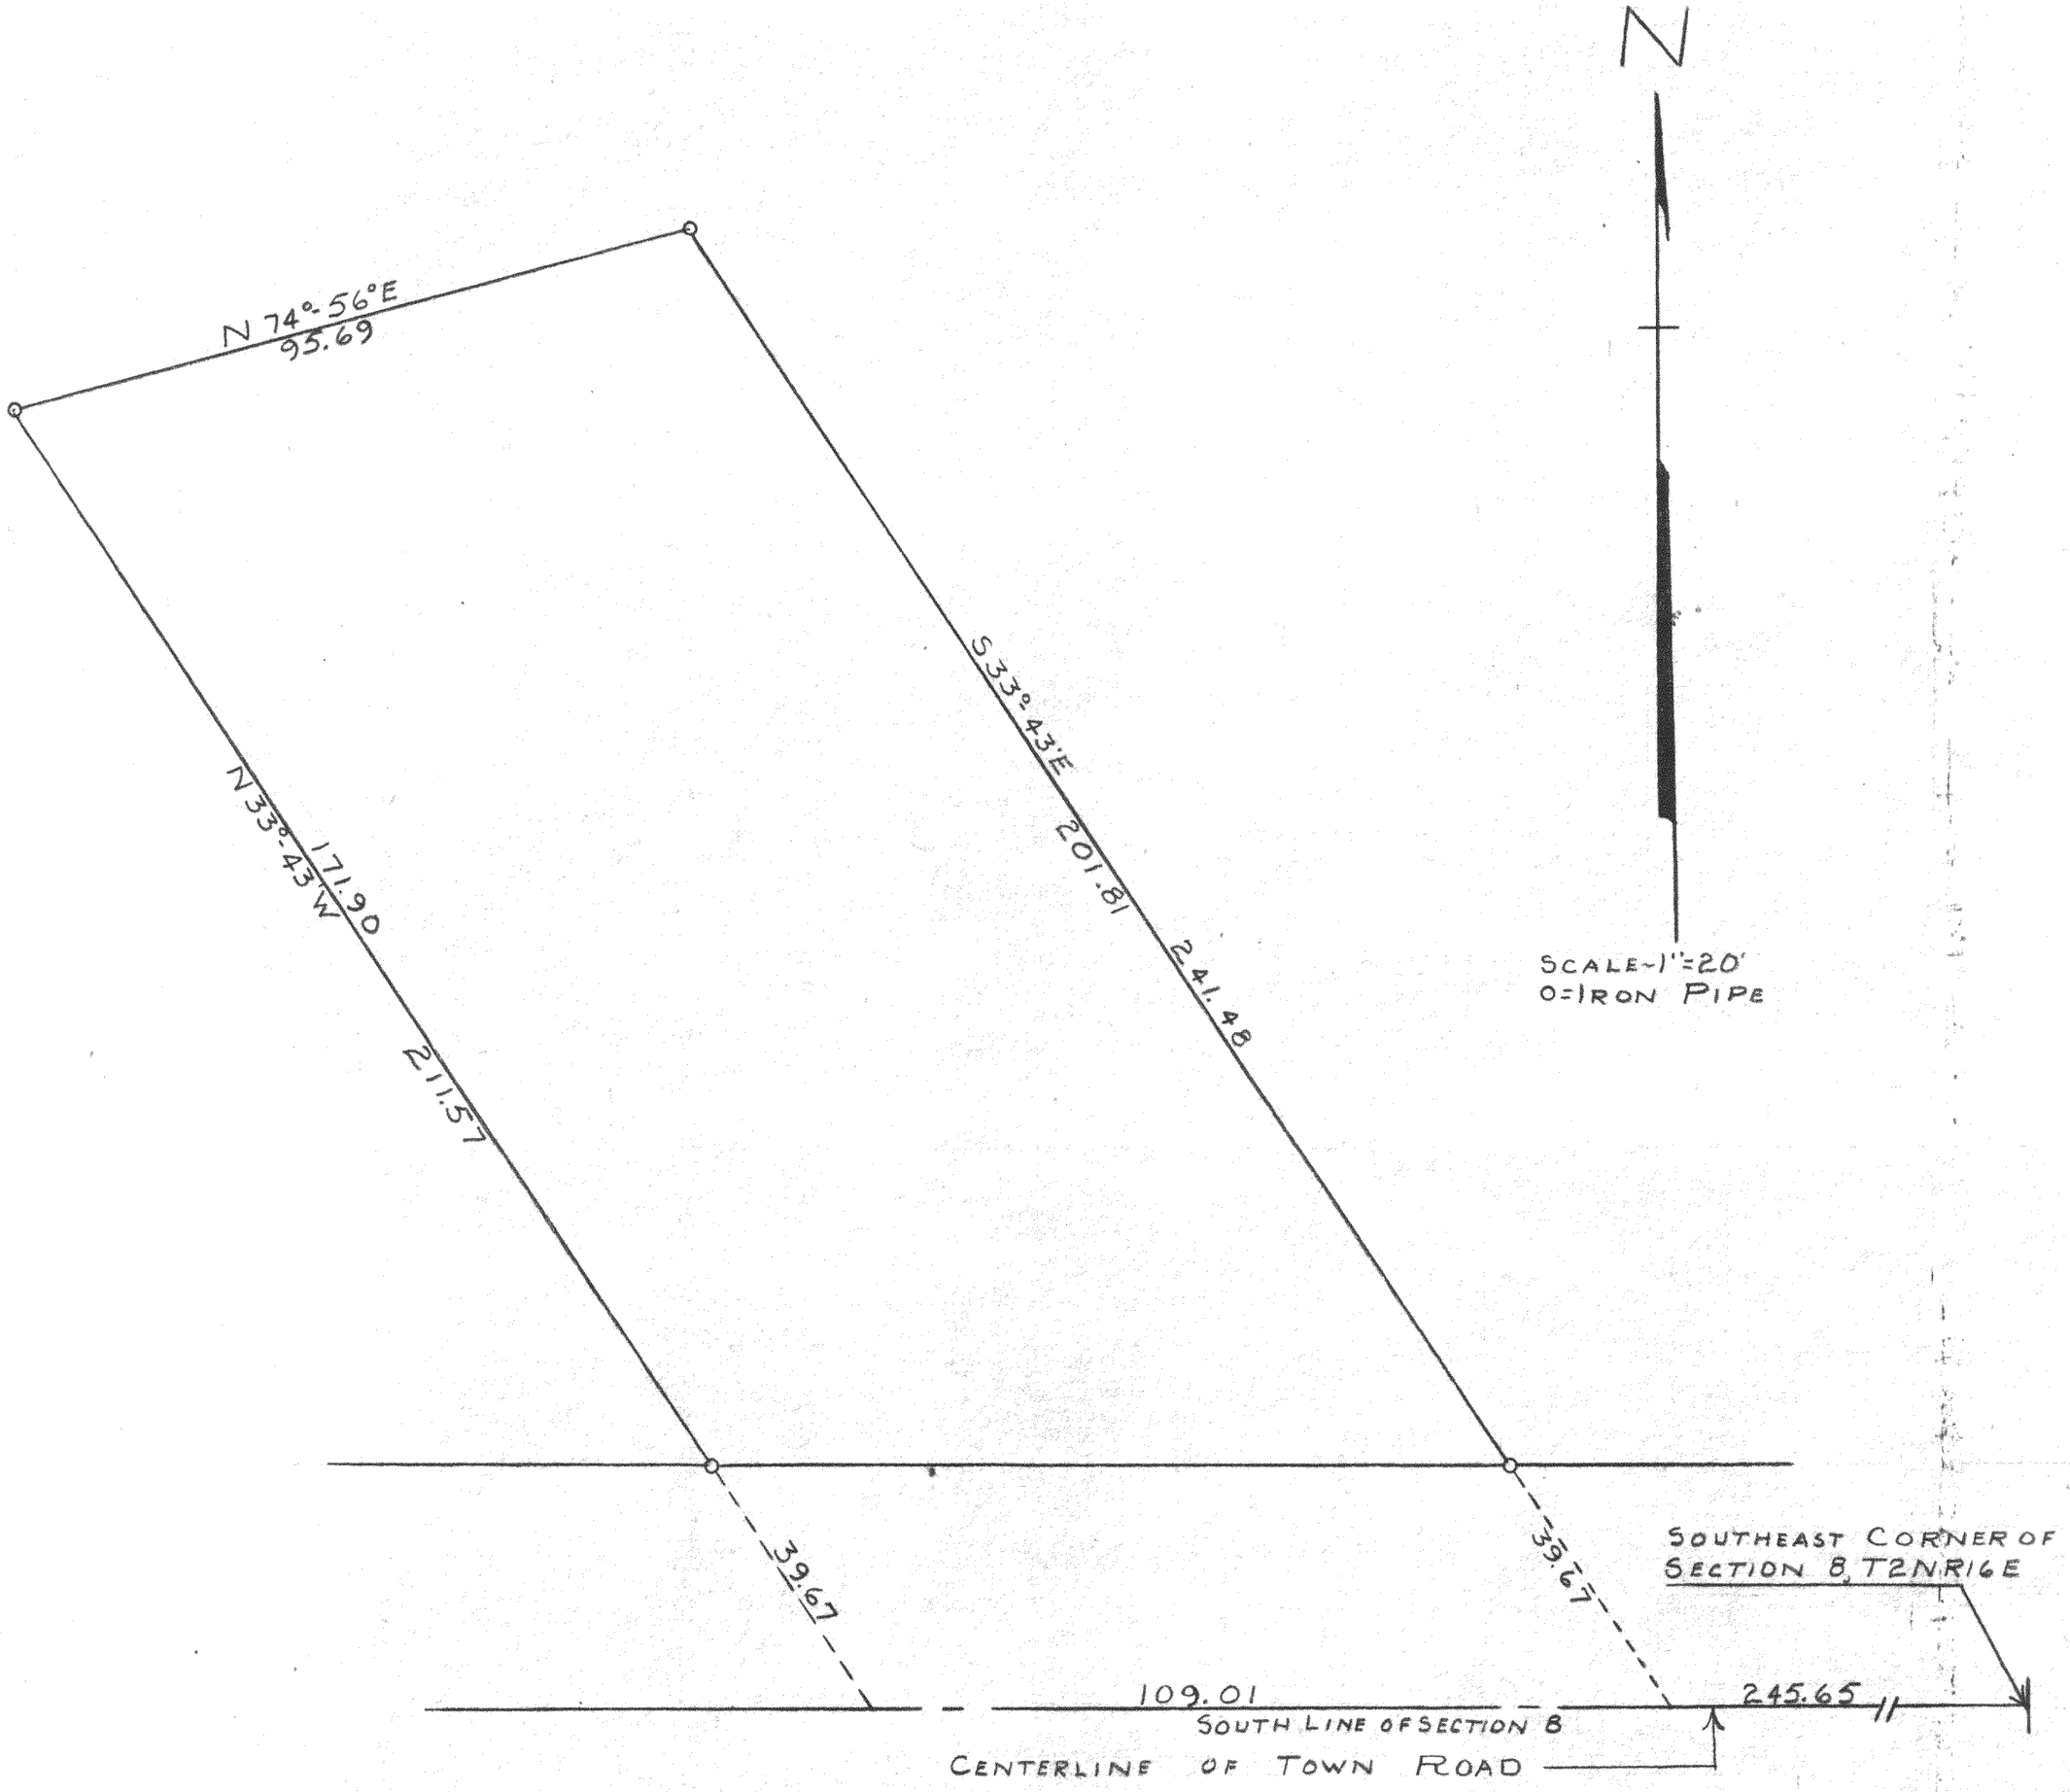


STATE OF WISCONSIN)
COUNTY OF WALWORTH) SS

I, GEORGE T. DUNHAM, DO HEREBY CERTIFY THAT I HAVE SURVEYED THE PROPERTY DESCRIBED AS FOLLOWS:

A PARCEL OF LAND LOCATED IN THE SE 1/4 OF SECTION 8, T2NR16E, WALWORTH COUNTY, WISCONSIN, DESCRIBED AS FOLLOWS, TO-WIT: BEGINNING AT A POINT ON THE SOUTH LINE OF SAID SECTION 8, LOCATED 245.65 WEST OF THE SE CORNER OF SAID SECTION; THENCE WEST ALONG SAID SECTION LINE 109.01 FEET TO A POINT; THENCE N33°-43'W 211.57 FEET TO A POINT; THENCE N74°-56'E 95.69 FEET TO A POINT; THENCE S33°-43'E 241.48 FEET TO THE PLACE OF BEGINNING.

AND THAT THE PLAT SHOWN ABOVE IS A CORRECT REPRESENTATION OF THE PROPERTY LINES AS IT WAS SURVEYED DEC. 2, 1953

APRIL 25, 1956

Part of D-8-15D

GEORGE T. DUNHAM, SURVEYOR
DELAVAN, WISCONSIN

216-38