


DUNHAM SURVEYING, S.C.
SURVEYING & SUBDIVIDING
DELAVER, WISCONSIN 53115

Owner: Margaret Nietfeldt
South Shore Drive

Bearings are referenced to the
northwesterly line of South
Shore Drive. Bearing used is
taken from the recorded plat.

Scale - 1" = 30'
○ = Iron Pipe Found
● = Concrete Monument
--- = Fence Line

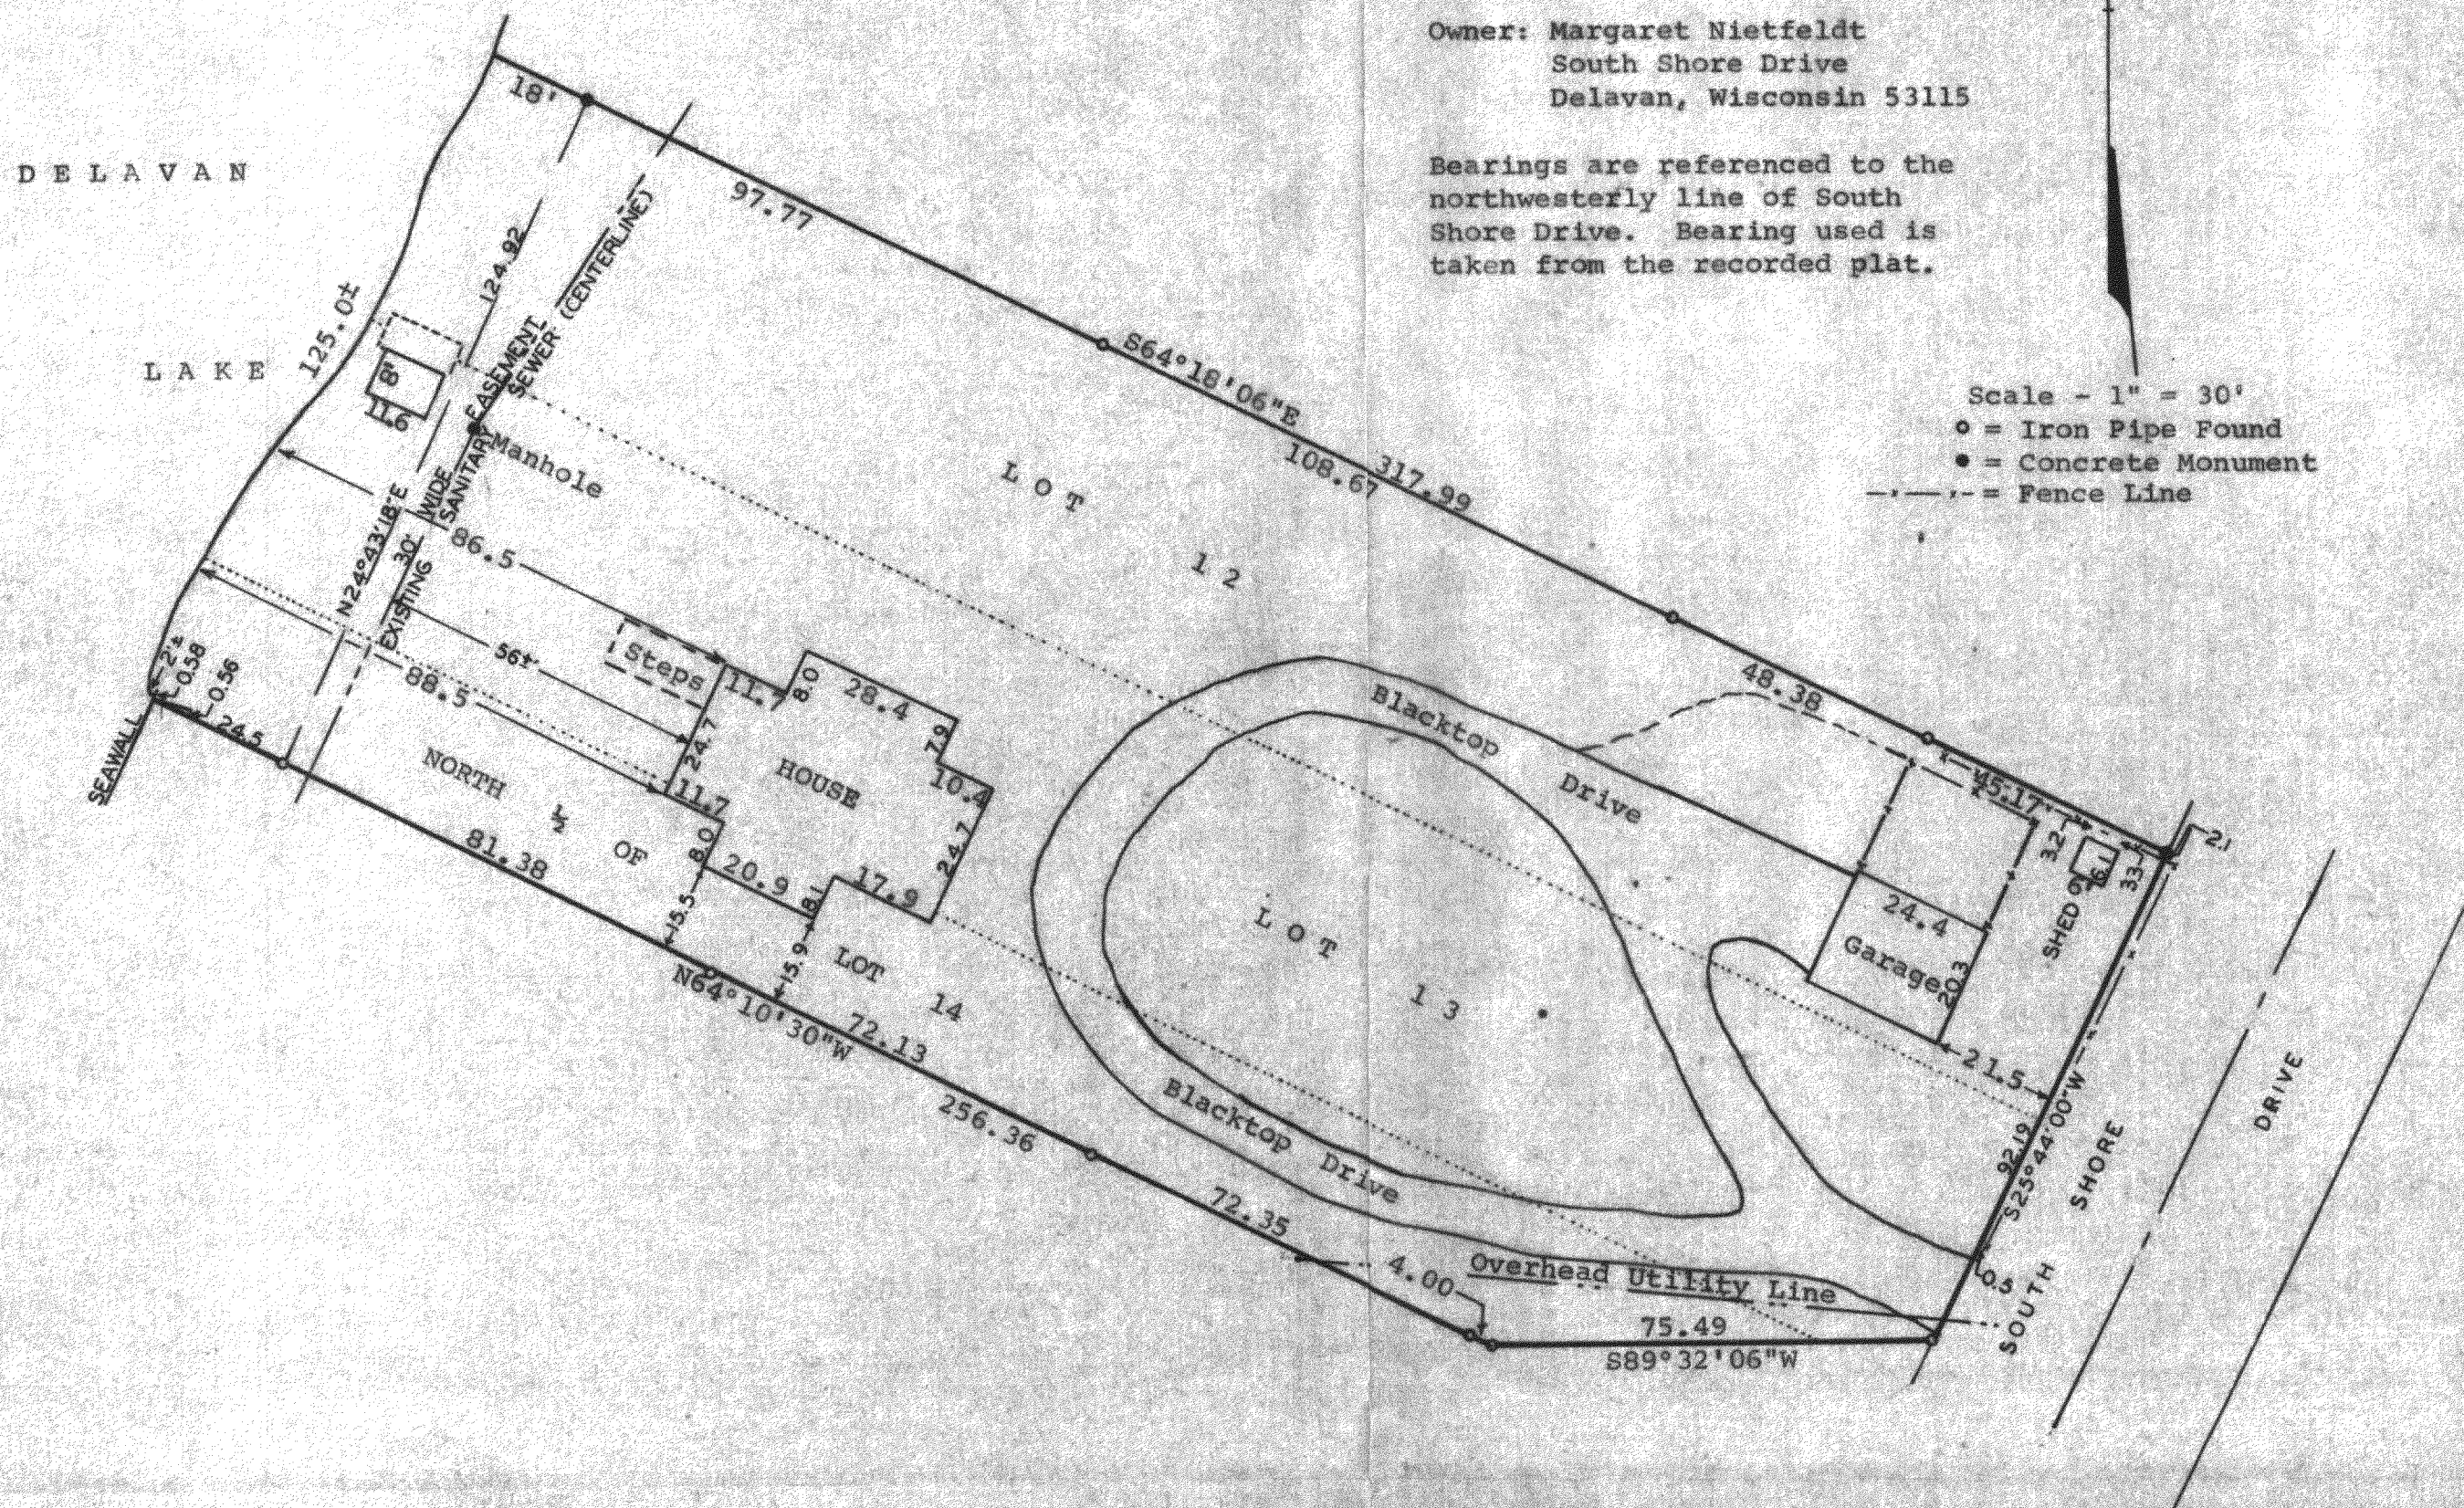

STATE OF WISCONSIN)
COUNTY OF WALWORTH) SS

I, James M. Dunham, Surveyor, certify that I have surveyed
the property described as follows,

Lots 12 and 13 and the northerly 1/2 of Lot 14 all in
Bailey's Subdivision, being a subdivision located in
fractional Section 27, T 2 N, R 16 E, Walworth County,
Wisconsin, subject to easements of record.

and that the above map is a true representation thereof and shows the
size and location of the property, its exterior boundaries, the location
of all visible structures and dimensions of all principal buildings
thereon, boundary fences, apparent easements, roadways and visible
encroachments, if any.

This survey is made for the use of the present owners of the property,
and also those who purchase, mortgage, or guarantee the title thereto
within one (1) year from date hereof.
October 18, 1982

James M. Dunham
James M. Dunham, Surveyor

