PLAT OF SURVEY OF

LOT 18 IN BLOCK 2 AND THE SOUTHERLY 1/2 OF LOT 17 IN BLOCK 2, BEING THAT PART OF LOT 17 PARALLELING LOT 18 AND MEASURED FROM A POINT ON EAST DRIVE EQUI-DISTANT FROM THE NORTHWEST AND SOUTHWEST CORNERS OF SAID LOT AND RUNNING TO THE CHANNEL TO A POINT EQUI-DISTANT BETWEEN THE NORTHEAST AND SOUTHEAST CORNERS OF SAID LOT IN BLOCK 2 IN SOUTH SHORE MANOR IN THE SOUTHEAST 1/4 OF SECTION 32, T2N, R16E, SAID PROPERTY BEING IN THE COUNTY OF WALWORTH AND STATE OF WISCONSIN.

ABELL
SURVEYING & MAPPING
1140 SEQUOIA STREET · DELAVAN, WISCONSIN 53115
262-728-6737

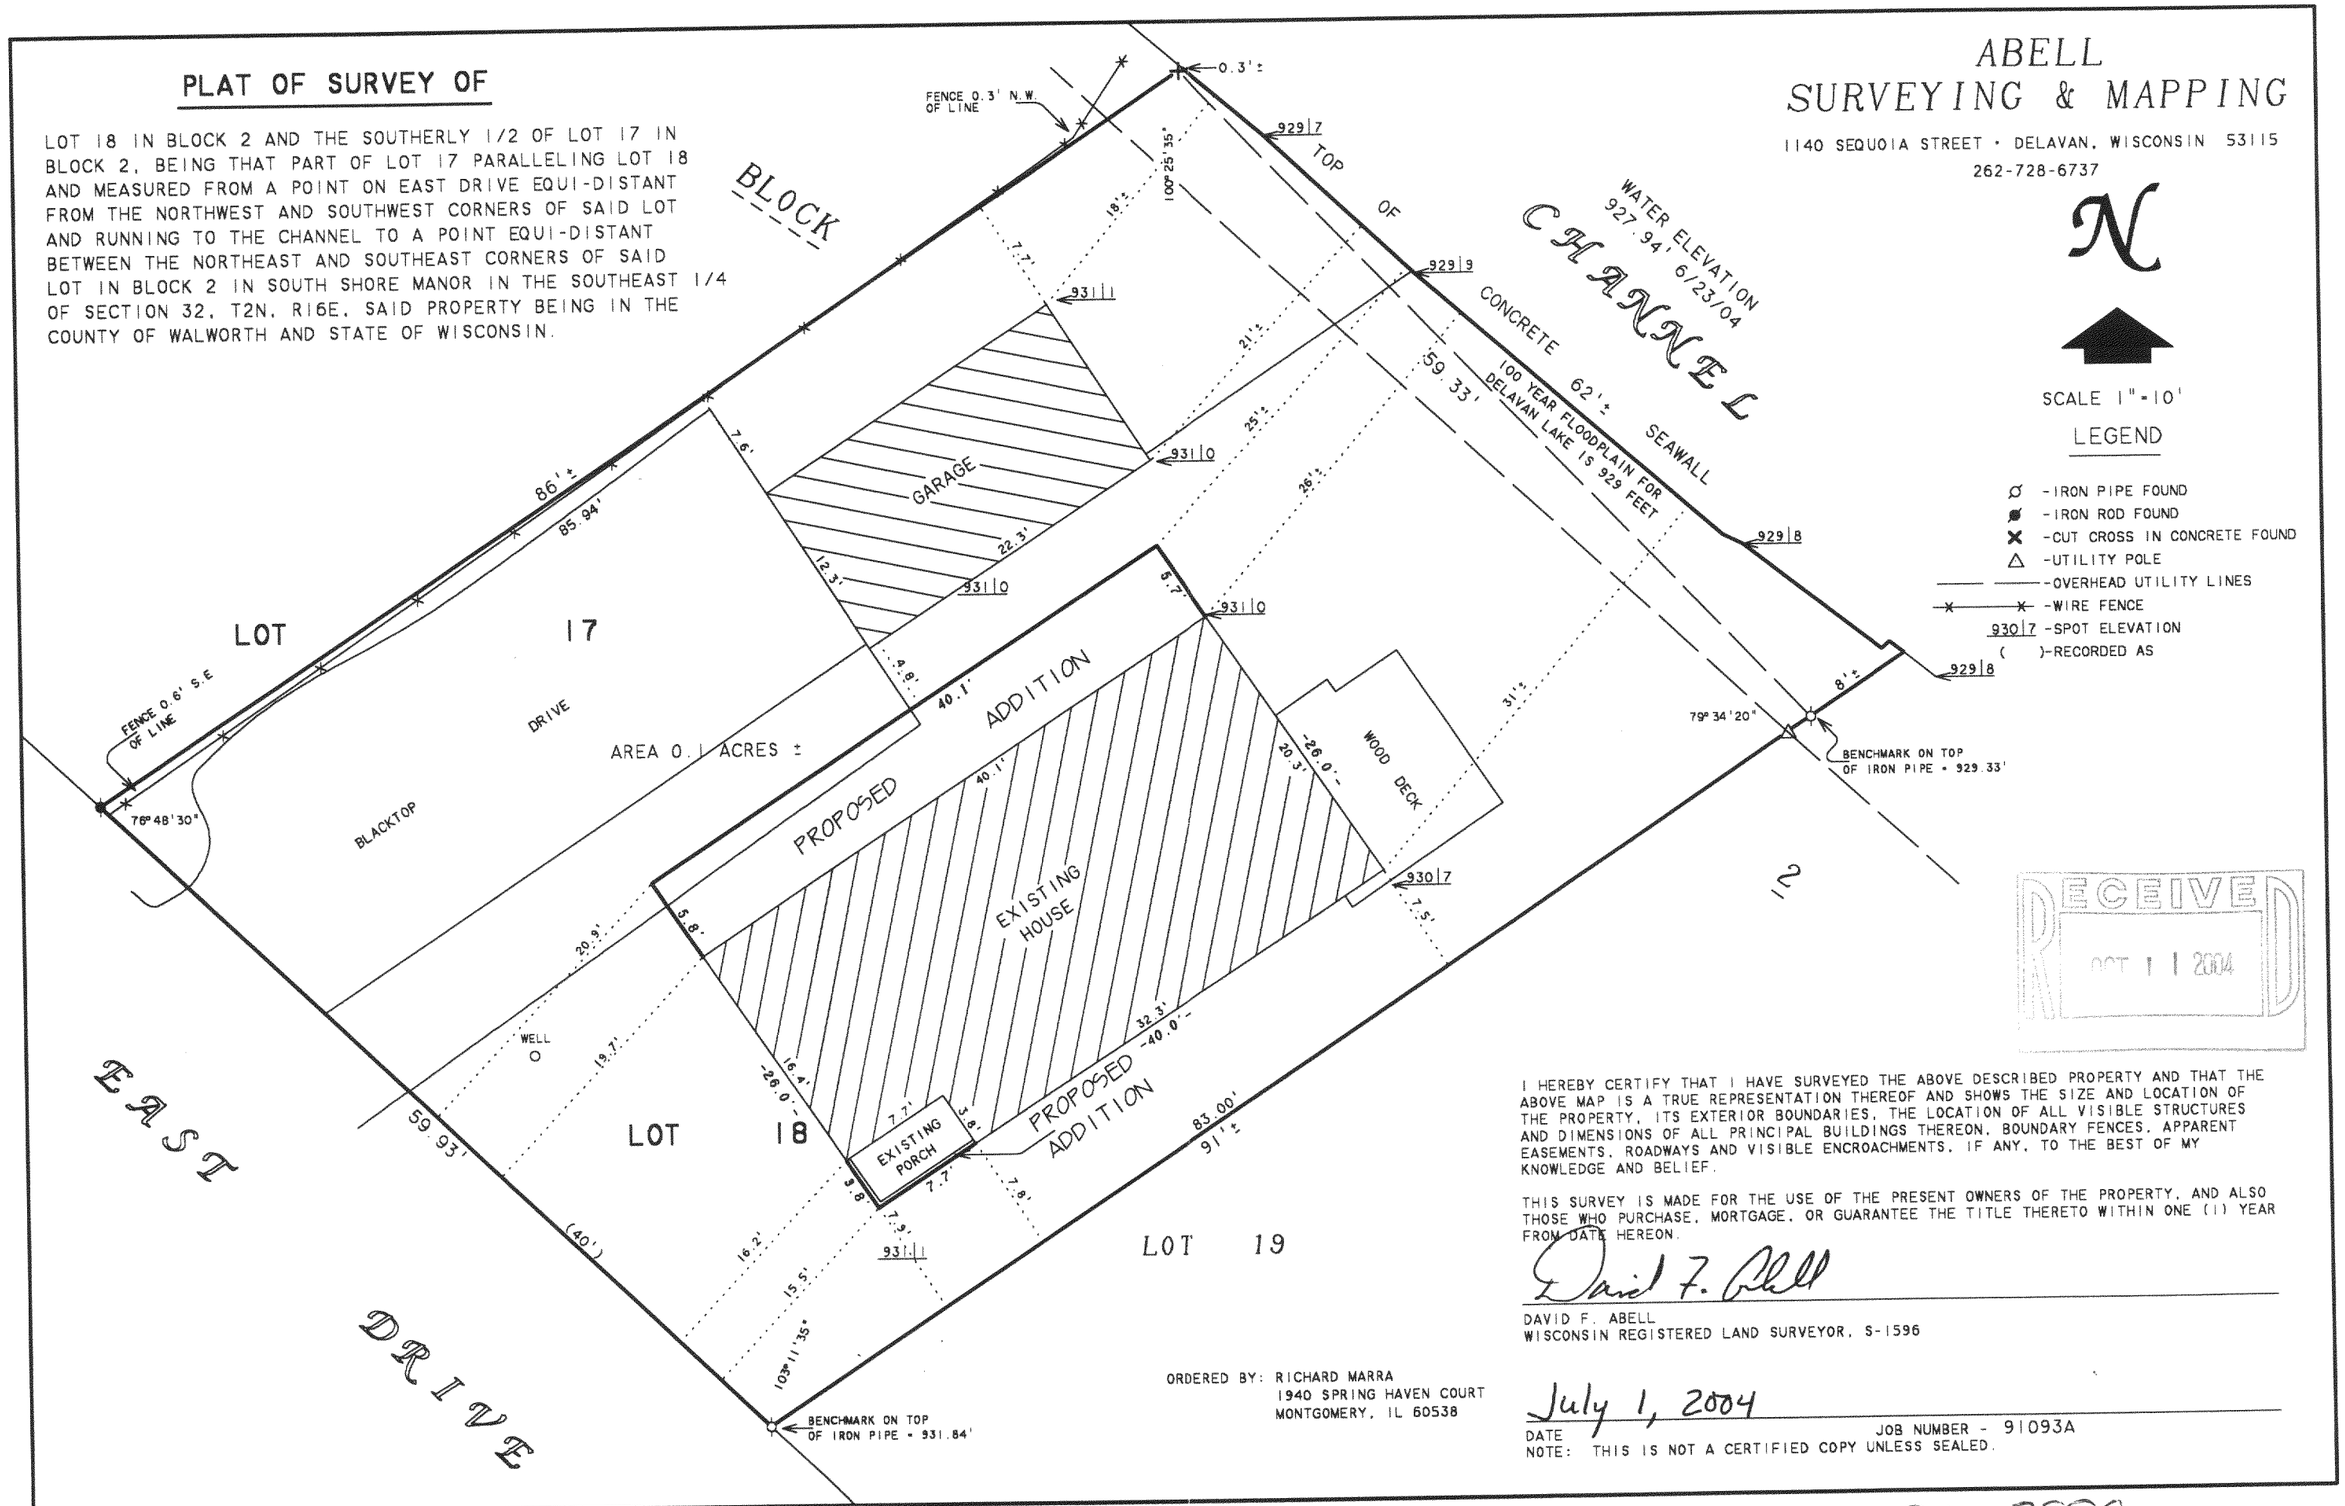

RECEIVED
OCT 11 2004

I HEREBY CERTIFY THAT I HAVE SURVEYED THE ABOVE DESCRIBED PROPERTY AND THAT THE ABOVE MAP IS A TRUE REPRESENTATION THEREOF AND SHOWS THE SIZE AND LOCATION OF THE PROPERTY, ITS EXTERIOR BOUNDARIES, THE LOCATION OF ALL VISIBLE STRUCTURES AND DIMENSIONS OF ALL PRINCIPAL BUILDINGS THEREON, BOUNDARY FENCES, APPARENT EASEMENTS, ROADWAYS AND VISIBLE ENCROACHMENTS, IF ANY, TO THE BEST OF MY KNOWLEDGE AND BELIEF.

THIS SURVEY IS MADE FOR THE USE OF THE PRESENT OWNERS OF THE PROPERTY, AND ALSO THOSE WHO PURCHASE, MORTGAGE, OR GUARANTEE THE TITLE THERETO WITHIN ONE (1) YEAR FROM DATE HEREON.

David F. Abell

DAVID F. ABELL
WISCONSIN REGISTERED LAND SURVEYOR, S-1596

ORDERED BY: RICHARD MARRA
1940 SPRING HAVEN COURT
MONTGOMERY, IL 60538

July 1, 2004
DATE

JOB NUMBER - 91093A

NOTE: THIS IS NOT A CERTIFIED COPY UNLESS SEALED.

FSS 00041

216-3859