ABELL
SURVEYING & MAPPING

1140 SEQUOIA STREET · DELAVAN, WISCONSIN 53115
262-728-6737

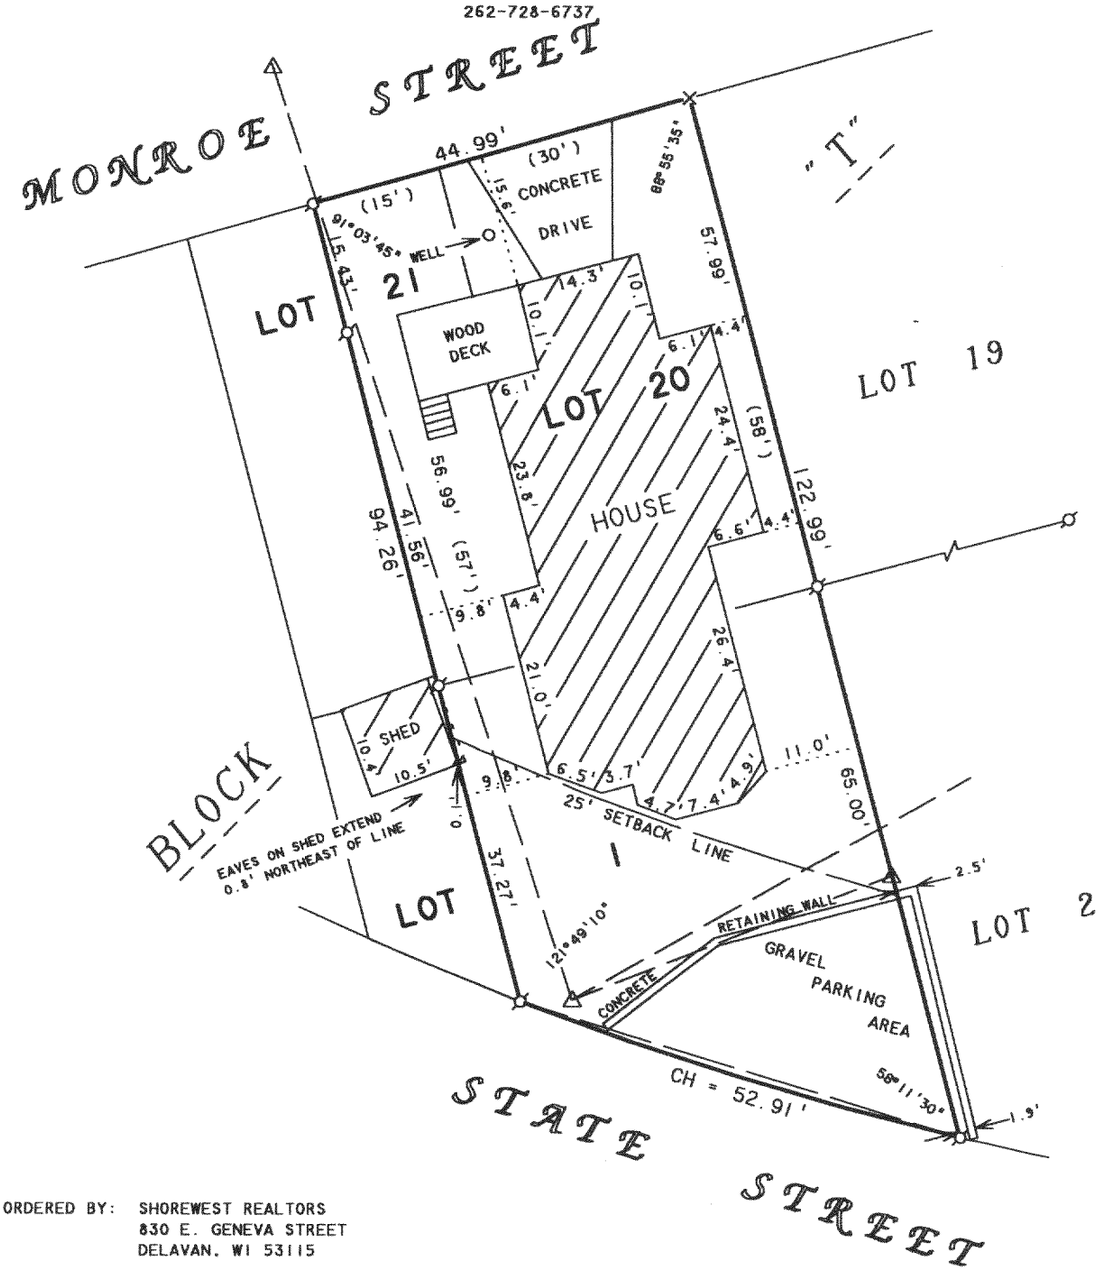

ORDERED BY: SHOREWEST REALTORS
830 E. GENEVA STREET
DELAVAN, WI 53115

PLAT OF SURVEY OF

LOT 20, EAST 1/2 OF LOT 21, EAST 45 FEET OF LOT 1, BLOCK "T" DELAVAN LAKE ASSEMBLY GROUNDS, LOCATED IN T2N, R16E, WALWORTH COUNTY, WISCONSIN, CONTAINING 0.11 ACRES.

N

SCALE 1"=20'

LEGEND

- ● -IRON ROD FOUND
- ○ -IRON PIPE FOUND
- × -CUTCROSS CONCRETE FOUND
- △ -UTILITY POLE
- ——— -OVERHEAD UTILITY LINES
- ( )-RECORDED AS

I HEREBY CERTIFY THAT I HAVE SURVEYED THE ABOVE DESCRIBED PROPERTY AND THAT THE ABOVE MAP IS A TRUE REPRESENTATION THEREOF AND SHOWS THE SIZE AND LOCATION OF THE PROPERTY, ITS EXTERIOR BOUNDARIES, THE LOCATION OF ALL VISIBLE STRUCTURES AND DIMENSIONS OF ALL PRINCIPAL BUILDINGS THEREON, BOUNDARY FENCES, APPARENT EASEMENTS, ROADWAYS AND VISIBLE ENCROACHMENTS, IF ANY, TO THE BEST OF MY KNOWLEDGE AND BELIEF.

THIS SURVEY IS MADE FOR THE USE OF THE PRESENT OWNERS OF THE PROPERTY, AND ALSO THOSE WHO PURCHASE, MORTGAGE, OR GUARANTEE THE TITLE THERETO WITHIN ONE (1) YEAR FROM DATE HEREON.

David F. Abell

DAVID F. ABELL
WISCONSIN REGISTERED LAND SURVEYOR, S-1596

May 11, 2005

DATE JOB NUMBER - 92146C

NOTE: THIS IS NOT A CERTIFIED COPY UNLESS SEALED.

RECEIVED JUL - 5 2005

FDLA 00205

216-3996