
ABELL
SURVEYING & MAPPING
1140 SEQUOIA STREET · DELAVAN, WISCONSIN 53115
262-728-6737

14

216-4013

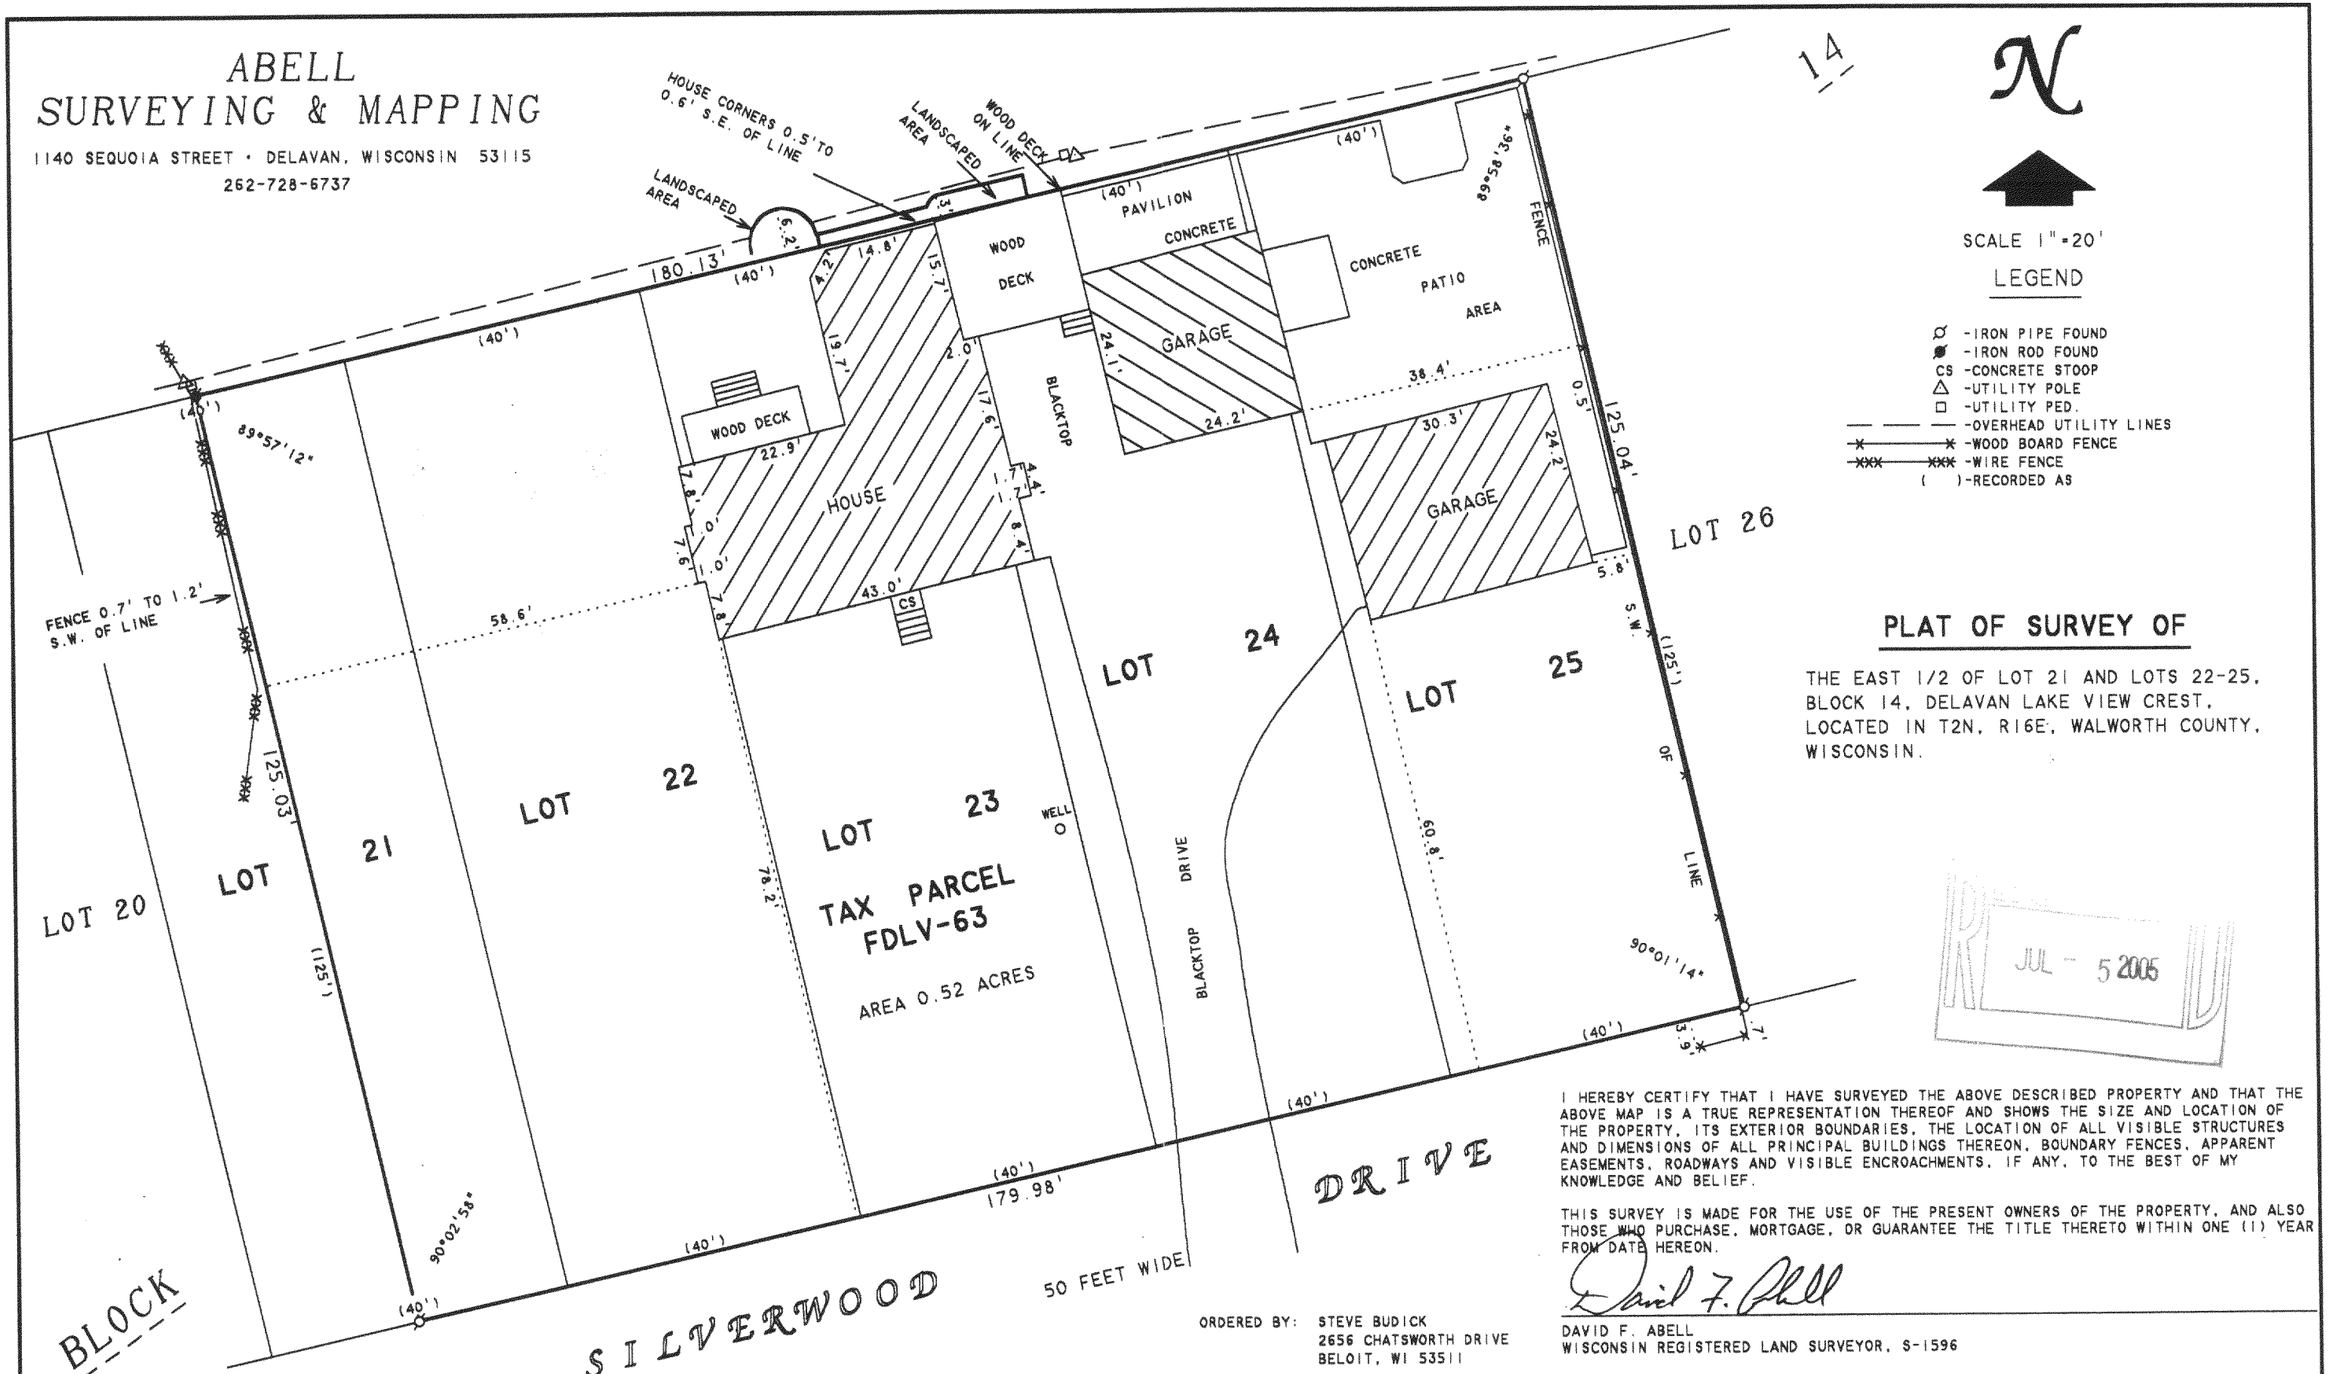

N

SCALE 1"=20'

LEGEND

- -IRON PIPE FOUND
- -IRON ROD FOUND
- CS -CONCRETE STOOP
- -UTILITY POLE
- -UTILITY PED.
- -OVERHEAD UTILITY LINES
- -WOOD BOARD FENCE
- -WIRE FENCE
- ( )-RECORDED AS

PLAT OF SURVEY OF

THE EAST 1/2 OF LOT 21 AND LOTS 22-25, BLOCK 14, DELAVAN LAKE VIEW CREST, LOCATED IN T2N, R16E, WALWORTH COUNTY, WISCONSIN.

RECEIVED
JUL - 5 2005

ORDERED BY: STEVE BUDICK
2656 CHATSWORTH DRIVE
BELOIT, WI 53511

I HEREBY CERTIFY THAT I HAVE SURVEYED THE ABOVE DESCRIBED PROPERTY AND THAT THE ABOVE MAP IS A TRUE REPRESENTATION THEREOF AND SHOWS THE SIZE AND LOCATION OF THE PROPERTY, ITS EXTERIOR BOUNDARIES, THE LOCATION OF ALL VISIBLE STRUCTURES AND DIMENSIONS OF ALL PRINCIPAL BUILDINGS THEREON, BOUNDARY FENCES, APPARENT EASEMENTS, ROADWAYS AND VISIBLE ENCROACHMENTS, IF ANY, TO THE BEST OF MY KNOWLEDGE AND BELIEF.

THIS SURVEY IS MADE FOR THE USE OF THE PRESENT OWNERS OF THE PROPERTY, AND ALSO THOSE WHO PURCHASE, MORTGAGE, OR GUARANTEE THE TITLE THERETO WITHIN ONE (1) YEAR FROM DATE HEREON.

David F. Abell

DAVID F. ABELL
WISCONSIN REGISTERED LAND SURVEYOR, S-1596

June 5, 2005

DATE JOB NUMBER - 91055C

NOTE: THIS IS NOT A CERTIFIED COPY UNLESS SEALED.

FDLV 0063