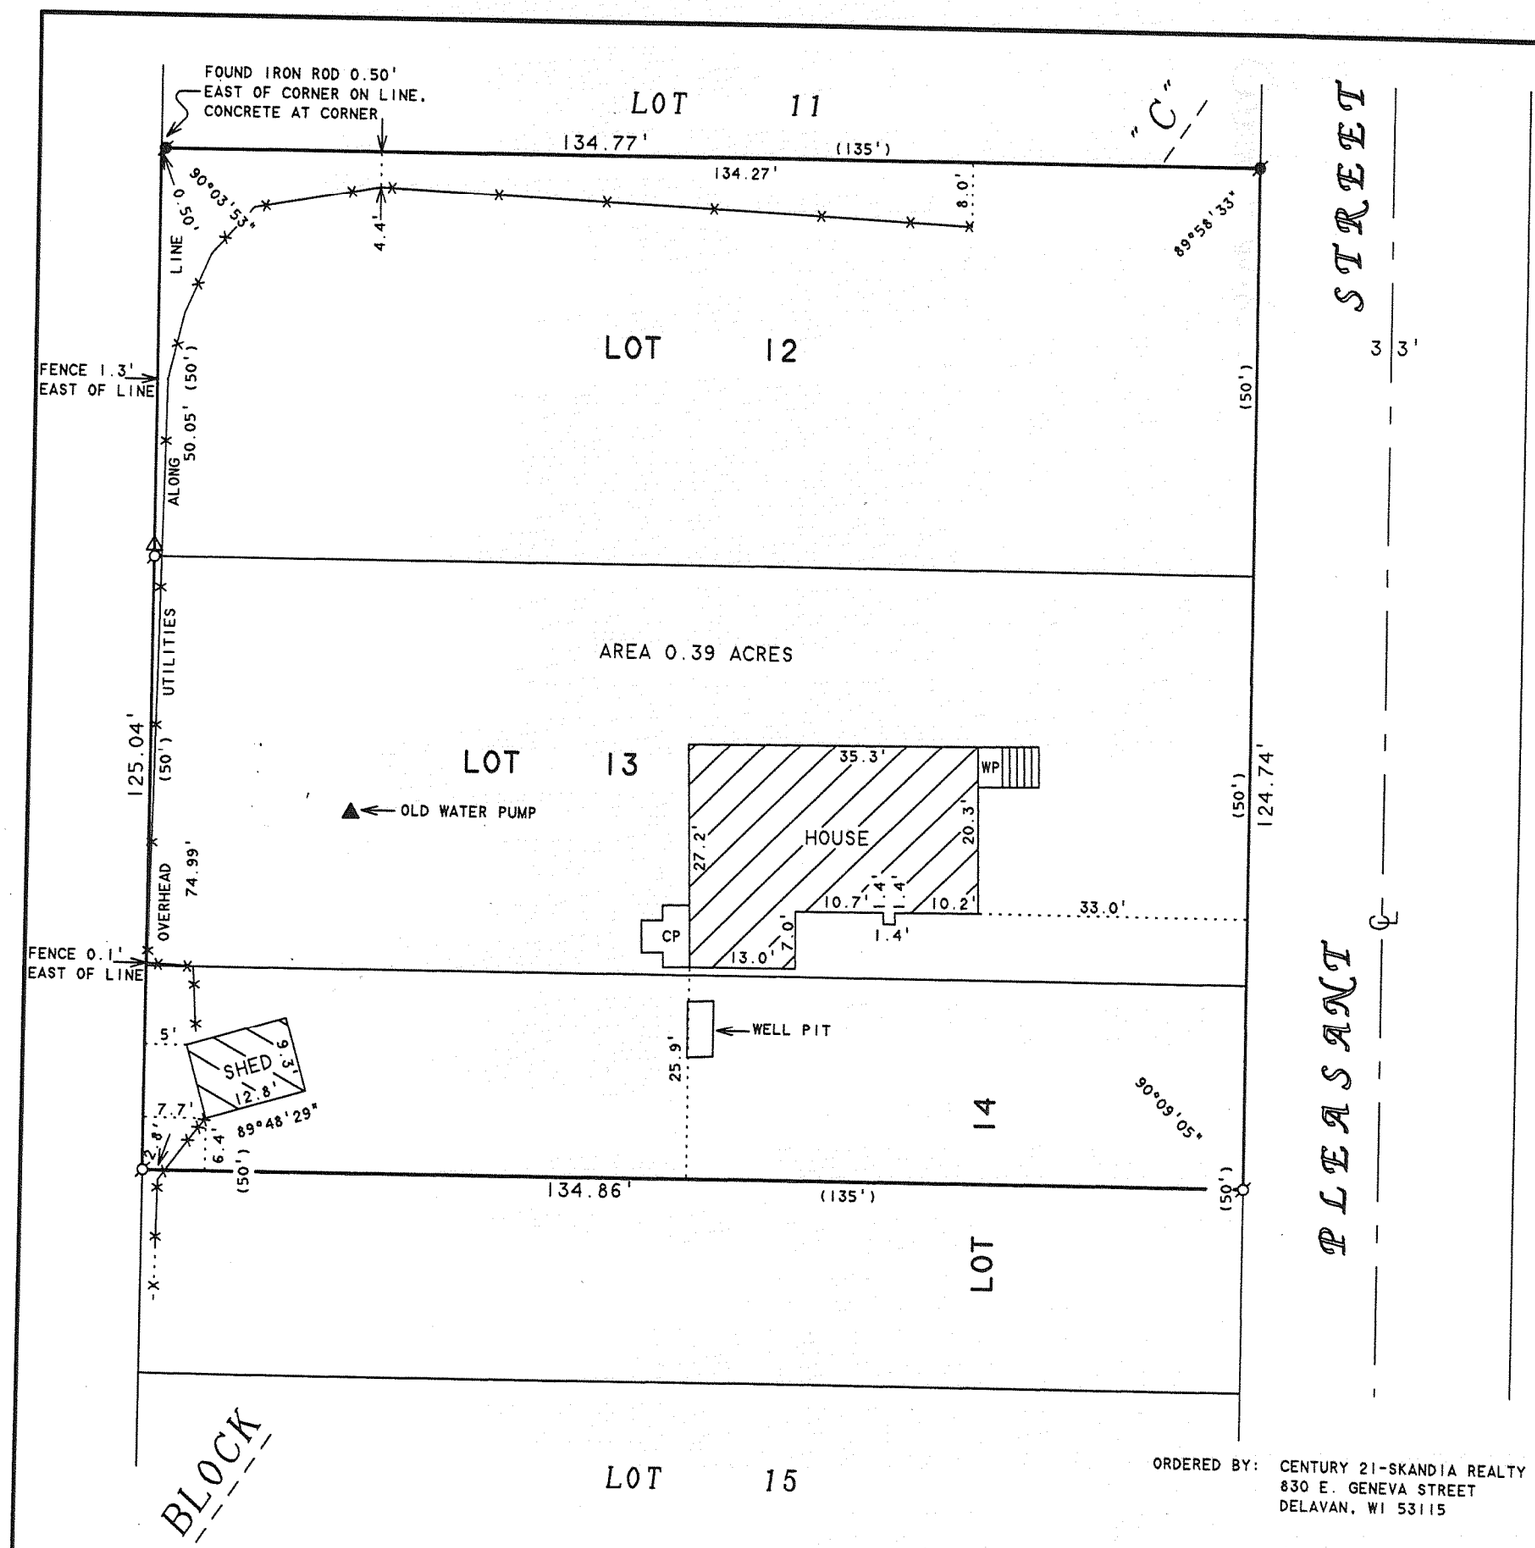

ORDERED BY: CENTURY 21-SKANDIA REALTY
830 E. GENEVA STREET
DELAVAN, WI 53115

ABELL SURVEYING & MAPPING

1140 SEQUOIA STREET • DELAVAN, WISCONSIN 53115
262-728-6737

RECEIVED
OCT 2 5 2006
BMF

N

SCALE 1"=20'

LEGEND

- -IRON PIPE FOUND
- -IRON ROD FOUND
- WP -WOOD PORCH
- CP -CONCRETE PORCH
- -CHAINLINK FENCE
- -WOOD BOARD FENCE
- -UTILITY POLE
- -OLD WATER PUMP
- ( )-RECORDED AS

PLAT OF SURVEY OF

LOTS 12 AND 13 AND THE NORTH 1/2 OF LOT 14, BLOCK "C", OF MAPLE HURST, LOCATED IN T2N, R16E, WALWORTH COUNTY, WISCONSIN.

REVISED AND RECERTIFIED: JUNE 8, 2006

ORDERED BY: KIM DENKEWALTER
DENKEWALTER & ANGELO
5215 OLD ORCHARD ROAD
SUITE 1010
SKOKIE, IL 60077

I HEREBY CERTIFY THAT I HAVE SURVEYED THE ABOVE DESCRIBED PROPERTY AND THAT THE ABOVE MAP IS A TRUE REPRESENTATION THEREOF AND SHOWS THE SIZE AND LOCATION OF THE PROPERTY, ITS EXTERIOR BOUNDARIES, THE LOCATION OF ALL VISIBLE STRUCTURES AND DIMENSIONS OF ALL PRINCIPAL BUILDINGS THEREON, BOUNDARY FENCES, APPARENT EASEMENTS, ROADWAYS AND VISIBLE ENCROACHMENTS, IF ANY, TO THE BEST OF MY KNOWLEDGE AND BELIEF.

THIS SURVEY IS MADE FOR THE USE OF THE PRESENT OWNERS OF THE PROPERTY, AND ALSO THOSE WHO PURCHASE, MORTGAGE, OR GUARANTEE THE TITLE THERETO WITHIN ONE (1) YEAR FROM DATE HEREON.

David F. Abell

DAVID F. ABELL
WISCONSIN REGISTERED LAND SURVEYOR, S-1596

August 25, 2004
DATE

JOB NUMBER - 04101A

NOTE: THIS IS NOT A CERTIFIED COPY UNLESS SEALED.

FMH-23 FMH-23A

216-4260