
ABELL
SURVEYING & MAPPING

1140 SEQUOIA STREET • DELAVAN, WISCONSIN 53115
262-728-6737

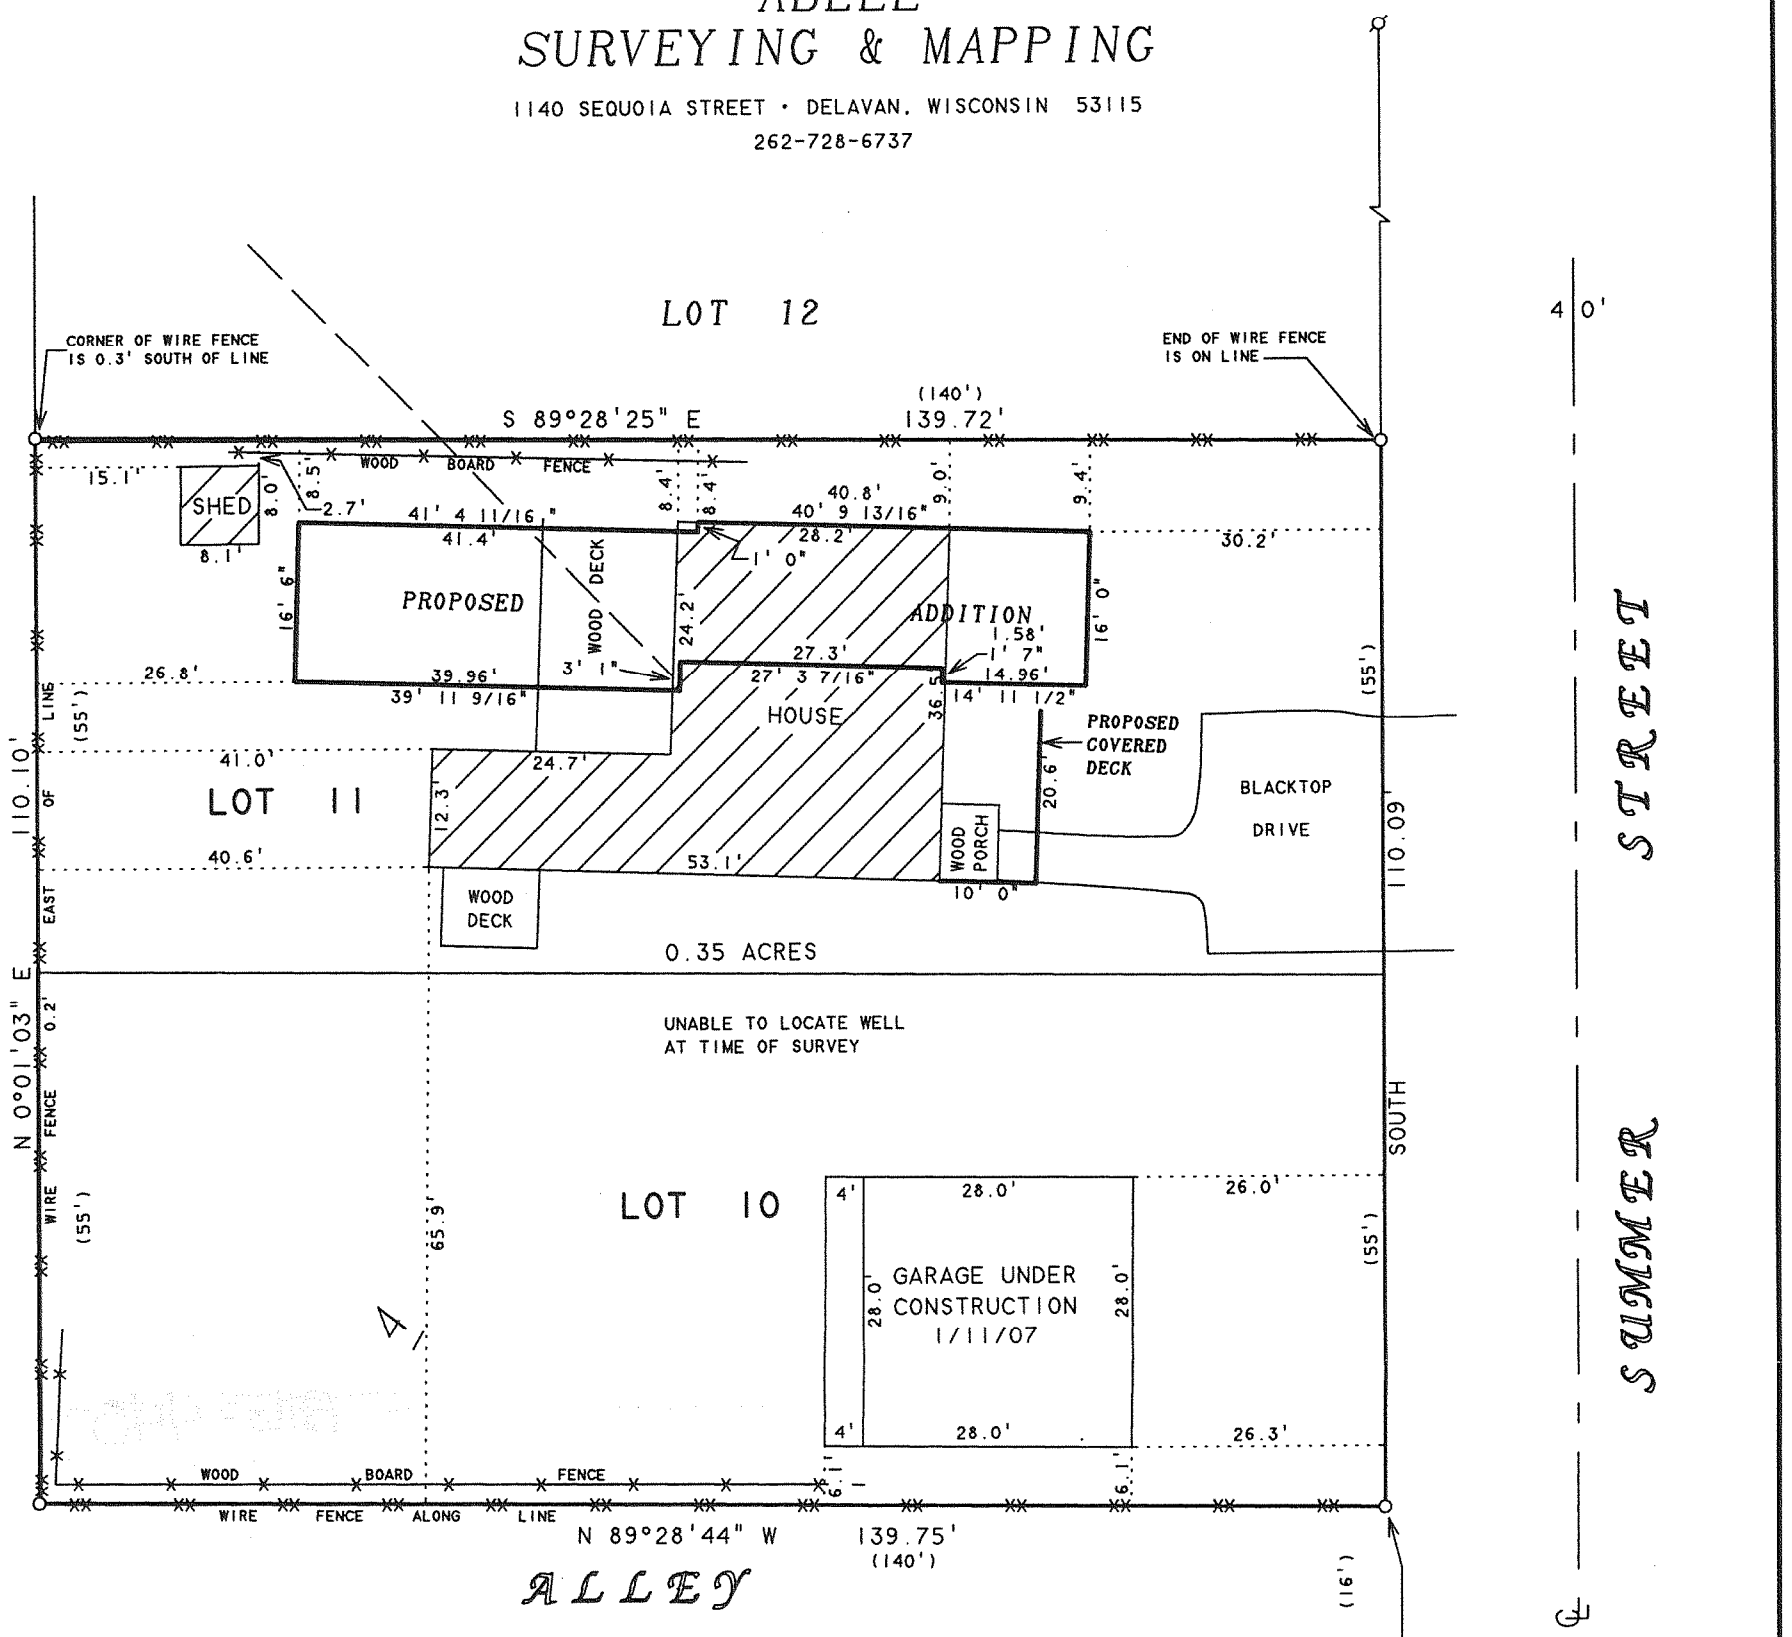

BLOCK 4

PLAT OF SURVEY OF

LOTS 10 AND 11, BLOCK 4, INLET OAKS SUBDIVISION NO. 4, LOCATED IN T2N, R16E, WALWORTH COUNTY, WISCONSIN.

NOTE: THE BEARING ON THE WEST LINE OF SUMMER STREET IS ASSUMED NORTH-SOUTH

N

SCALE 1"=20'

LEGEND

- ⌀ - IRON PIPE FOUND
- O - IRON PIPE SET
- -X-X- - WOOD BOARD FENCE
- -XX-XX- - WIRE FENCE
- ——— ——— ——— - OVERHEAD UTILITY LINES
- ( ) - RECORDED AS

ORDERED BY: GAIL CHIDESTER
313 SUMMER STREET
DELAVAN, WI 53115

REVISED: MAY 15, 2006 TO SHOW THE PROPOSED GARAGE, ADDITIONS AND PORCH.

REVISED: NOVEMBER 27, 2006 TO SHOW THE NEW PROPOSED GARAGE.
REVISED: JANUARY 11, 2007 TO SHOW THE GARAGE UNDER CONSTRUCTION
REVISED: APRIL 25, 2007 TO SHOW THE NEW PROPOSED ADDITION

ORDERED BY: BOSS CONSTRUCTION
8990 PINKS LANE
DARIEN, WI 53114

RECEIVED
OCT 30 2007

I HEREBY CERTIFY THAT I HAVE SURVEYED THE ABOVE DESCRIBED PROPERTY AND THAT THE ABOVE MAP IS A TRUE REPRESENTATION THEREOF AND SHOWS THE SIZE AND LOCATION OF THE PROPERTY, ITS EXTERIOR BOUNDARIES, THE LOCATION OF ALL VISIBLE STRUCTURES AND DIMENSIONS OF ALL PRINCIPAL BUILDINGS THEREON, BOUNDARY FENCES, APPARENT EASEMENTS, ROADWAYS AND VISIBLE ENCROACHMENTS, IF ANY, TO THE BEST OF MY KNOWLEDGE AND BELIEF.

THIS SURVEY IS MADE FOR THE USE OF THE PRESENT OWNERS OF THE PROPERTY, AND ALSO THOSE WHO PURCHASE, MORTGAGE, OR GUARANTEE THE TITLE THERETO WITHIN ONE (1) YEAR FROM DATE HEREON.

David F. Abell

DAVID F. ABELL
WISCONSIN REGISTERED LAND SURVEYOR, S-1596

May 5, 2006

DATE JOB NUMBER - 06043D

NOTE: THIS IS NOT A CERTIFIED COPY UNLESS SEALED.

FIN4-29

216-4457