

DUNHAM SURVEYING, S.C.

SURVEYING & SUBDIVIDING

DELAVAN, WISCONSIN 53115

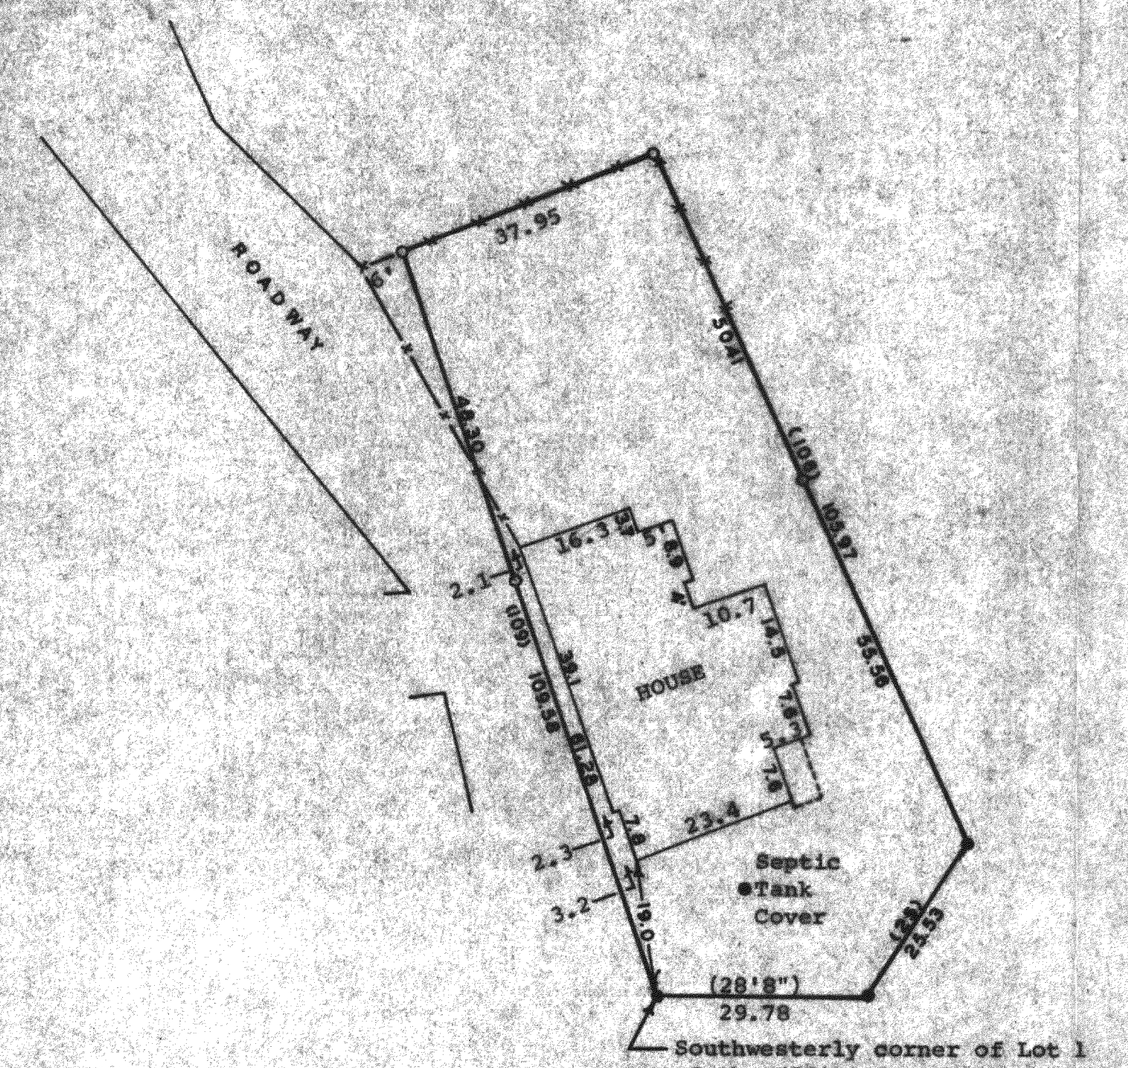

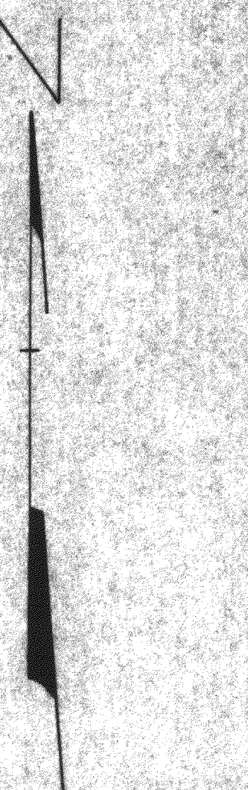

Scale - 1" = 20'
o = Iron Pipe Found
● = Concrete Monument
→x——x← = Fence line
(0.00) = recorded distance

STATE OF WISCONSIN)
COUNTY OF WALWORTH) SS

I, George T. Dunham, Surveyor, certify that I have surveyed the property described as follows,

A part of Lot 1 of the Addition to Willow Point Park located in Section 29, T 2 N, R 16 E, Walworth County, Wisconsin, described as follows: Beginning at a point on the Westerly line of said lot, which point is 109.58 feet (recorded as 109 feet) northwesterly of the southwesterly corner of said lot; thence Southeasterly along the Westerly line of said lot 109.58 feet to the southwesterly corner thereof; thence Easterly 29.78 feet, along the southerly line of said lot to a concrete monument; thence northeasterly 25.53 feet (recorded as 25 feet) to a concrete monument at the southeasterly corner of said Lot 1; thence Northwesterly along the Easterly line of said lot 105.97 (recorded as 106 feet) to a point; thence westerly 37.95 feet to the place of beginning.

and the above map is a true representation thereof and shows the size and location of the property, its exterior boundaries, the location and dimensions of all structures thereon, fences, apparent easements and roadways and visible encroachments, if any.

This survey is made for the exclusive use of the present owners of the property, and also those who purchase, mortgage, or guarantee the title thereto within one (1) year from date hereof; and as to them I warrant the accuracy of said survey and map.

September 13, 1978

George T. Dunham, Surveyor

WISCONSIN
GEORGE T. DUNHAM
DELAVAN, WIS.
LAND SURVEYOR

FWIA-1

H & E 10-9155 250-9-76

FWIA-1

216-448