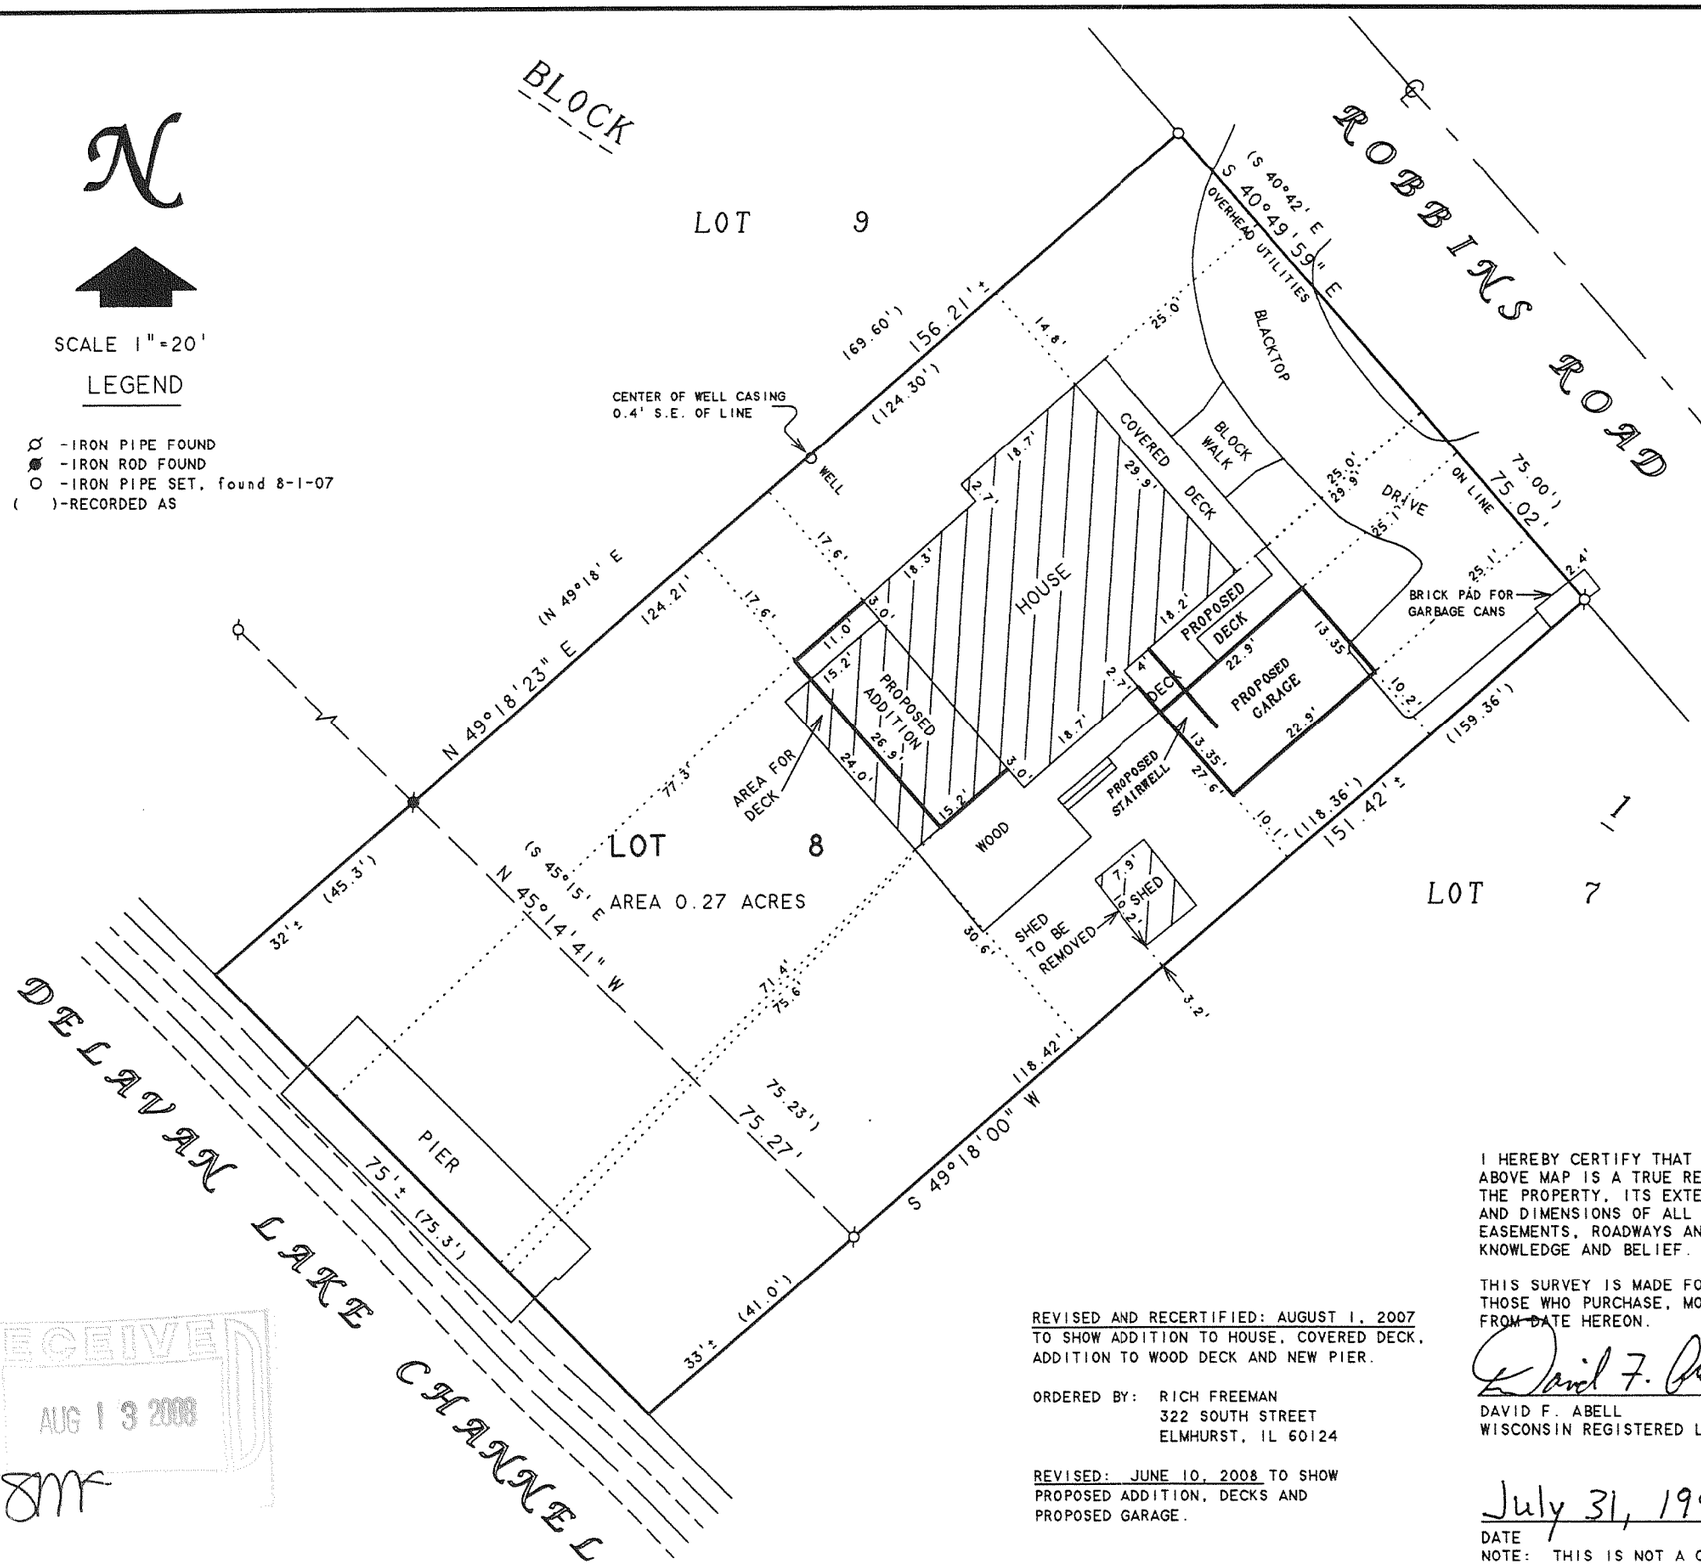


ABELL
SURVEYING & MAPPING
1140 SEQUOIA STREET • DELAVAN, WISCONSIN 53115
262-728-6737

NOTE: BEARINGS ARE REFERENCED TO THE RECORDED SUBDIVISION PLAT.

PLAT OF SURVEY OF

LOT 8, BLOCK 1, SUNNY DELL SUBDIVISION, LOCATED IN T2N, R16E, TOWN OF DELAVAN, WALWORTH COUNTY, WISCONSIN.

REVISED AND RECERTIFIED: AUGUST 1, 2007 TO SHOW ADDITION TO HOUSE, COVERED DECK, ADDITION TO WOOD DECK AND NEW PIER.

ORDERED BY: RICH FREEMAN
322 SOUTH STREET
ELMHURST, IL 60124

REVISED: JUNE 10, 2008 TO SHOW PROPOSED ADDITION, DECKS AND PROPOSED GARAGE.

I HEREBY CERTIFY THAT I HAVE SURVEYED THE ABOVE DESCRIBED PROPERTY AND THAT THE ABOVE MAP IS A TRUE REPRESENTATION THEREOF AND SHOWS THE SIZE AND LOCATION OF THE PROPERTY, ITS EXTERIOR BOUNDARIES, THE LOCATION OF ALL VISIBLE STRUCTURES AND DIMENSIONS OF ALL PRINCIPAL BUILDINGS THEREON, BOUNDARY FENCES, APPARENT EASEMENTS, ROADWAYS AND VISIBLE ENCROACHMENTS, IF ANY, TO THE BEST OF MY KNOWLEDGE AND BELIEF.

THIS SURVEY IS MADE FOR THE USE OF THE PRESENT OWNERS OF THE PROPERTY, AND ALSO THOSE WHO PURCHASE, MORTGAGE, OR GUARANTEE THE TITLE THERETO WITHIN ONE (1) YEAR FROM DATE HEREON.

David F. Abell

DAVID F. ABELL
WISCONSIN REGISTERED LAND SURVEYOR, S-1596

July 31, 1997
DATE

JOB NUMBER - 97145C

NOTE: THIS IS NOT A CERTIFIED COPY UNLESS SEALED.

RECEIVED
AUG 13 2008

FSU-8

216-4561