LAND-MARK SURVEYING
Mark L. Miritz
Wisconsin Registered Land Surveyor S-2582


N9330 Knuteson Drive
Whitewater, WI 53190
Phone:(262)495-3284
FAX : (262) 495-8421
LAND-MARKSURVEYING.COM

PLAT OF SURVEY

LOT 33, BLOCK 1, SOUTH SHORE MANOR SUBDIVISION, LOCATED IN SECTION 32, TOWN 2 NORTH, RANGE 16 EAST, DELAVAN TOWNSHIP, WALWORTH COUNTY, WISCONSIN.

OWNER: THE KAREN FERRARD REVOCABLE TRUST, DATED MARCH 13,1995
KAREN FERRARD- TRUSTEE

NOTE:
AN AGREEMENT BETWEEN KAREN FERRARD & LAND-MARK SURVEYING WAS MADE TO LIMIT THE SURVEY WORK TO THE BOUNDARY ONLY.

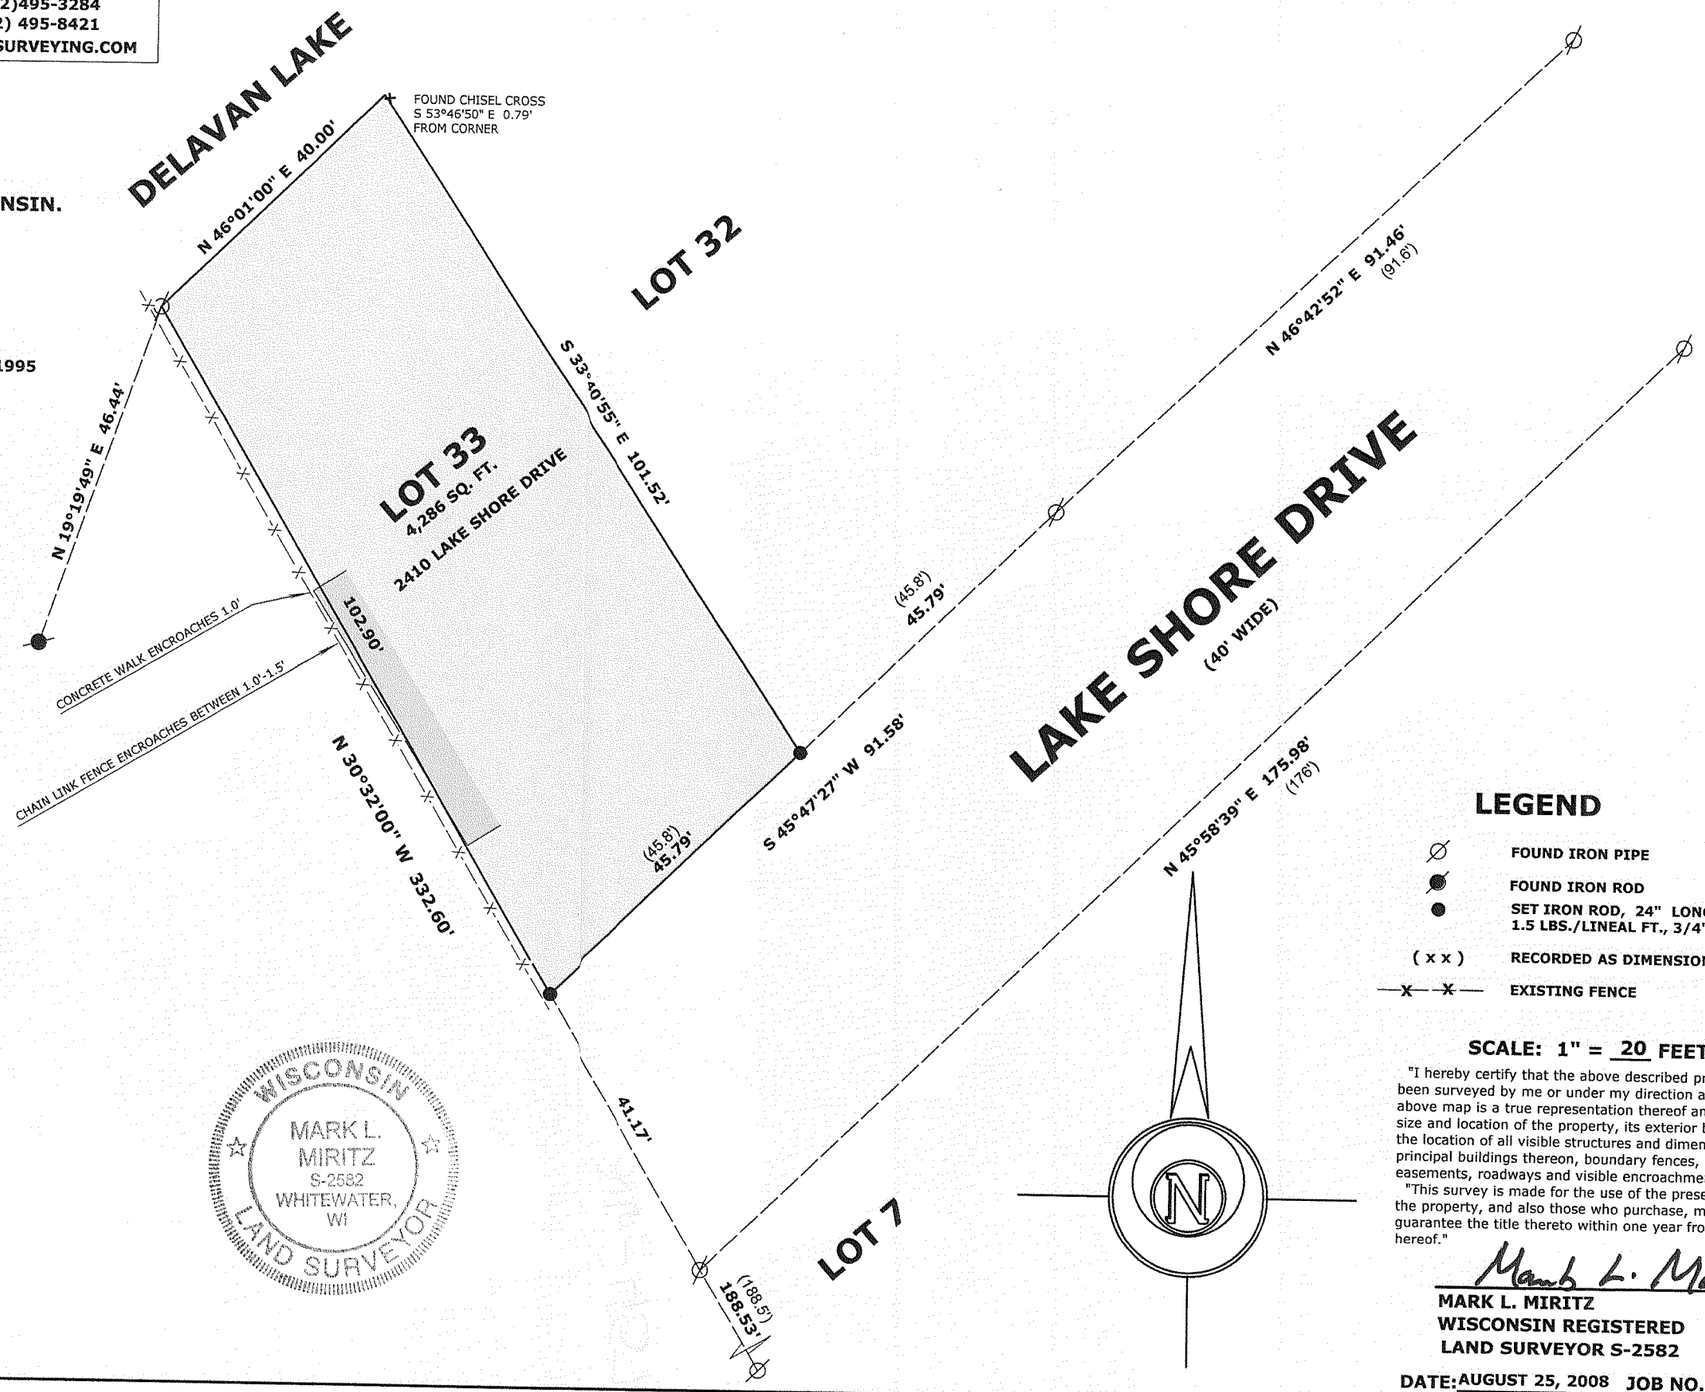

LEGEND

- ⌀ — FOUND IRON PIPE
- ⌀ — FOUND IRON ROD
- ● — SET IRON ROD, 24" LONG, WEIGHING 1.5 LBS./LINEAL FT., 3/4" DIA.
- (x x) — RECORDED AS DIMENSION
- —x—x— — EXISTING FENCE

SCALE: 1" = 20 FEET

"I hereby certify that the above described property has been surveyed by me or under my direction and that the above map is a true representation thereof and shows the size and location of the property, its exterior boundaries, the location of all visible structures and dimensions of all principal buildings thereon, boundary fences, apparent easements, roadways and visible encroachments, if any."

"This survey is made for the use of the present owners of the property, and also those who purchase, mortgage, or guarantee the title thereto within one year from date hereof."

Mark L. Miritz

MARK L. MIRITZ
WISCONSIN REGISTERED
LAND SURVEYOR S-2582

DATE: AUGUST 25, 2008 JOB NO. 08.811

WISCONSIN
MARK L. MIRITZ
S-2582
WHITEWATER, WI
LAND SURVEYOR

RECEIVED
SEP 25 2008

FSS-27

216-4577