ABELL
SURVEYING & MAPPING

1140 SEQUOIA STREET · DELAVAN, WISCONSIN 53115
262-728-6737

RECEIVED
DEC - 8 2008
SMK

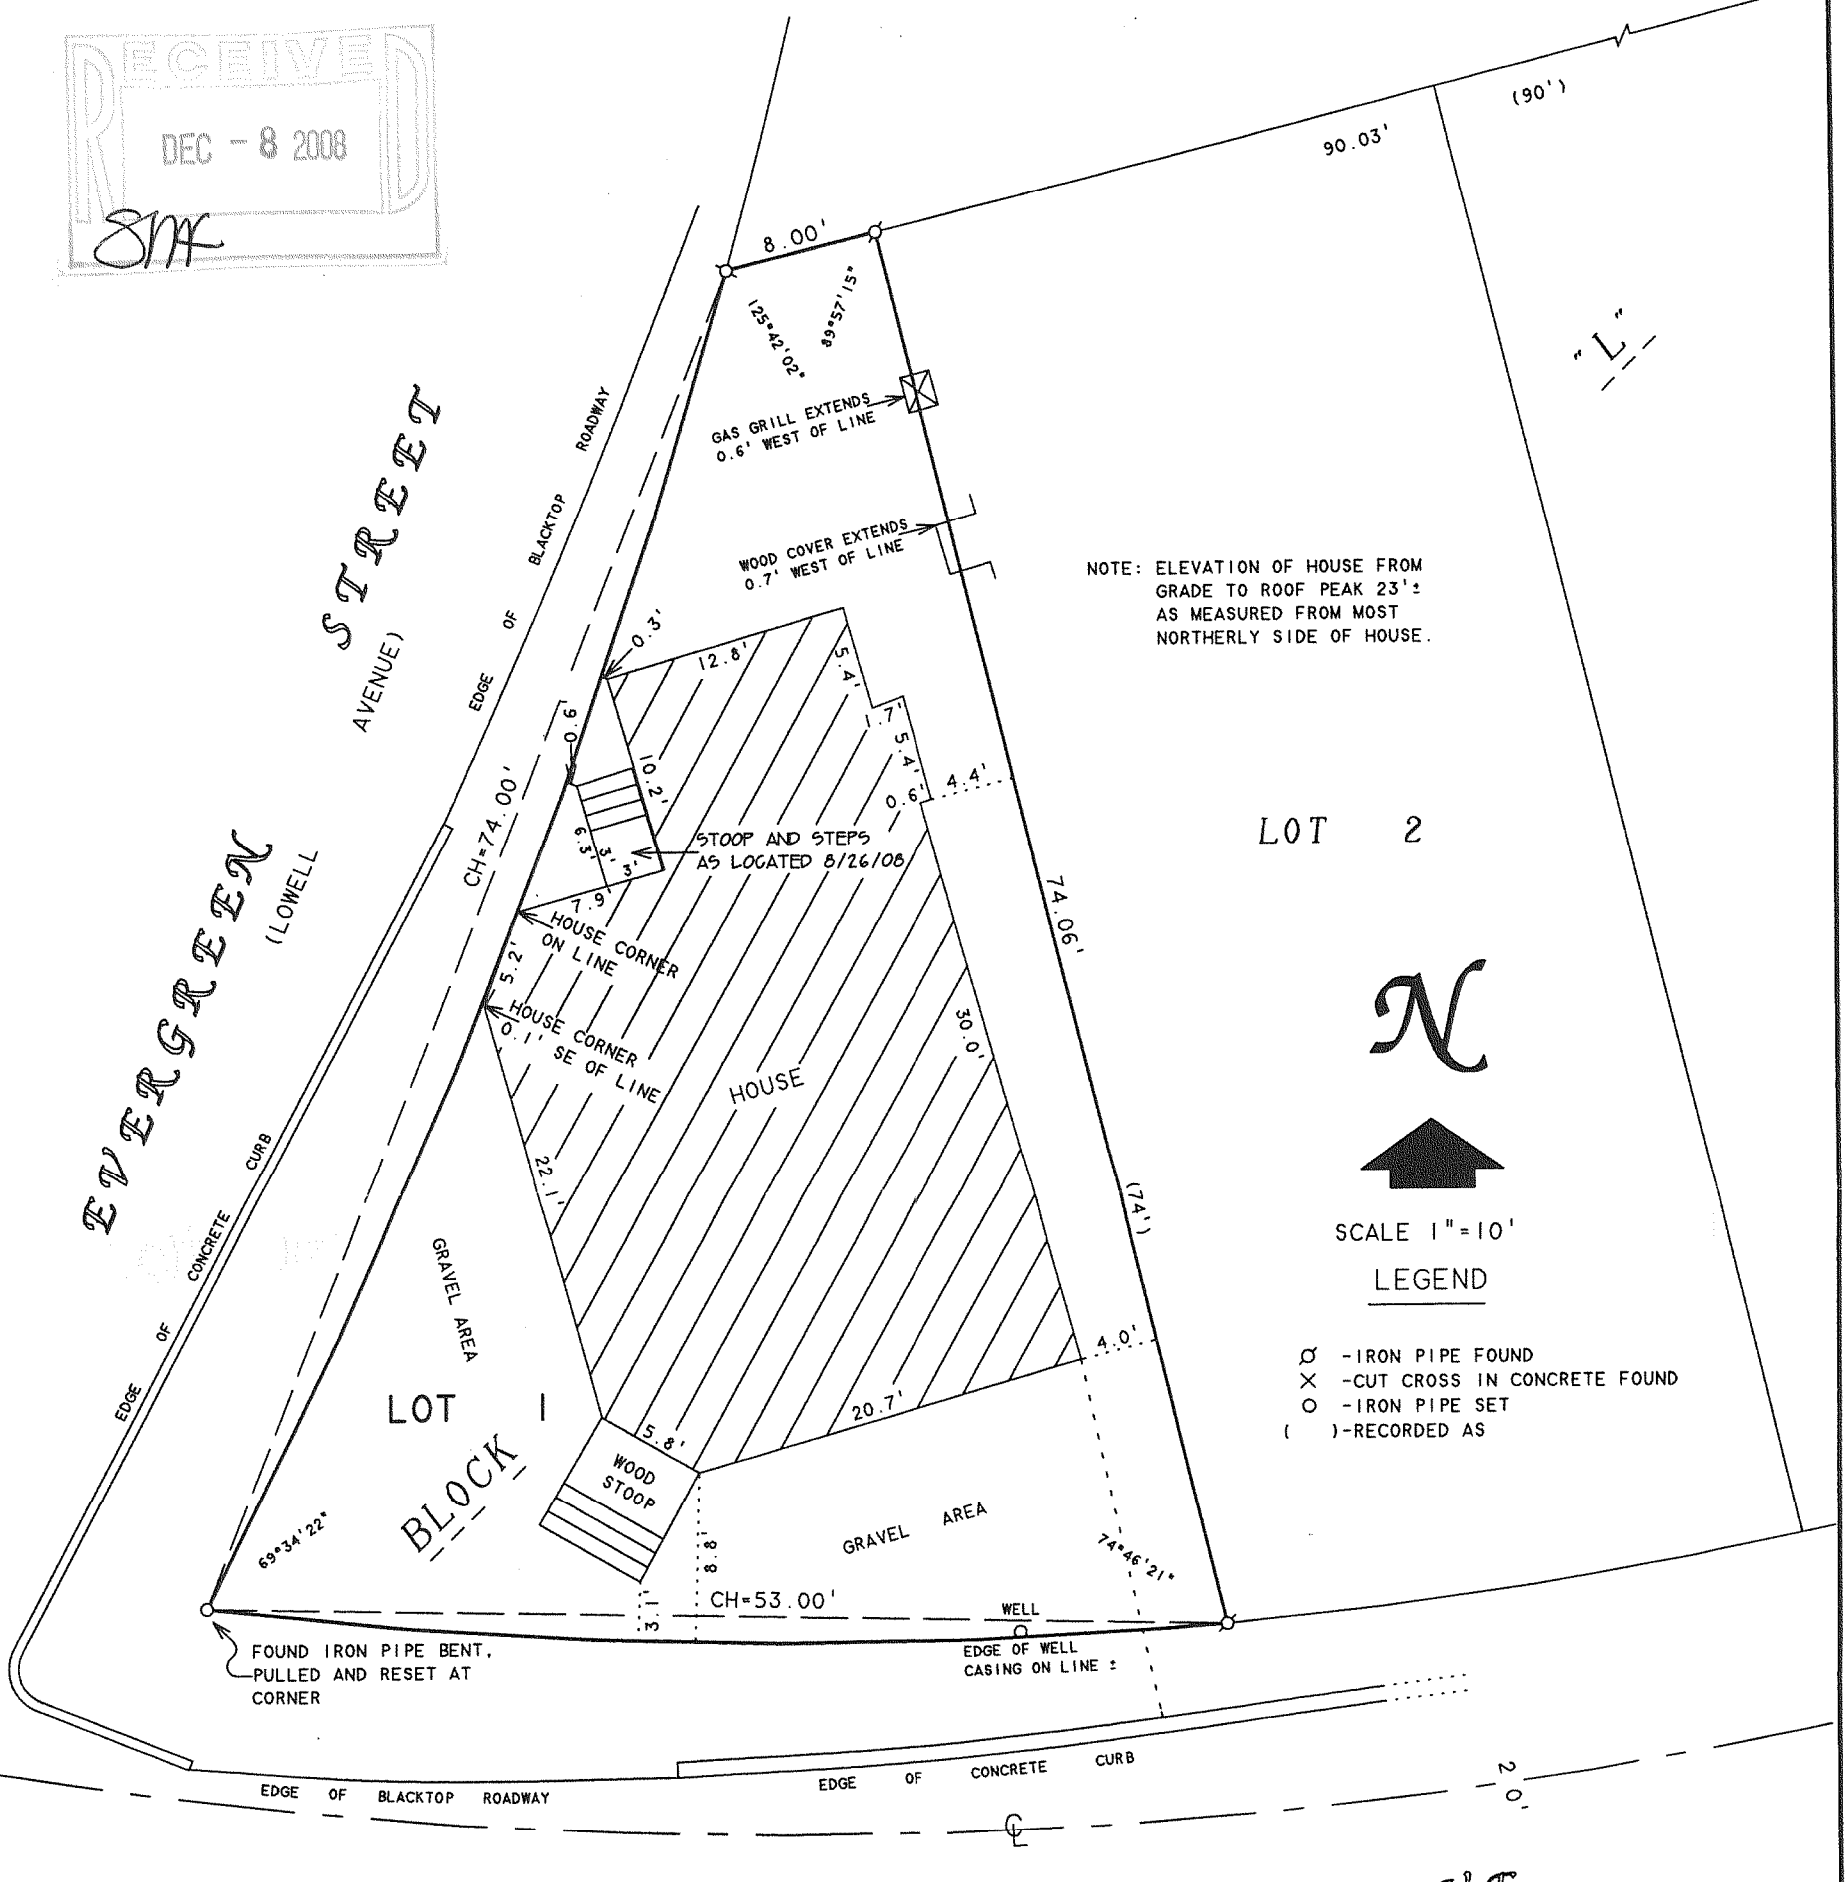

NOTE: ELEVATION OF HOUSE FROM GRADE TO ROOF PEAK 23'± AS MEASURED FROM MOST NORTHERLY SIDE OF HOUSE.

LEGEND

- ø -IRON PIPE FOUND
- X -CUT CROSS IN CONCRETE FOUND
- O -IRON PIPE SET
- ( )-RECORDED AS

ORDERED BY: GENE PURCELL
1103 COMPTOM
ADDISON, IL 60101

REVISED DATE: AUGUST 26, 2008
REVISED TO SHOW STOOP AND STEPS AS LOCATED ON AUGUST 26, 2008.

ORDERED BY: CHARLIE MADDEN
MADDEN DESIGN
W3989 COUNTY ROAD ES
ELKHORN, WI 53121

REVISED DATE: SEPTEMBER 16, 2002
REVISED TO SHOW MODIFICATIONS TO PROPOSED STOOP AND STEPS.

REVISED DATE: SEPTEMBER 12, 2002
REVISED TO SHOW MODIFICATIONS TO HOUSE AND PROPOSED STOOP AND STEPS.

ORDERED BY: JIM O'DONNELL
13726 S 88th AVENUE
ORLAND PARK, IL 60462

PLAT OF SURVEY OF

LOT 1, BLOCK "L", DELAVAN LAKE ASSEMBLY GROUNDS, LOCATED IN T2N, R16E, WALWORTH COUNTY, WISCONSIN.

I, DAVID F. ABELL, DO HEREBY CERTIFY THAT I HAVE SURVEYED THE PROPERTY HEREON DESCRIBED ACCORDING TO THE OFFICAL RECORDS AND THAT THE PLAT HEREON IS A CORRECT REPRESENTATION OF THE PROPERTY LINES TO THE BEST OF MY KNOWLEDGE AND BELIEF.

David F. Abell

DAVID F. ABELL
WISCONSIN REGISTERED LAND SURVEYOR, S-1596

October 17, 1996

DATE JOB NUMBER - 96180B

NOTE: THIS IS NOT A CERTIFIED COPY UNLESS SEALED.

FDLA-117

216-4601