
ABELL
SURVEYING & MAPPING

1140 SEQUOIA STREET • DELAVAN, WISCONSIN 53115
262-728-6737

POTAWATOMI DRIVE

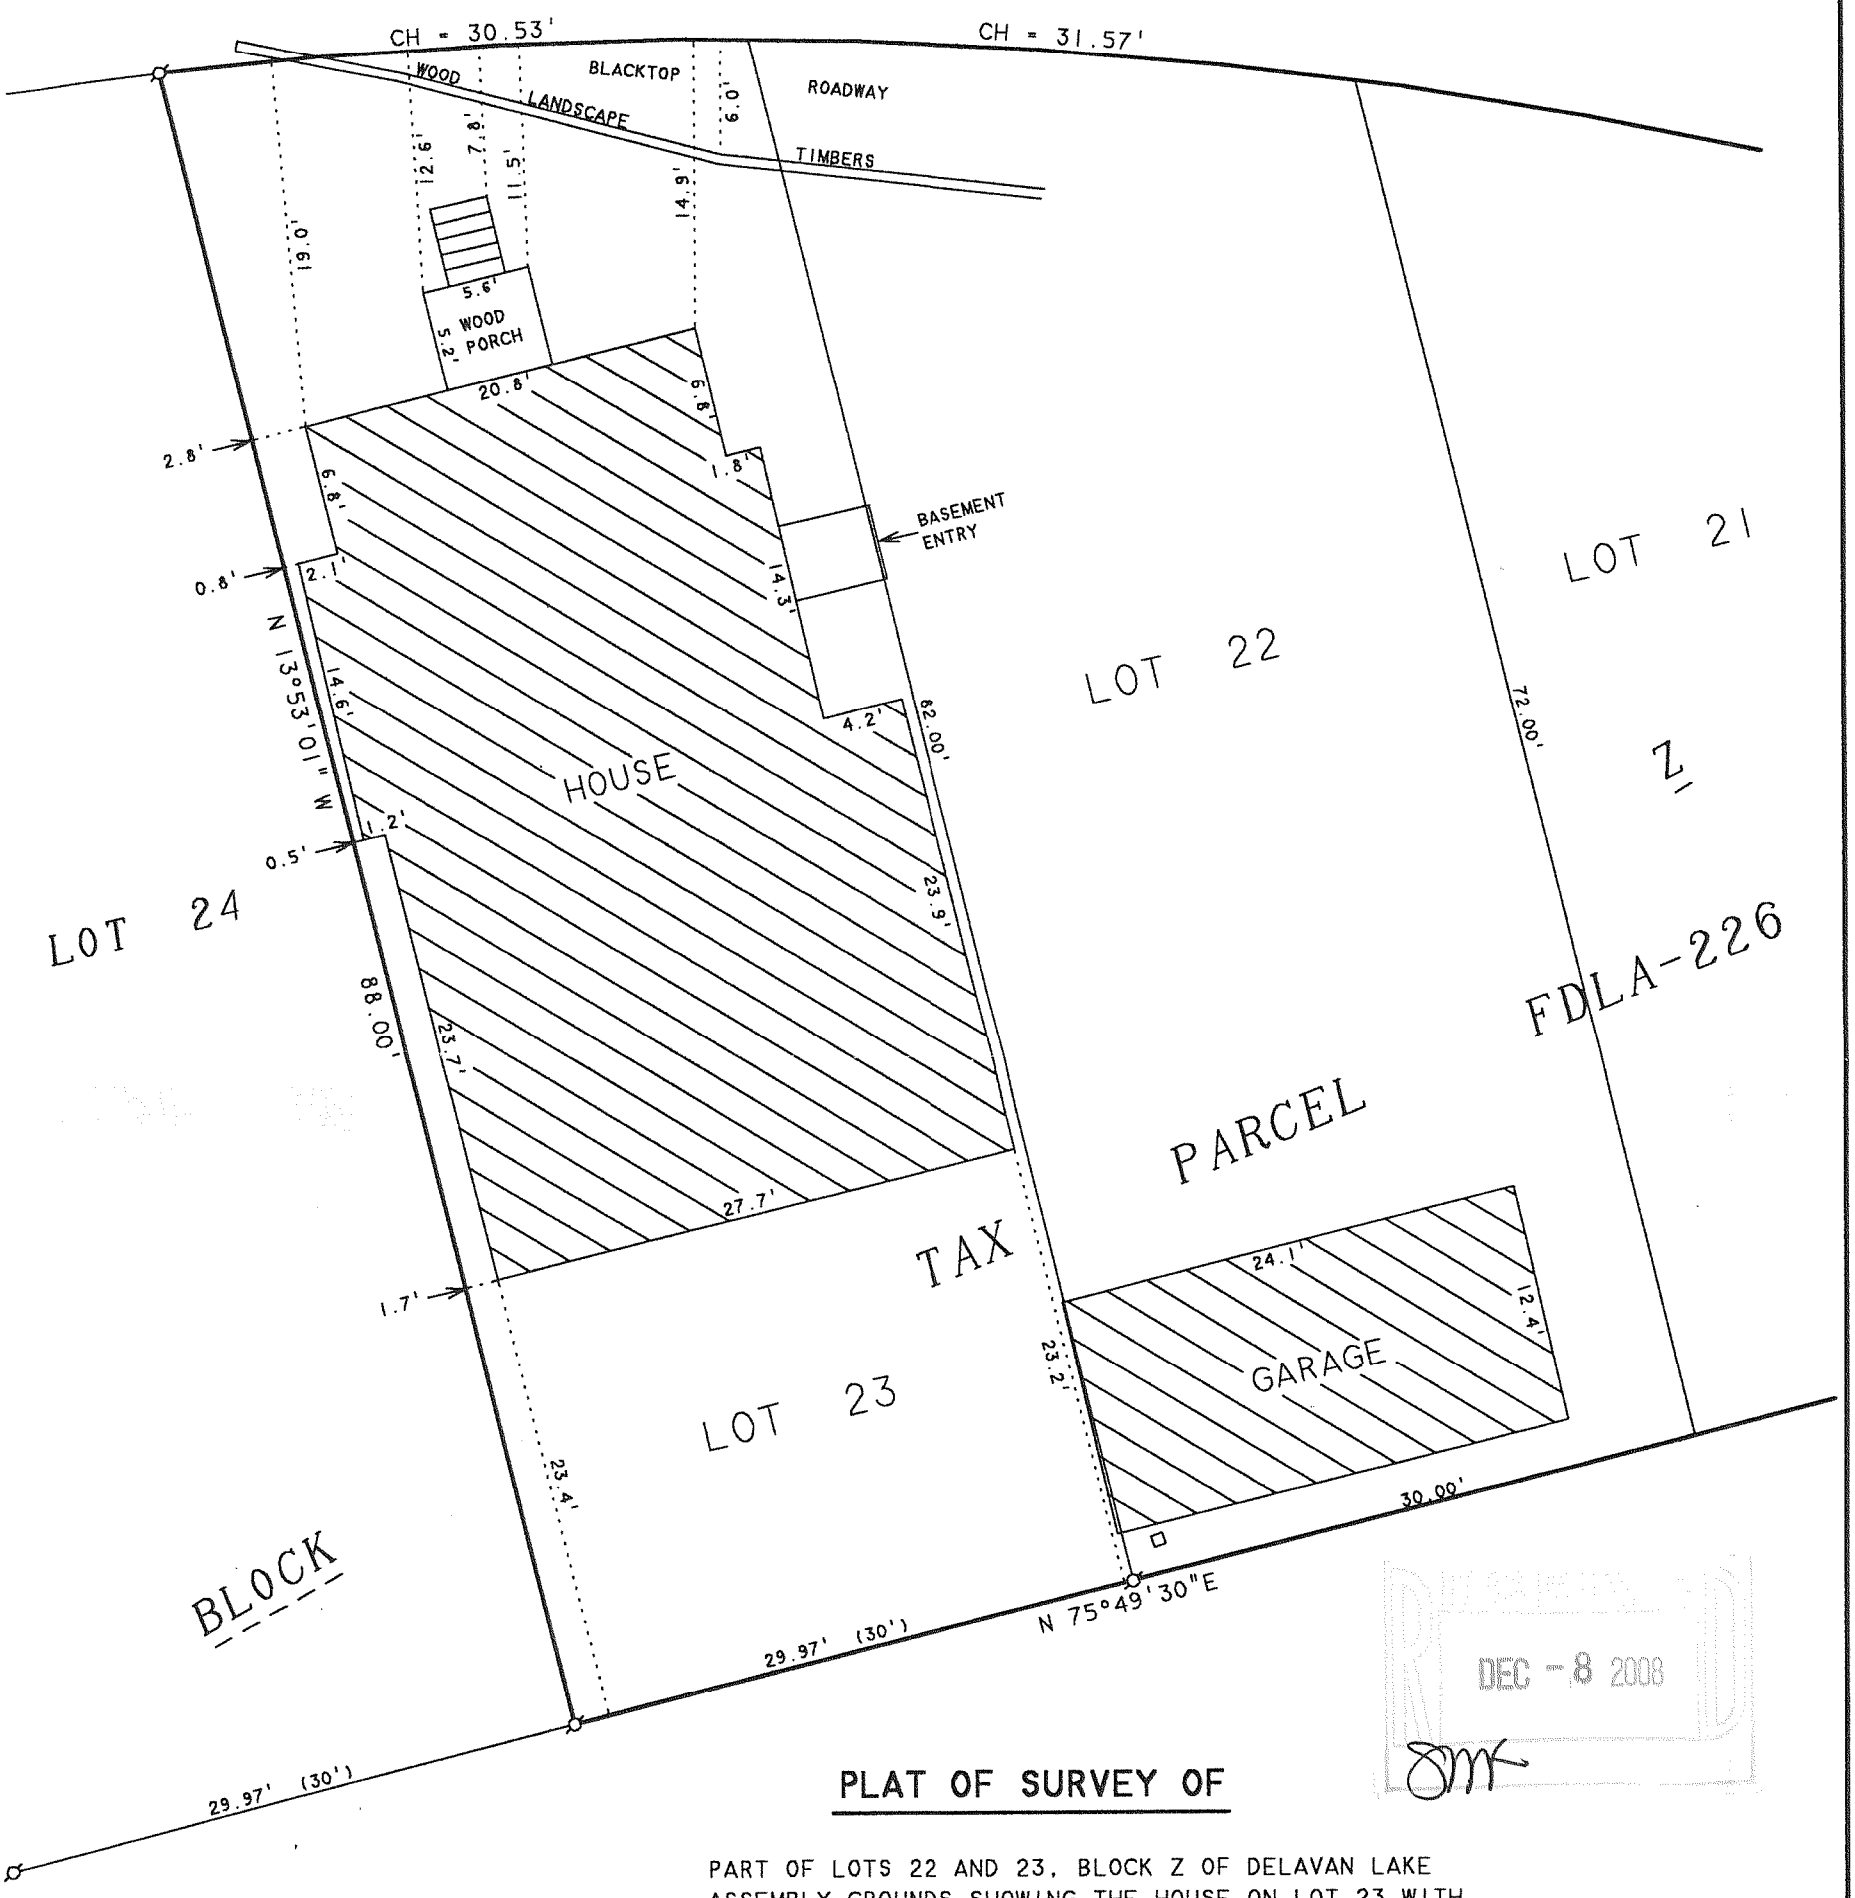

RECEIVED
DEC - 8 2008

PLAT OF SURVEY OF

PART OF LOTS 22 AND 23, BLOCK Z OF DELAVAN LAKE ASSEMBLY GROUNDS SHOWING THE HOUSE ON LOT 23 WITH DISTANCES FROM THE FRONT PORCH TO THE ROAD LINE. ALL LOCATED IN T2N.R16E, WALWORTH COUNTY, WISCONSIN.

ORDERED BY: ROB MOHR (CARETAKER FOR ASSEMBLY PARK)
1607 POTAWATOMI DRIVE
DELAVAN, WI 53115

N

SCALE 1"=10'

LEGEND

ø - IRON PIPE FOUND
( )- RECORDED AS

I, DAVID F. ABELL, DO HEREBY CERTIFY THAT I HAVE SURVEYED THE PROPERTY HEREON DESCRIBED ACCORDING TO THE OFFICAL RECORDS AND THAT THE PLAT HEREON IS A CORRECT REPRESENTATION OF THE PROPERTY LINES TO THE BEST OF MY KNOWLEDGE AND BELIEF.

David F. Abell

DAVID F. ABELL
WISCONSIN REGISTERED LAND SURVEYOR, S-1596

October 1, 2008

DATE JOB NUMBER - 08037
NOTE: THIS IS NOT A CERTIFIED COPY UNLESS SEALED.

FDLA-226

216-4607