
PLAT OF SURVEY

LOTS 1
CSM 3335

REC. VOL. 19, PG. 57, DOC. NO. 476959
PART OF SECTION 23
TOWN 2 NORTH, RANGE 16 EAST
WALWORTH COUNTY, WISCONSIN

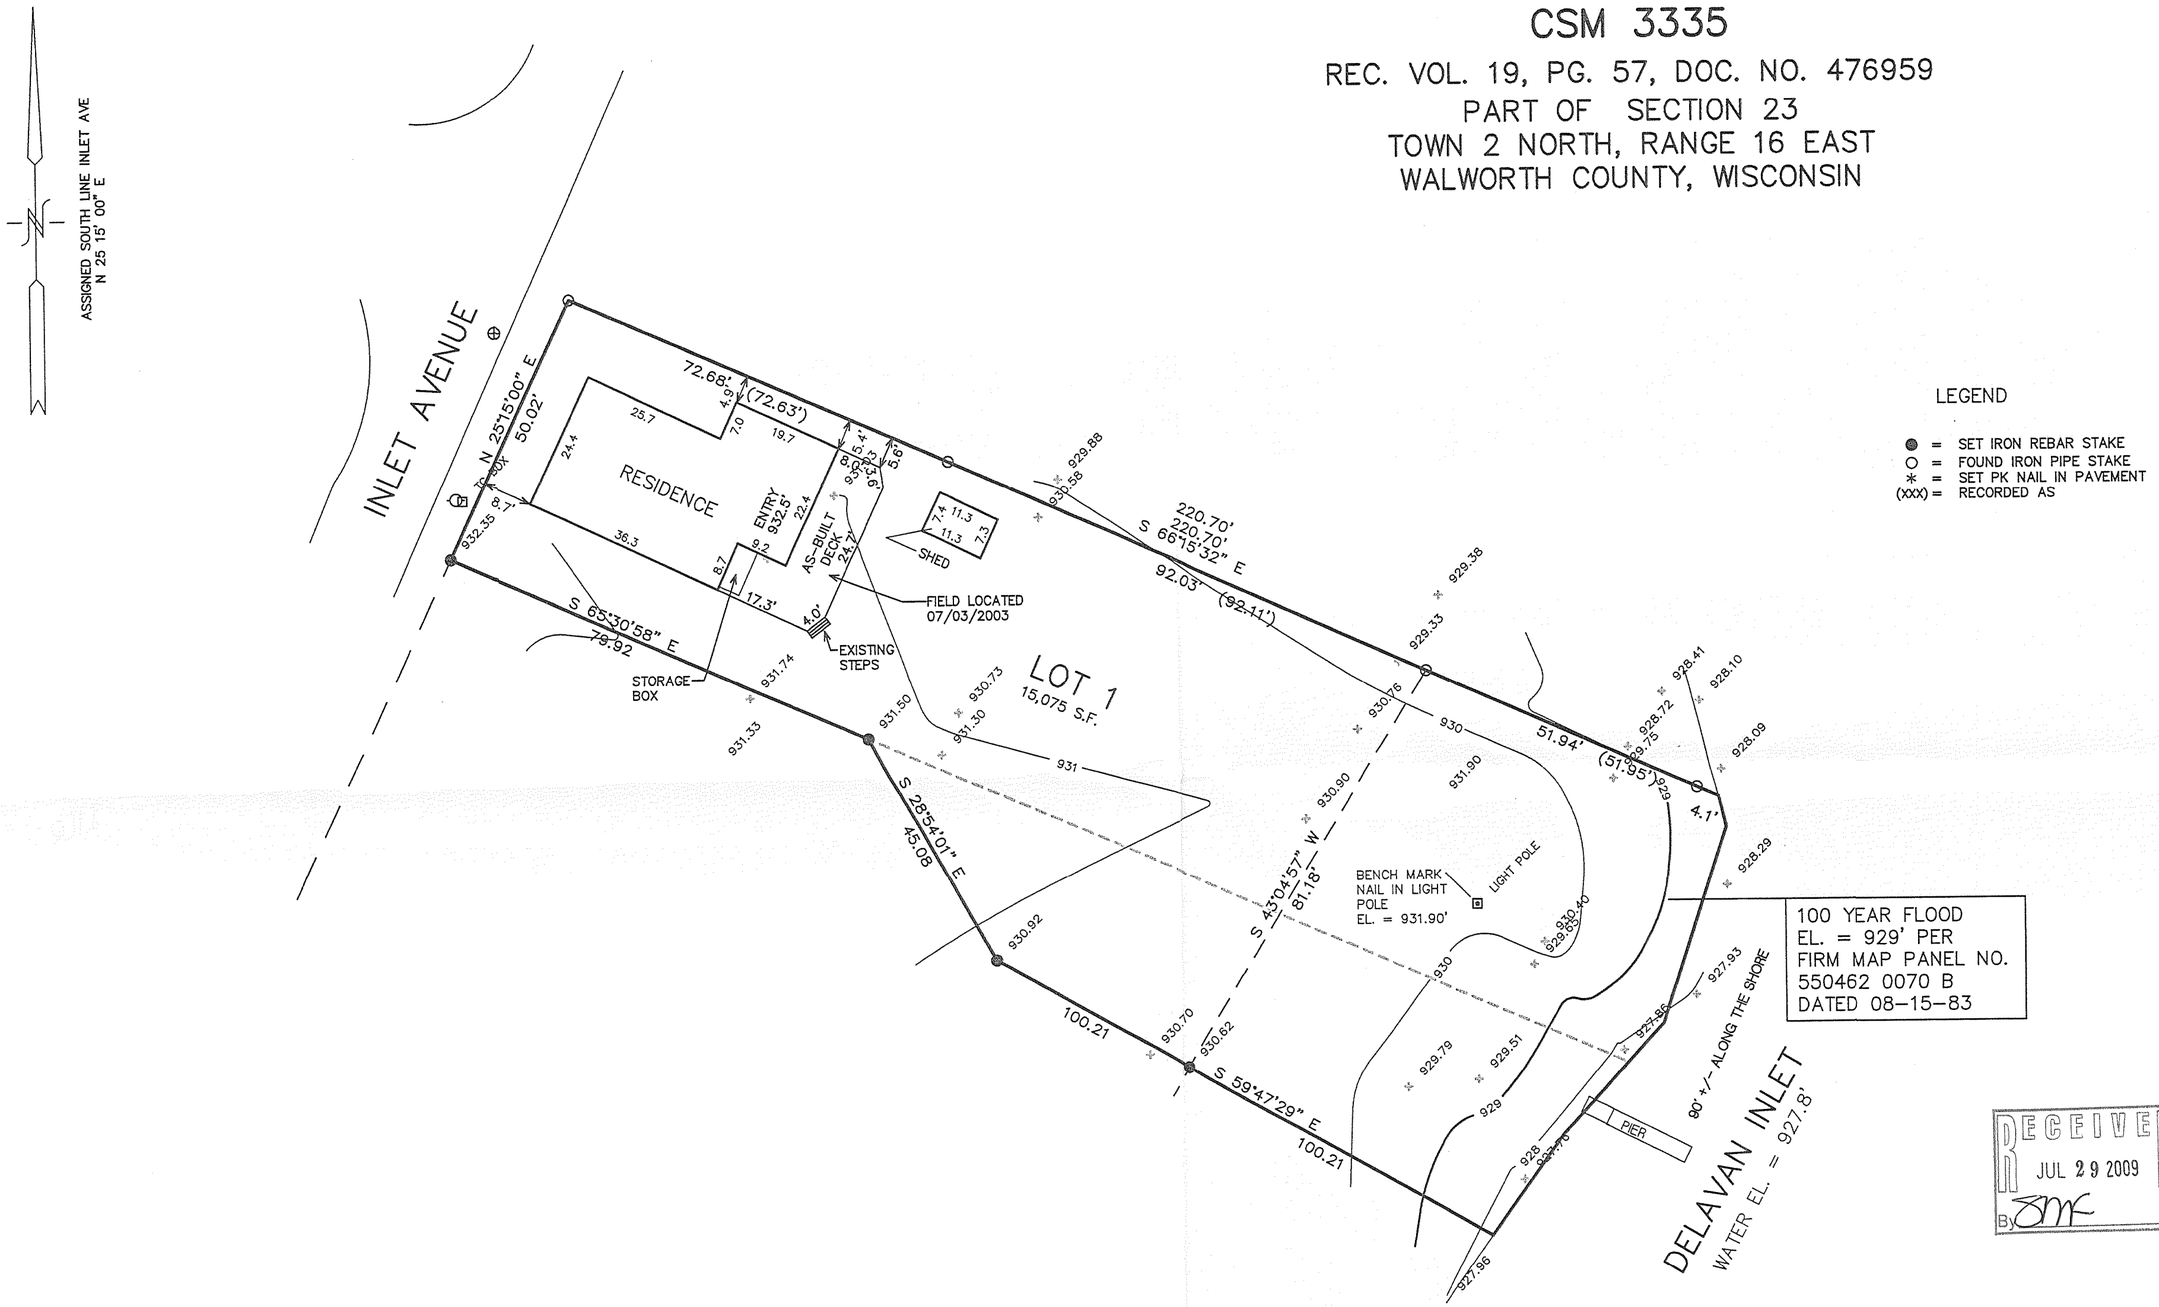

LEGEND

- ● = SET IRON REBAR STAKE
- ○ = FOUND IRON PIPE STAKE
- ✱ = SET PK NAIL IN PAVEMENT
- (xxx) = RECORDED AS

100 YEAR FLOOD
EL. = 929' PER
FIRM MAP PANEL NO.
550462 0070 B
DATED 08-15-83

RECEIVED
JUL 29 2009
By SMF

10 5 0 10 20 30 40 50 60 70 80 90 100
MAP SCALE IN FEET ORIGINAL 1" = 20'

NOTE: COPIES OF THIS MAP TO WHICH THE FOLLOWING CERTIFICATE WILL APPLY SHOW SURVEYOR'S ORIGINAL SEAL AND SIGNATURE IN RED INK. COPIES BY ANY OTHER MEANS MAY HAVE ALTERATIONS WHICH DO NOT REPRESENT THE SURVEYOR'S WORK PRODUCT.

I HEREBY CERTIFY THAT THE ABOVE DESCRIBED PROPERTY HAS BEEN SURVEYED UNDER MY DIRECTION AND THAT THE ABOVE MAP IS A TRUE REPRESENTATION THEREOF AND SHOWS THE SIZE AND LOCATION OF THE PROPERTY AND ITS EXTERIOR BOUNDARIES. THIS SURVEY IS MADE FOR THE USE OF THE PRESENT OWNERS OF THE PROPERTY, AND ALSO THOSE WHO PURCHASE, MORTGAGE, OR GUARANTEE THE TITLE THERETO WITHIN ONE YEAR FROM THE DATE HEREOF.

WISCONSIN
PETER S. GORDON
S-2101
ELKHORN, WI
LAND SURVEYOR

DATED: 07-18-2000

REVISED 07-27-2009
TO REFLECT FLOOD LINE
PER COUNTY AND NATIONAL
FLOOD PROGRAM INFORMATION

PETER S. GORDON R.L.S. 2101

WORK ORDERED BY:
JOHN BOUMENOT
PO BOX 653
DELAVAN, WI. 53115

FARRIS, HANSEN & ASSOCIATES, INC
Engineering, Architecture, Surveying
7 Ridgway Court P.O. Box 437
ELKHORN, WISCONSIN 53121
Office: (414) 723-2098
Fax: (414) 723-5886

REVISIONS
11/07/02-
GENERAL
REVISIONS
11/12/02-
TO SHOW PRO.
DECK
07/07/03-
TO SHOW SIZE
& LOCATION OF
AS-BUILT DECK

PROJECT NO.
5629
DATE:
07-17-00
SHEET NO.
1 OF 1

FA3335-1

216-4600