



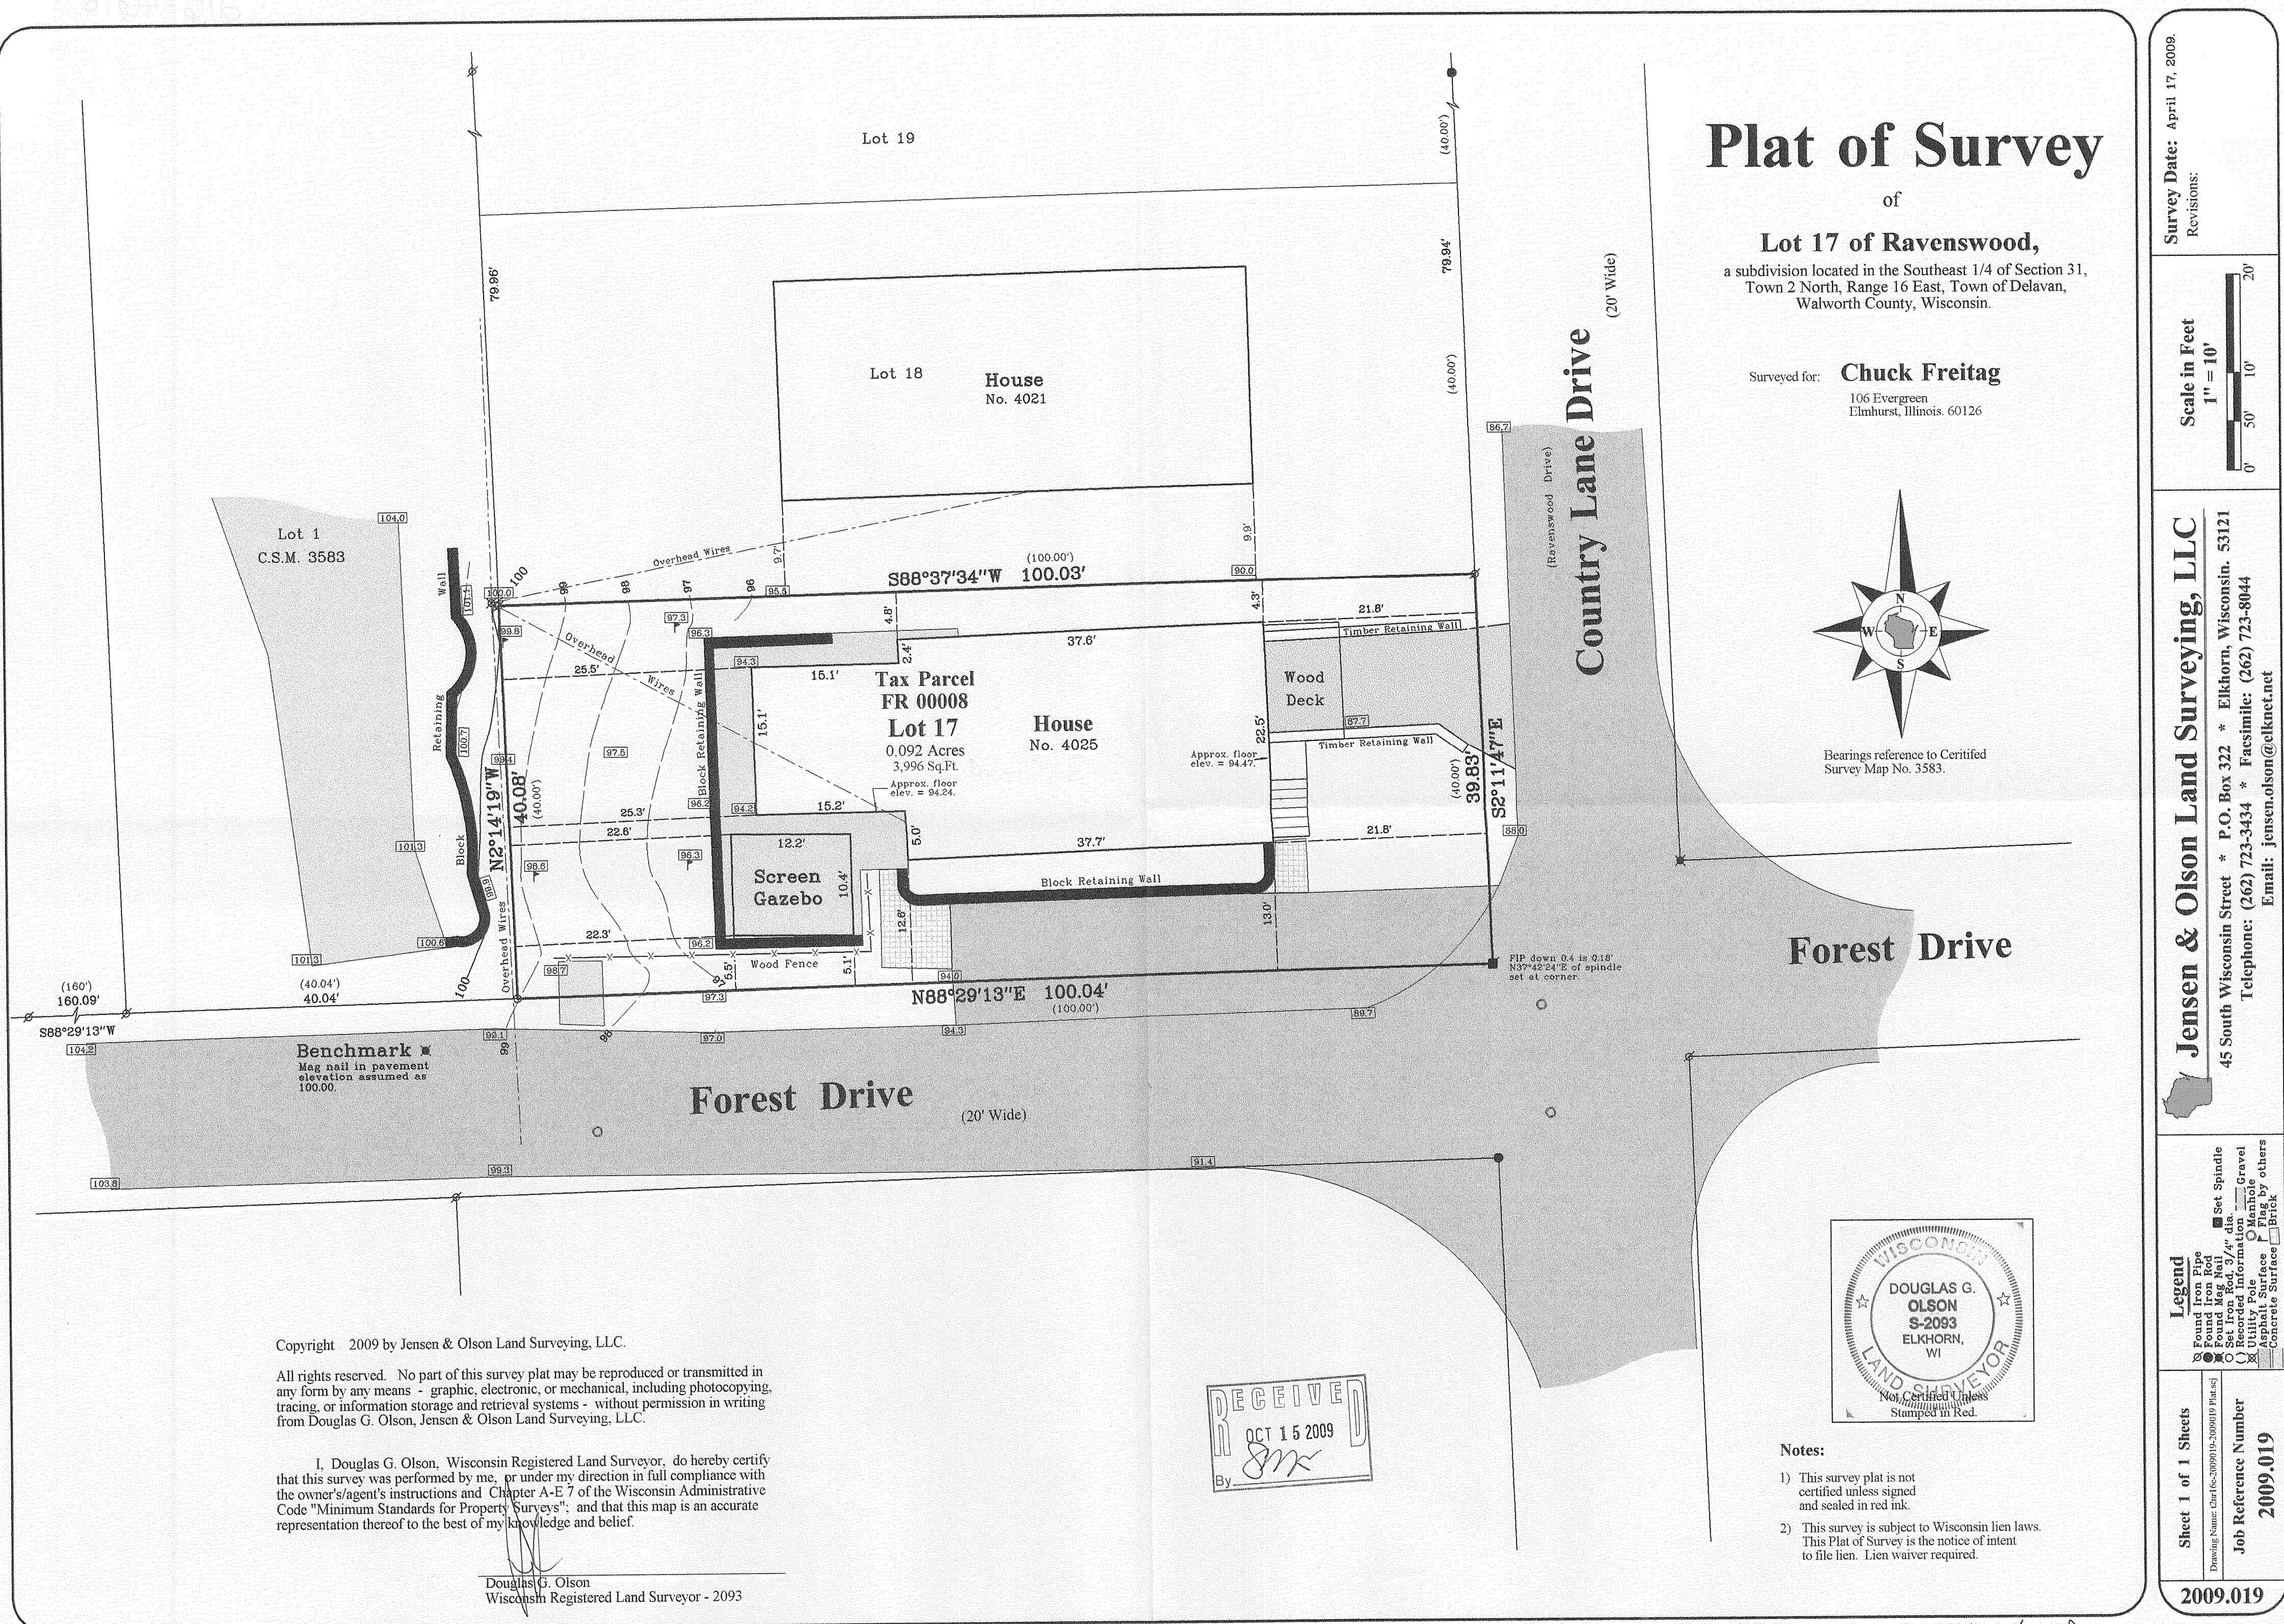


Plat of Survey

of
Lot 17 of Ravenswood,
a subdivision located in the Southeast 1/4 of Section 31,
Town 2 North, Range 16 East, Town of Delavan,
Walworth County, Wisconsin.

Surveyed for: **Chuck Freitag**
106 Evergreen
Elmhurst, Illinois. 60126

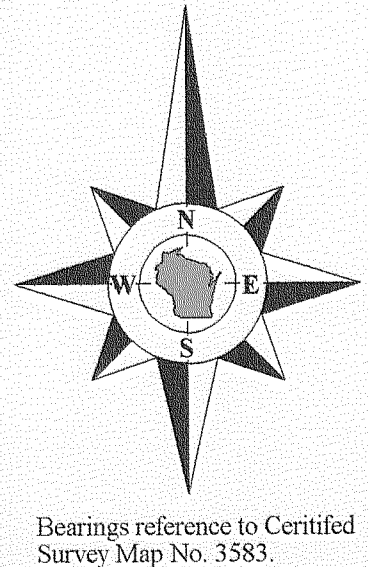

Survey Date: April 17, 2009.
Revisions:

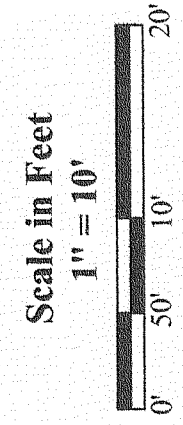

Jensen & Olson Land Surveying, LLC
45 South Wisconsin Street * P.O. Box 322 * Elkhorn, Wisconsin. 53121
Telephone: (262) 723-3434 * Facsimile: (262) 723-8044
Email: jensen.olson@elknet.net

- Legend**
- Found Iron Pipe
 - Found Iron Rod
 - Found Mag Nail
 - Set Iron Rod 3/4" dia
 - Utility Pole
 - Asphalt Surface
 - Concrete Surface
 - Set Spindle
 - Gravel
 - Manhole
 - Flag by others
 - Brick

Sheet 1 of 1 Sheets
Drawing Name: C:\rc-2009\19-2009\19 Plat.sjg
Job Reference Number
2009.019


2009.019

Copyright 2009 by Jensen & Olson Land Surveying, LLC.

All rights reserved. No part of this survey plat may be reproduced or transmitted in any form by any means - graphic, electronic, or mechanical, including photocopying, tracing, or information storage and retrieval systems - without permission in writing from Douglas G. Olson, Jensen & Olson Land Surveying, LLC.

I, Douglas G. Olson, Wisconsin Registered Land Surveyor, do hereby certify that this survey was performed by me, or under my direction in full compliance with the owner's/agent's instructions and Chapter A-E 7 of the Wisconsin Administrative Code "Minimum Standards for Property Surveys", and that this map is an accurate representation thereof to the best of my knowledge and belief.

Douglas G. Olson
Wisconsin Registered Land Surveyor - 2093

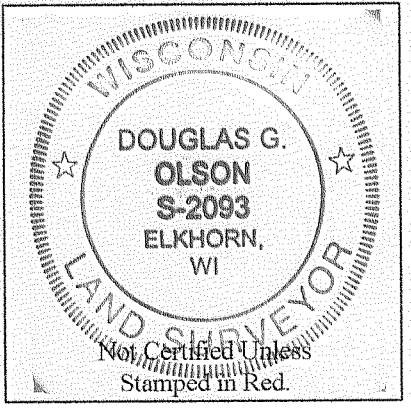

- Notes:**
- This survey plat is not certified unless signed and sealed in red ink.
 - This survey is subject to Wisconsin lien laws. This Plat of Survey is the notice of intent to file lien. Lien waiver required.

FR-8

216-4678