




ORDERED BY THE ESTATE OF SUSAN RITA
 C/O JOSEPH JOHNSON
 1205 SHERMAN ROAD
 NORTHBROOK, IL 60062

FARRIS, HANSEN & ASSOCIATES, INC.
 ENGINEERING - ARCHITECTURE - SURVEYING
 7 RIDGWAY COURT P.O. BOX 437
 ELKHORN, WISCONSIN 53121
 OFFICE: (262) 723-2098 FAX: (262) 723-5886

REVISIONS

PROJECT NO.
 8033
 DATE:
 11-03-2009
 SHEET NO.
 1 OF 1

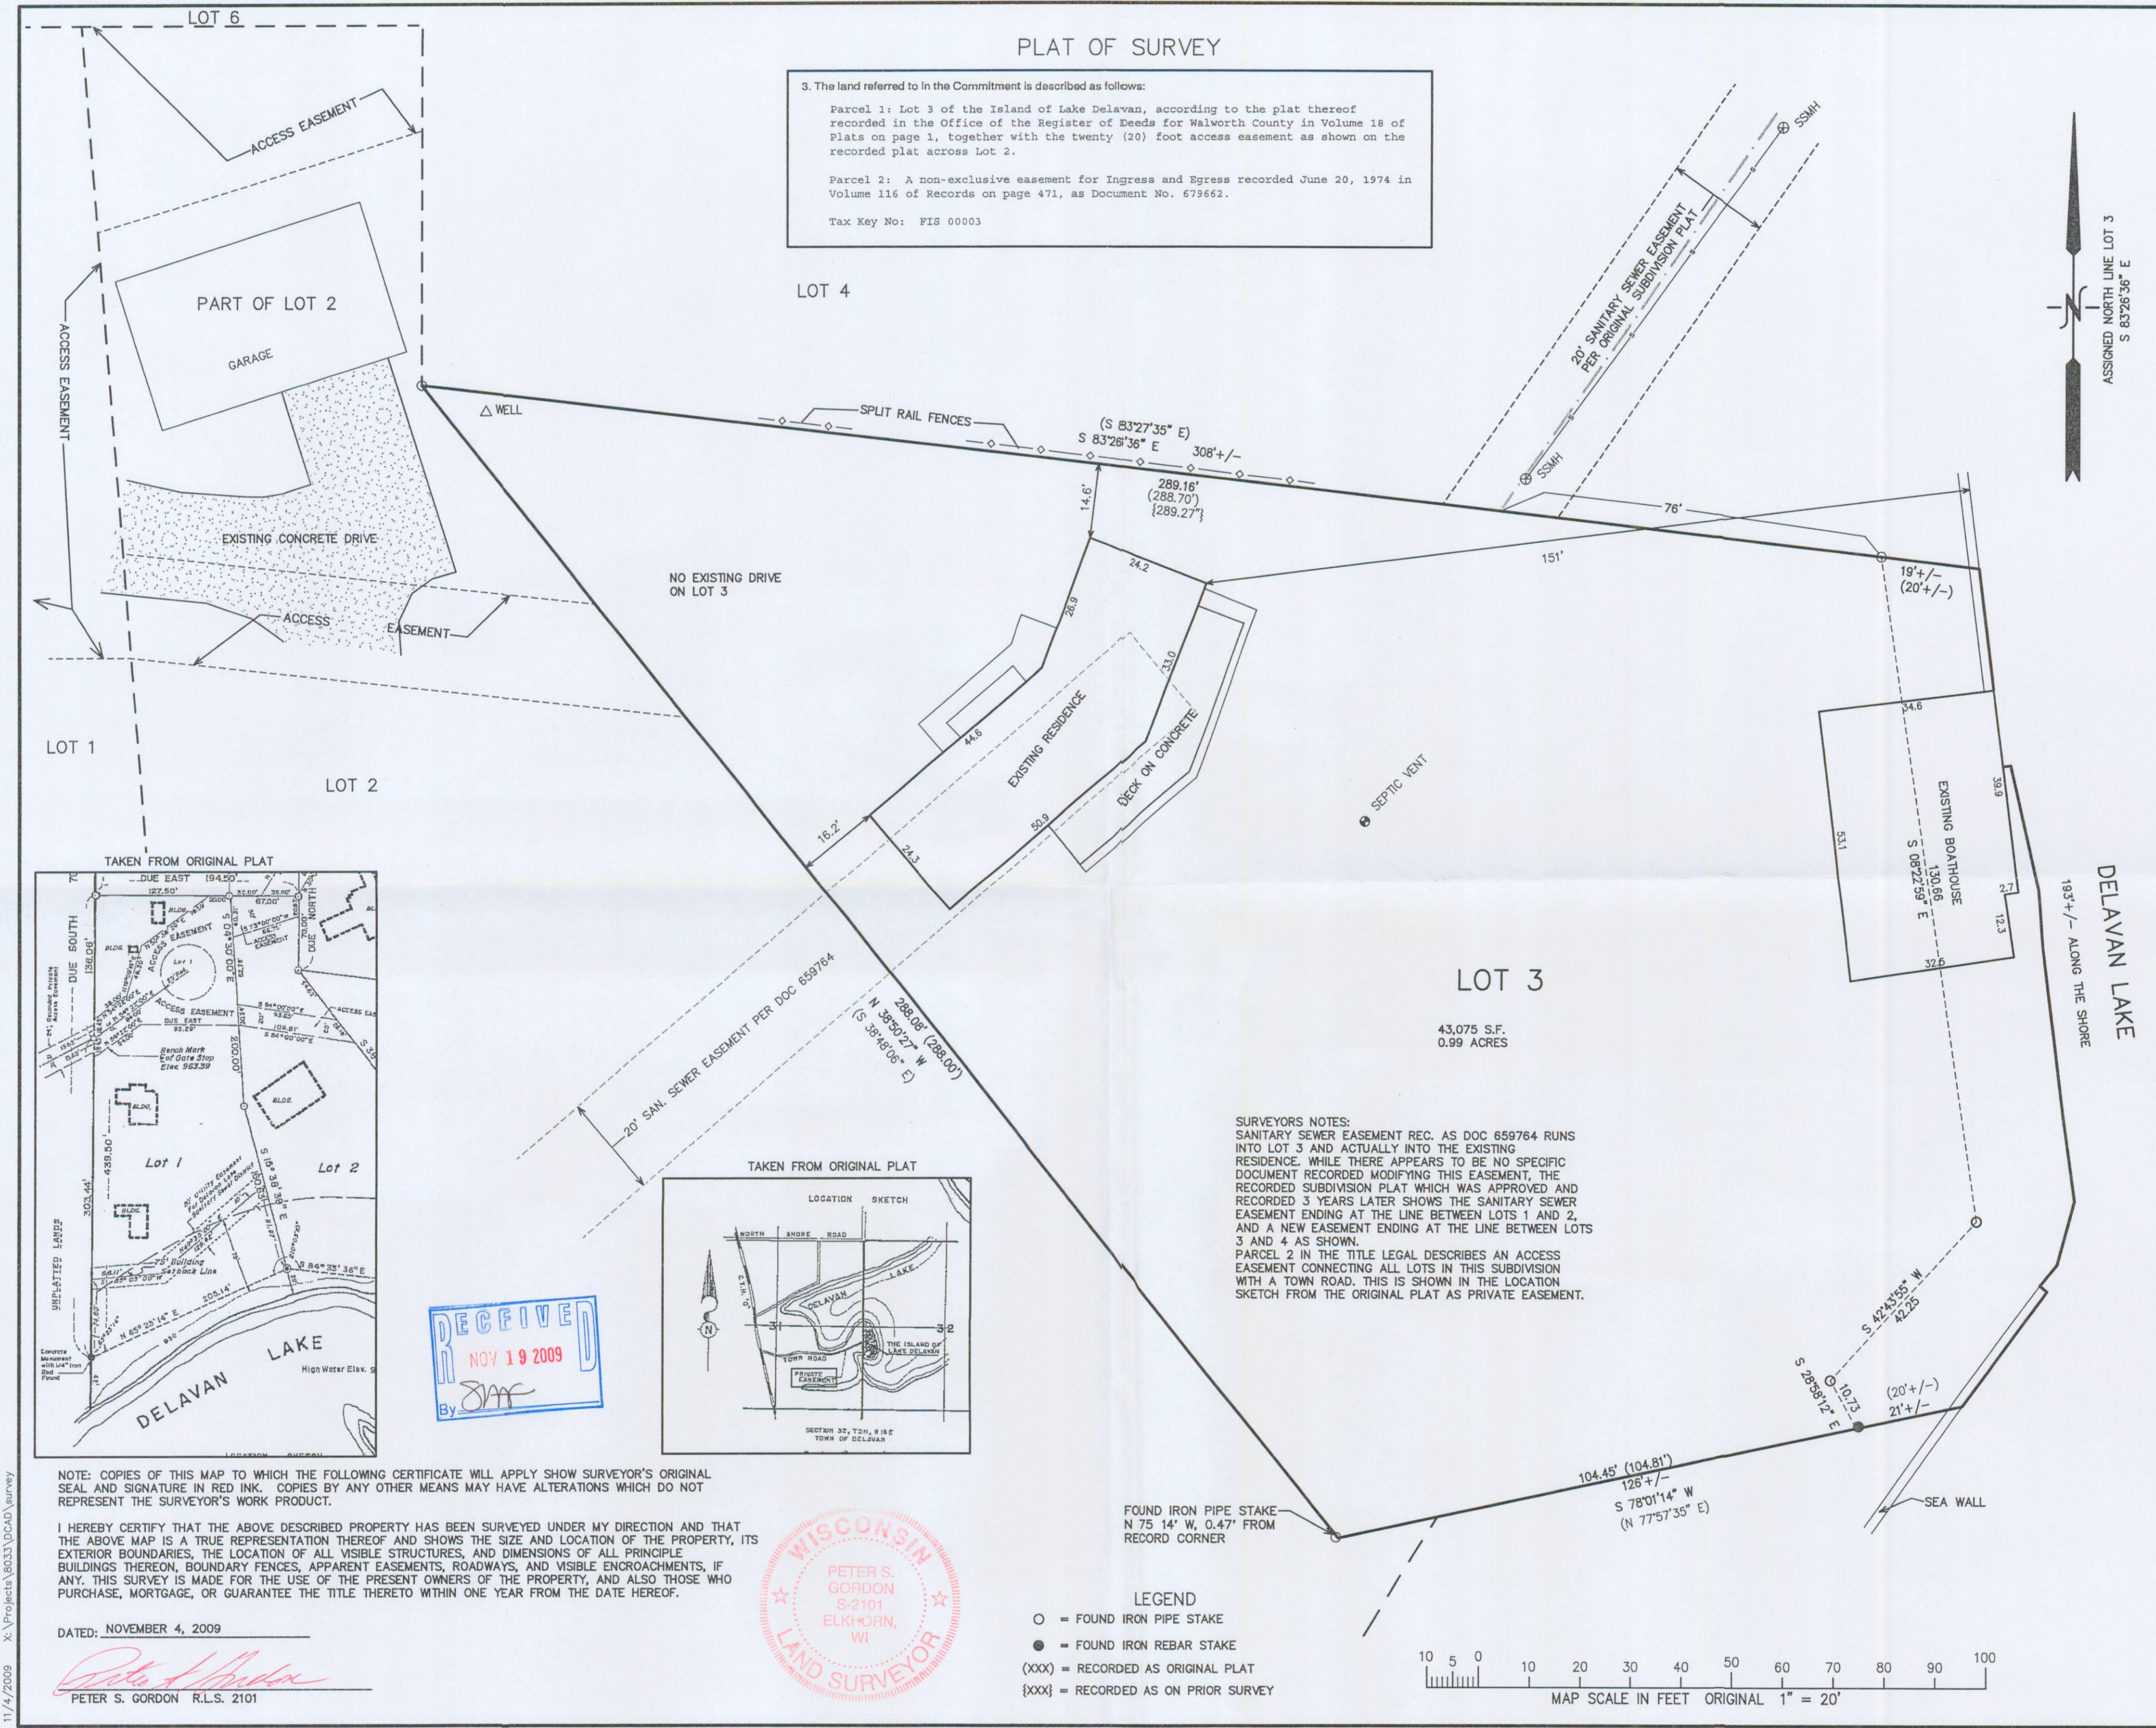

FIS-3

216-4706

11/4/2009 X:\Projects\8033\DCAD\survey

NOV 02 2009