
PREPARED FOR:
MARK CARLSON
8106 W. THOMAS APT 1E
JUSTICE, IL 60458

PLAT OF SURVEY

- OF -

LOT 18 IN LAKE DELAVAN HIGHLANDS, BEING A SUBDIVISION LOCATED IN THE SOUTH 1/2 OF THE SOUTHEAST 1/4 OF SECTION 31, TOWN 2 NORTH, RANGE 16 EAST, TOWN OF DELAVAN, WALWORTH COUNTY, WISCONSIN.

KROTT SURVEYING, INC.
N3705 WILLOW BEND LANE
LAKE GENEVA, WI 53147
(262)- 248-3697

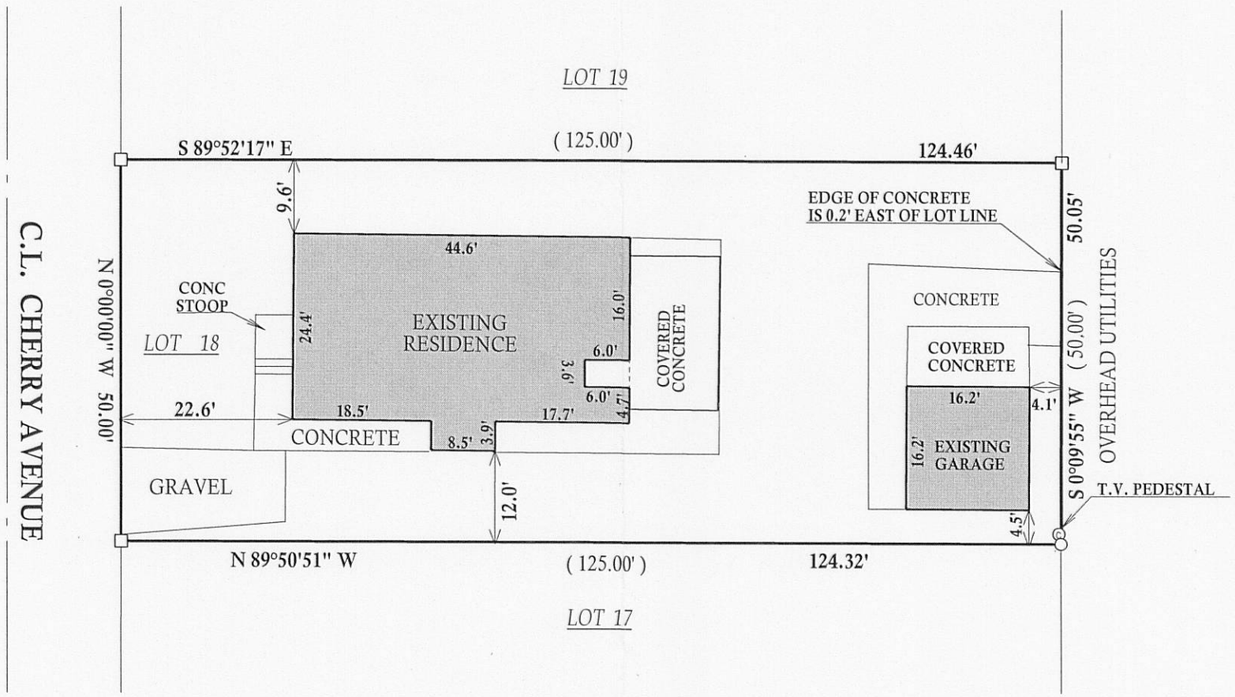

SCALE 1" = 20'

( ) = *RECORDED AS*
□ = *FOUND IRON BAR*
○ = *FOUND IRON PIPE*
■ = *SET IRON BAR*
● = *SET IRON PIPE*

JOB #: 07-128

TAX ID #: FLAD 00016

RECEIVED
SEP 10 2010
By

I have surveyed the above-described property and the above map is a true representation thereof and shows the size and location of the property, its exterior boundaries, the location and dimensions of all structures thereon, fences apparent easements and roadways and visible encroachments. if any.

This survey is made for the exclusive use of the present owners of the property, and also those who puchase, mortgage,or insure the title therto within one (1) year from date hereof; and as to them I warrant the accuracy of said survey map.

WISCONSIN
JOHN P.
KROTT
S-2258
LAKE GENEVA
WIS.
LAND SURVEYOR

DATED THIS 1st, DAY OF SEPTEMBER, 2010

JOHN KROTT S - 2258
Wisconsin Registered Land Surveyor
(original if signed in red)