
GEORGE T. DUNHAM

SURVEYING & SUBDIVIDING

DELAVAN, WISCONSIN

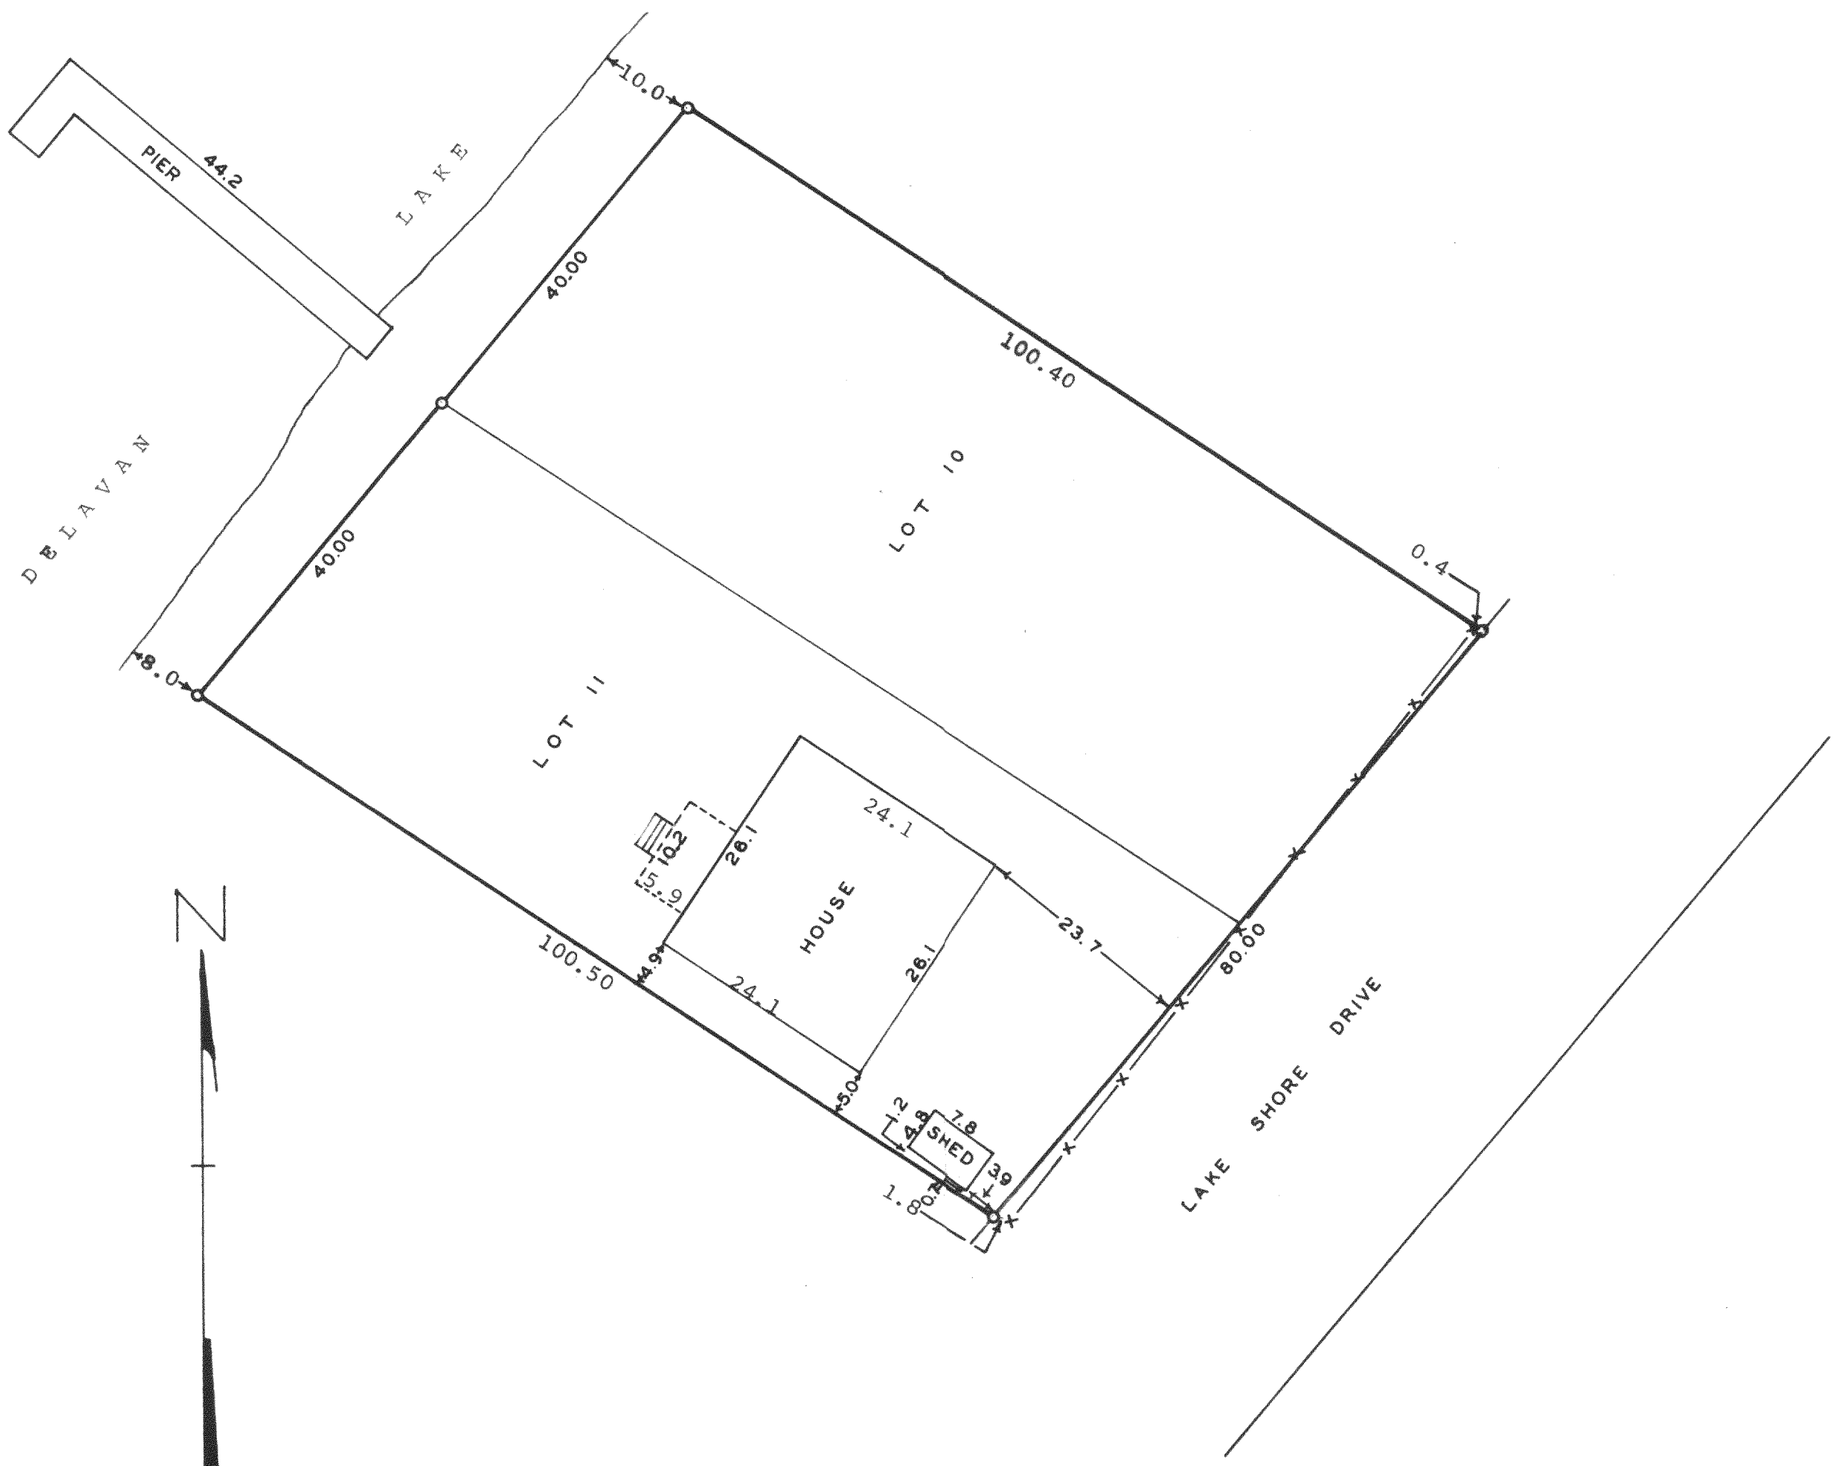

Scale - 1" = 15'
o = Iron Pipe
-x--x-= Fence Line

STATE OF WISCONSIN)
COUNTY OF WALWORTH) SS

I, George T. Dunham, Surveyor, certify that I have surveyed the property described as follows,

Lots 10 and 11, Block 1 of South Shore Manor located in Section 32, T 2 N, R 16 E, Walworth County, Wisconsin

and that the above plat is an accurate survey and a true representation thereof and correctly shows the size and location of the property, its exterior boundaries, the location and demensions of all structures thereon, fences, apparent easements and visible encroachments.

August 8, 1974

George T. Dunham, Surveyor

WISCONSIN
GEORGE T. DUNHAM
DELAVAN, WIS.
LAND SURVEYOR

FSS-9

K & E 10-9168 250-7-73

216-478