



PLAT OF SURVEY

LOTS 16-19, BLOCK A OF DELAVAN LAKE ASSEMBLY GROUNDS


LOCATED IN PART OF THE NORTHWEST 1/4 OF THE SOUTHEAST 1/4 OF SECTION 21, TOWN 2 NORTH,
RANGE 16 EAST, WALWORTH COUNTY, WISCONSIN

LEGEND
O = IRON PIPE STAKE FOUND
{XXX} = RECORDED AS PLATTED
[XXX] = RECORDED AS PREVIOUSLY SURVEYED


NOTE: COPIES OF THIS MAP TO WHICH THE FOLLOWING CERTIFICATE WILL APPLY SHOW THE SURVEYOR'S ORIGINAL SEAL AND SIGNATURE IN RED INK. COPIES BY ANY OTHER MEANS MAY HAVE ALTERATIONS WHICH DO NOT REPRESENT THE SURVEYOR'S WORK PRODUCT.

I HEREBY CERTIFY THAT THE ABOVE DESCRIBED PROPERTY HAS BEEN SURVEYED UNDER MY DIRECTION AND THAT THE ABOVE MAP IS A TRUE REPRESENTATION THEREOF AND SHOWS THE SIZE AND LOCATION OF THE PROPERTY AND ITS EXTERIOR BOUNDARIES. THIS SURVEY IS MADE FOR THE USE OF THE PRESENT OWNERS OF THE PROPERTY, AND ALSO THOSE WHO PURCHASE, MORTGAGE, OR GUARANTEE THE TITLE THERETO WITHIN ONE YEAR FROM THE DATE HEREOF.



DATED: MAY 18, 2011

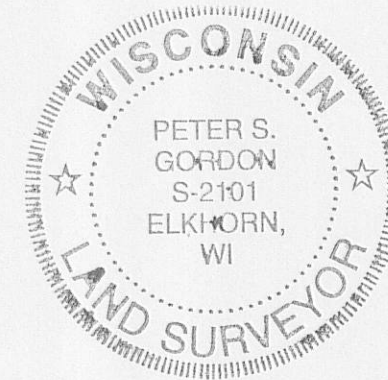

Peter S. Gordon
PETER S. GORDON R.L.S. 2101

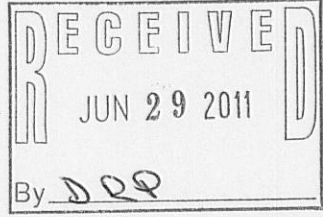

SOUTH LINE OF ASSEMBLY LANE
BEARS N 90°00'00" E

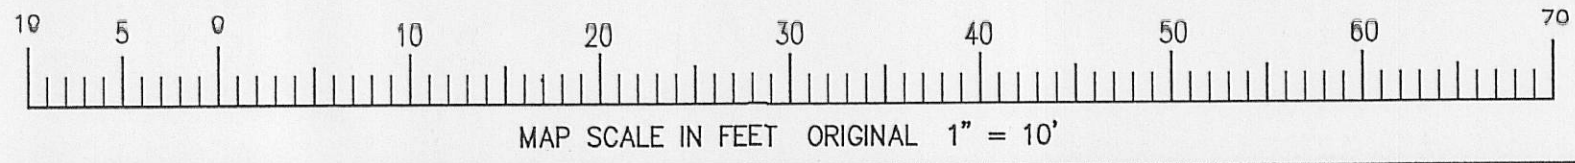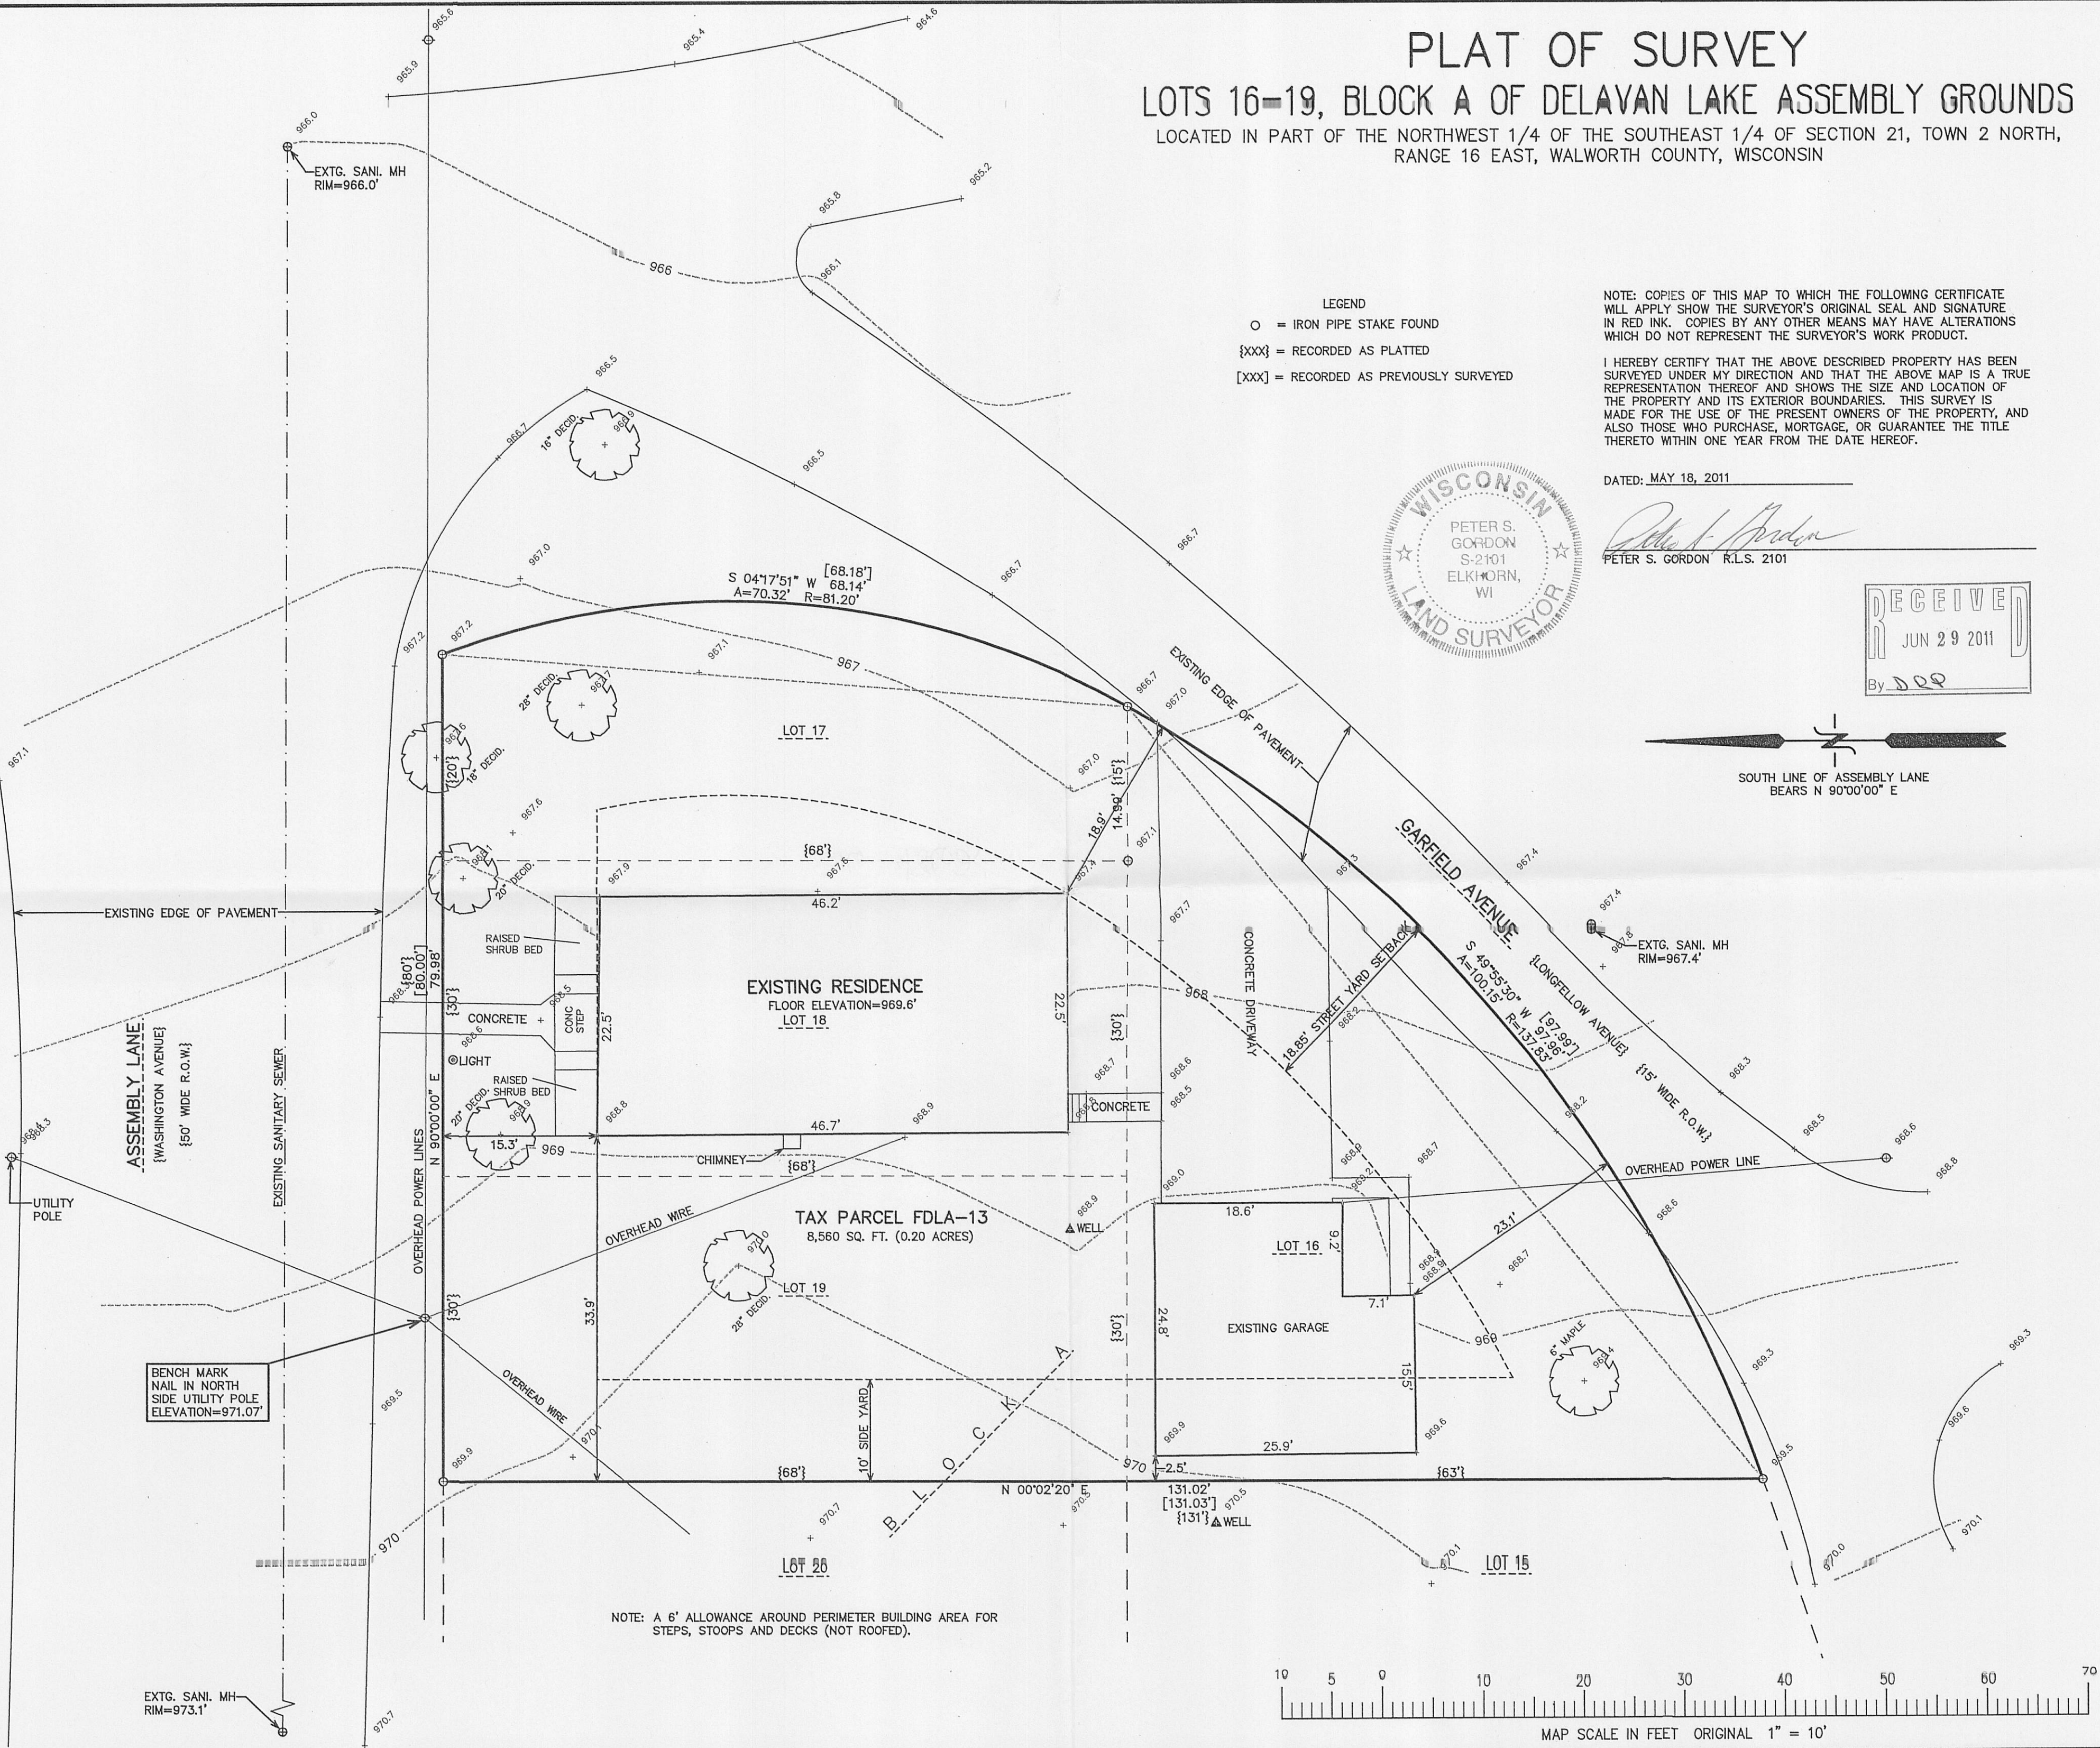

MAP SCALE IN FEET ORIGINAL 1" = 10'

WORK ORDERED BY -
DENNIS COGLAN
2330 WEST 108th PLACE
CHICAGO, IL 60645

FARRIS, HANSEN & ASSOCIATES, INC.
ENGINEERING - ARCHITECTURE - SURVEYING
7 RIDGWAY COURT P.O. BOX 437
ELKHORN, WISCONSIN 53121
OFFICE: (262) 723-2098 FAX: (262) 723-5886

REVISIONS
05-24-2011
CORRECT SIDE
YARD DIM.
(42.4 SB 33.9)
PSG

PROJECT NO.
8353
DATE:
5/18/2011
SHEET NO.
1 OF 1

FDLA-13

216-4862