
Sec 26 - 2 - 16 #177-66

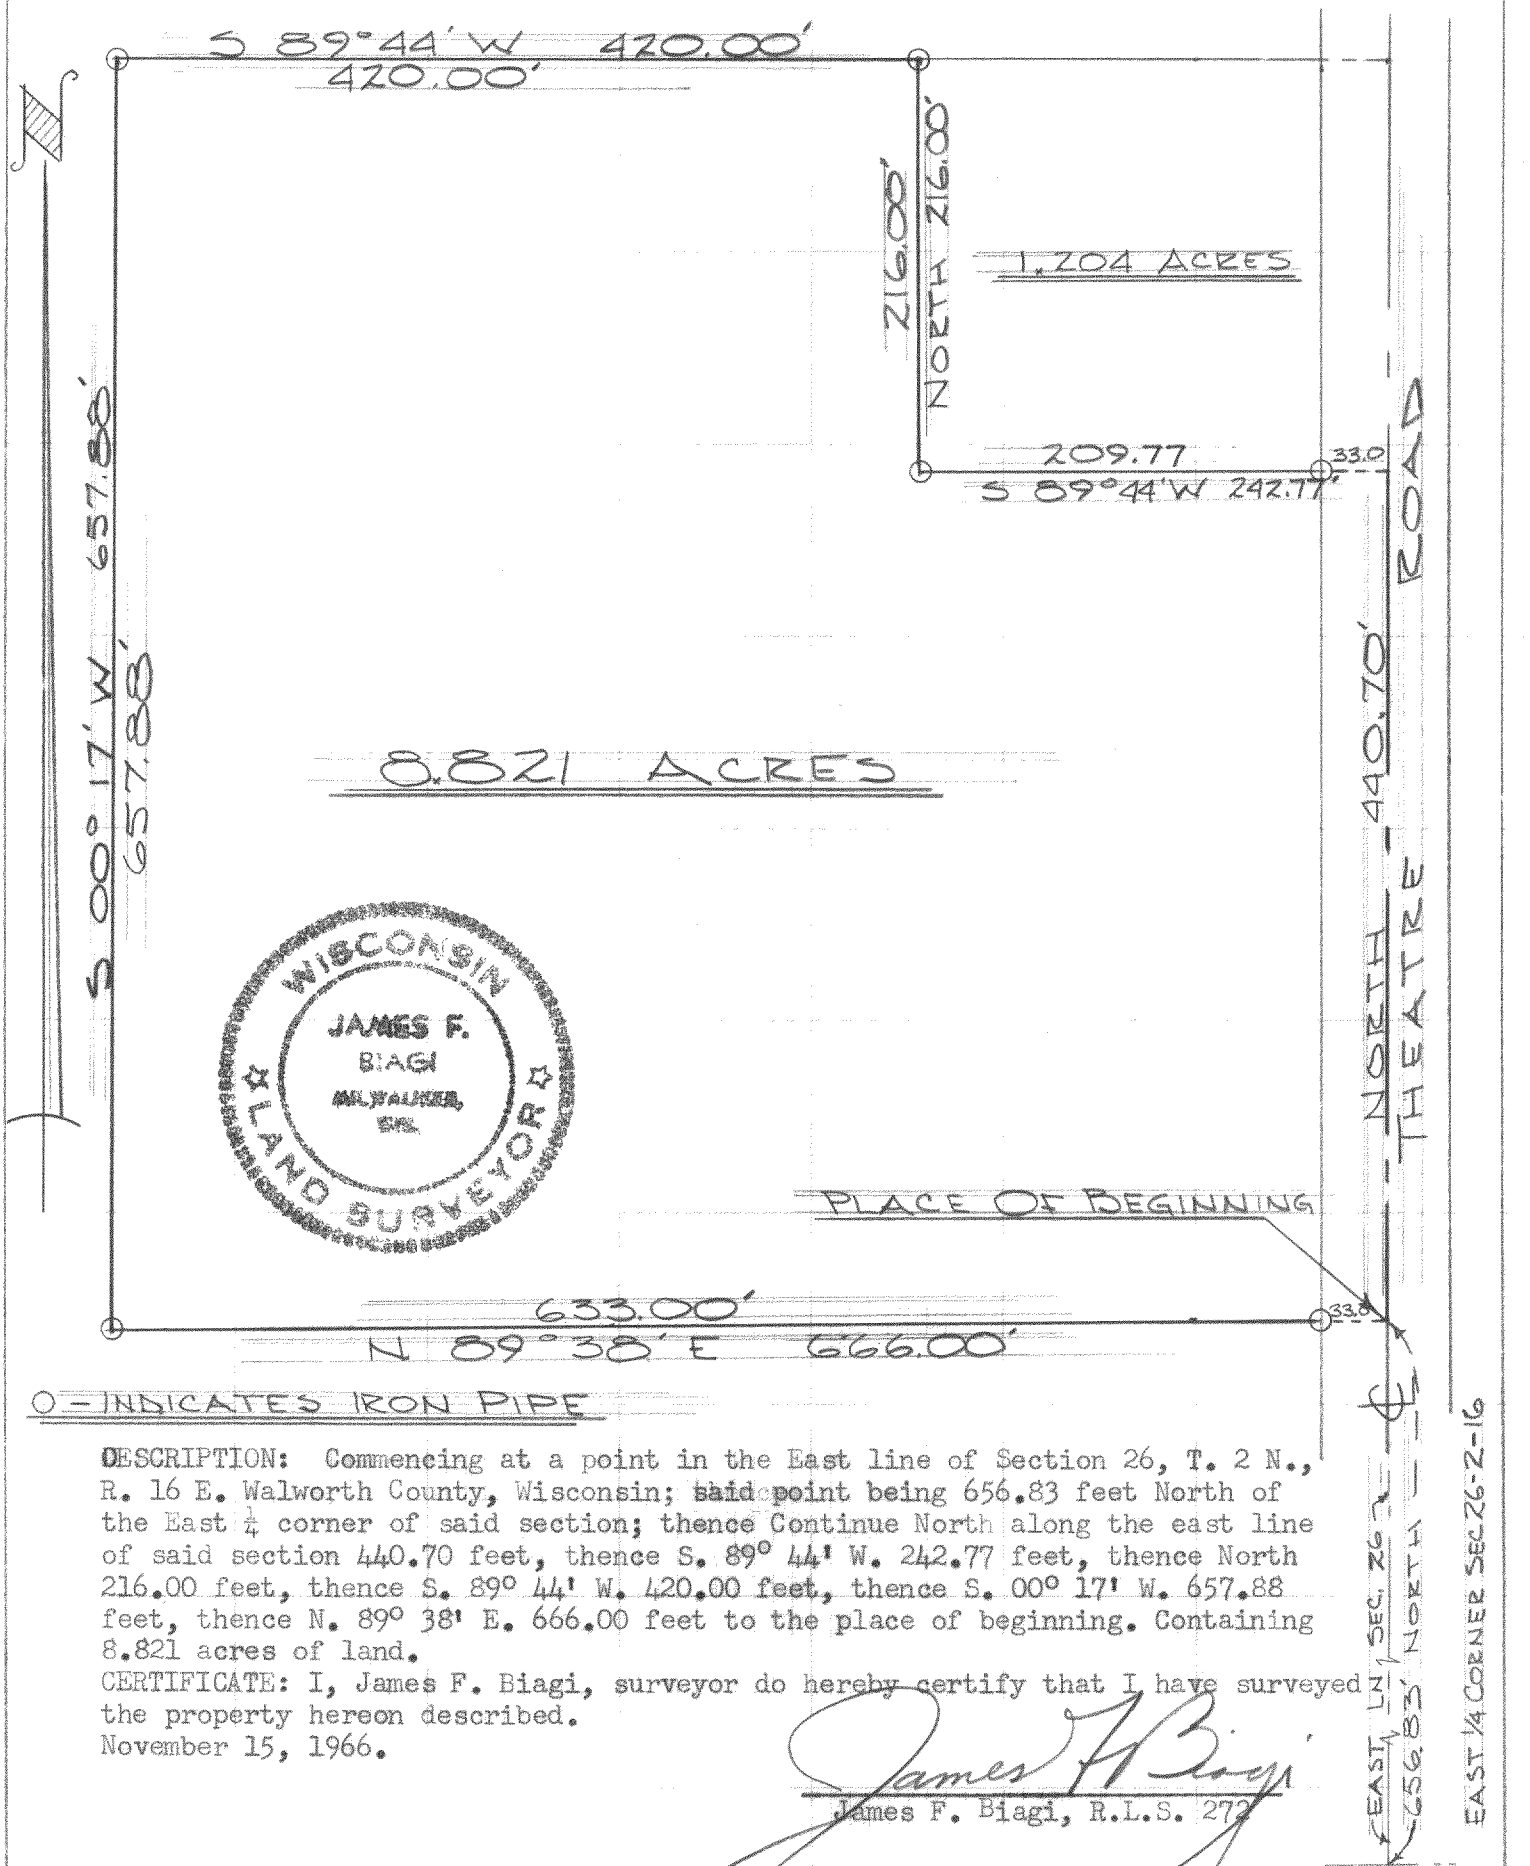

O - INDICATES IRON PIPE

DESCRIPTION: Commencing at a point in the East line of Section 26, T. 2 N., R. 16 E. Walworth County, Wisconsin; said point being 656.83 feet North of the East ¼ corner of said section; thence Continue North along the east line of said section 440.70 feet, thence S. 89° 44' W. 242.77 feet, thence North 216.00 feet, thence S. 89° 44' W. 420.00 feet, thence S. 00° 17' W. 657.88 feet, thence N. 89° 38' E. 666.00 feet to the place of beginning. Containing 8.821 acres of land.

CERTIFICATE: I, James F. Biagi, surveyor do hereby certify that I have surveyed the property hereon described.

November 15, 1966.

James F. Biagi

James F. Biagi, R.L.S. 272

D-26-5A

216-4813