

PLAT OF SURVEY


-OF-

LOT 12, BLOCK 1 INLET OAKS SUBDIVISION, LOCATED IN TOWN 2 NORTH,
RANGE 16 EAST, TOWN OF DELAVAN, WALWORTH COUNTY, WISCONSIN.

KROTT SURVEYING INC.

N3705 WILLOW BEND LANE
LAKE GENEVA WI. 53147
PHONE # (262)248-3697
FAX # (262)249-0639

PREPARED FOR
KAREN OSTERMEIER
KEEFE REAL ESTATE
1040 N WISCONSIN ST.
ELKHORN WI. 53121

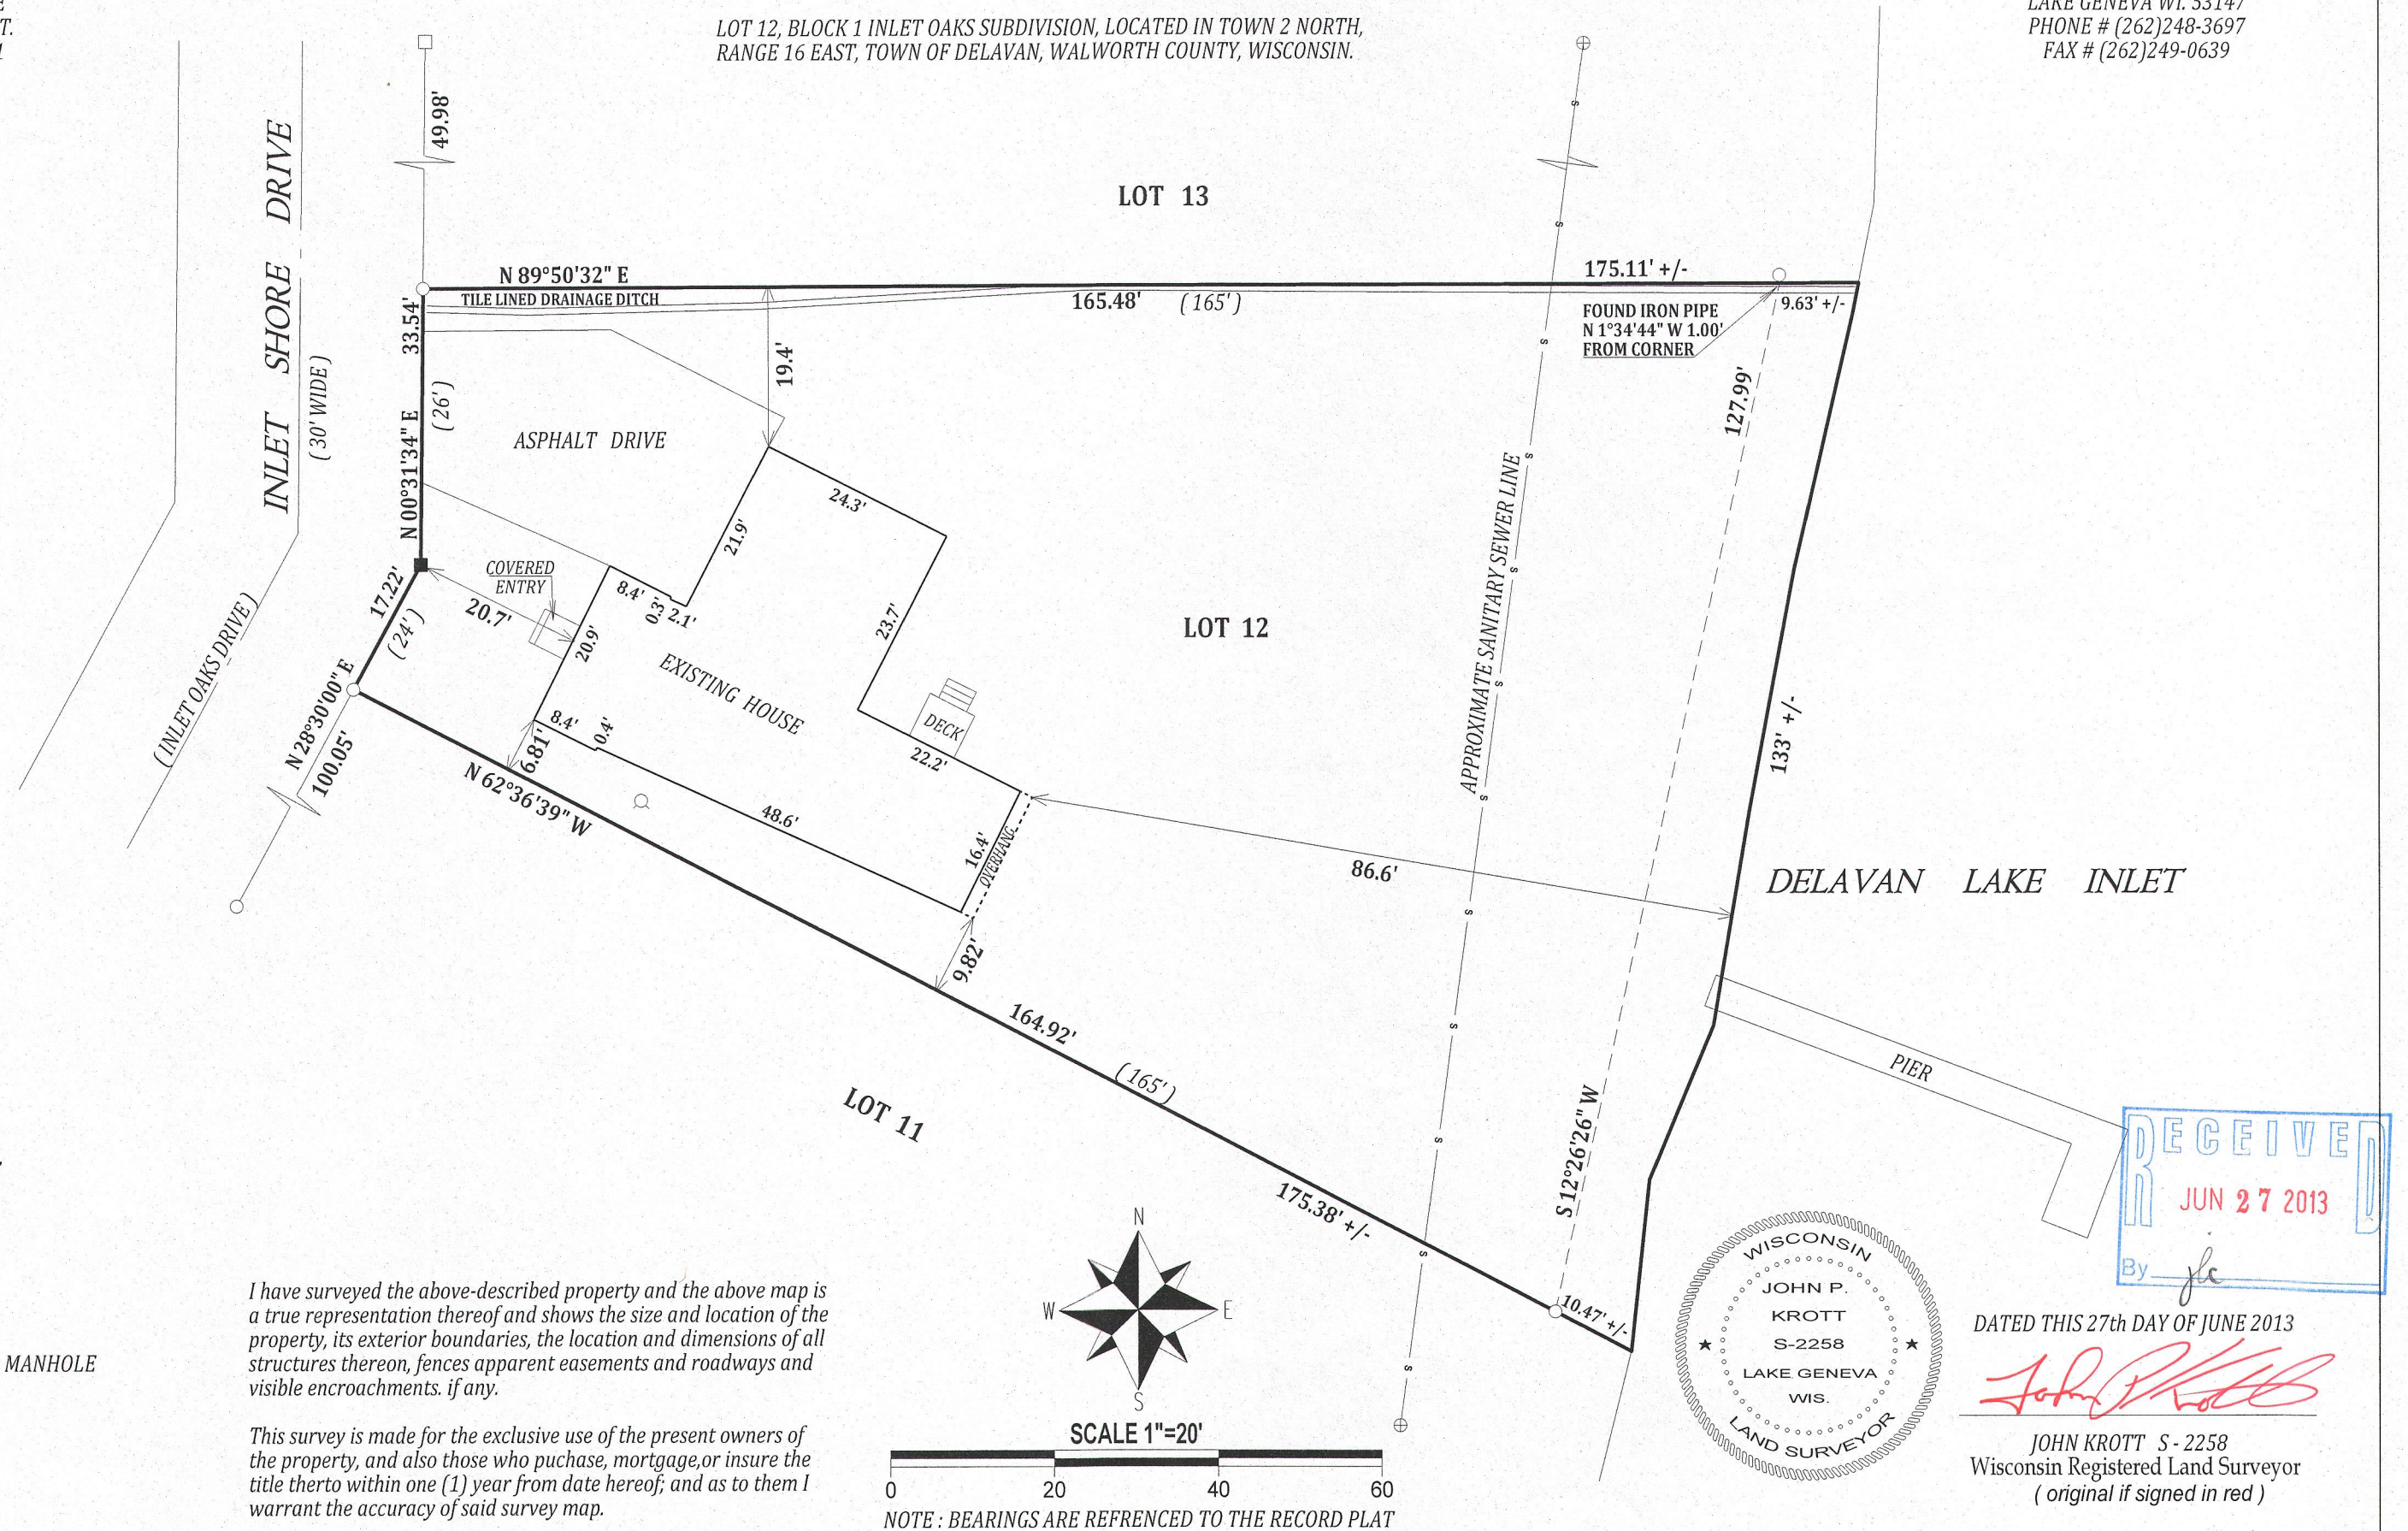

FIN-6

216-5030