


Plat of Survey

of


Lots 4 & 5 in Block P of Delavan Lake Assembly Grounds,

a subdivision located in the Southeast 1/4 of Section 21, Town 2 North, Range 16 East, Town of Delavan, Walworth County, Wisconsin.


Surveyed for:
Kilkenny Law Office
125 North 2nd Street
Delavan, Wisconsin. 53115

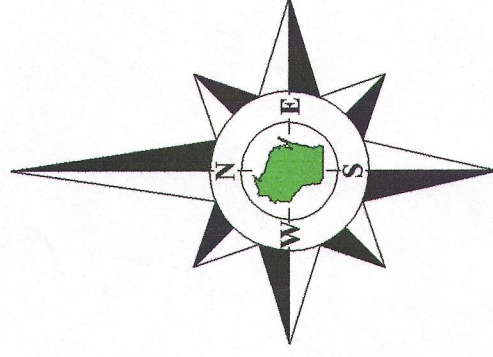

Bearings reference to the Wisconsin State Plane Coordinate System, South Zone.

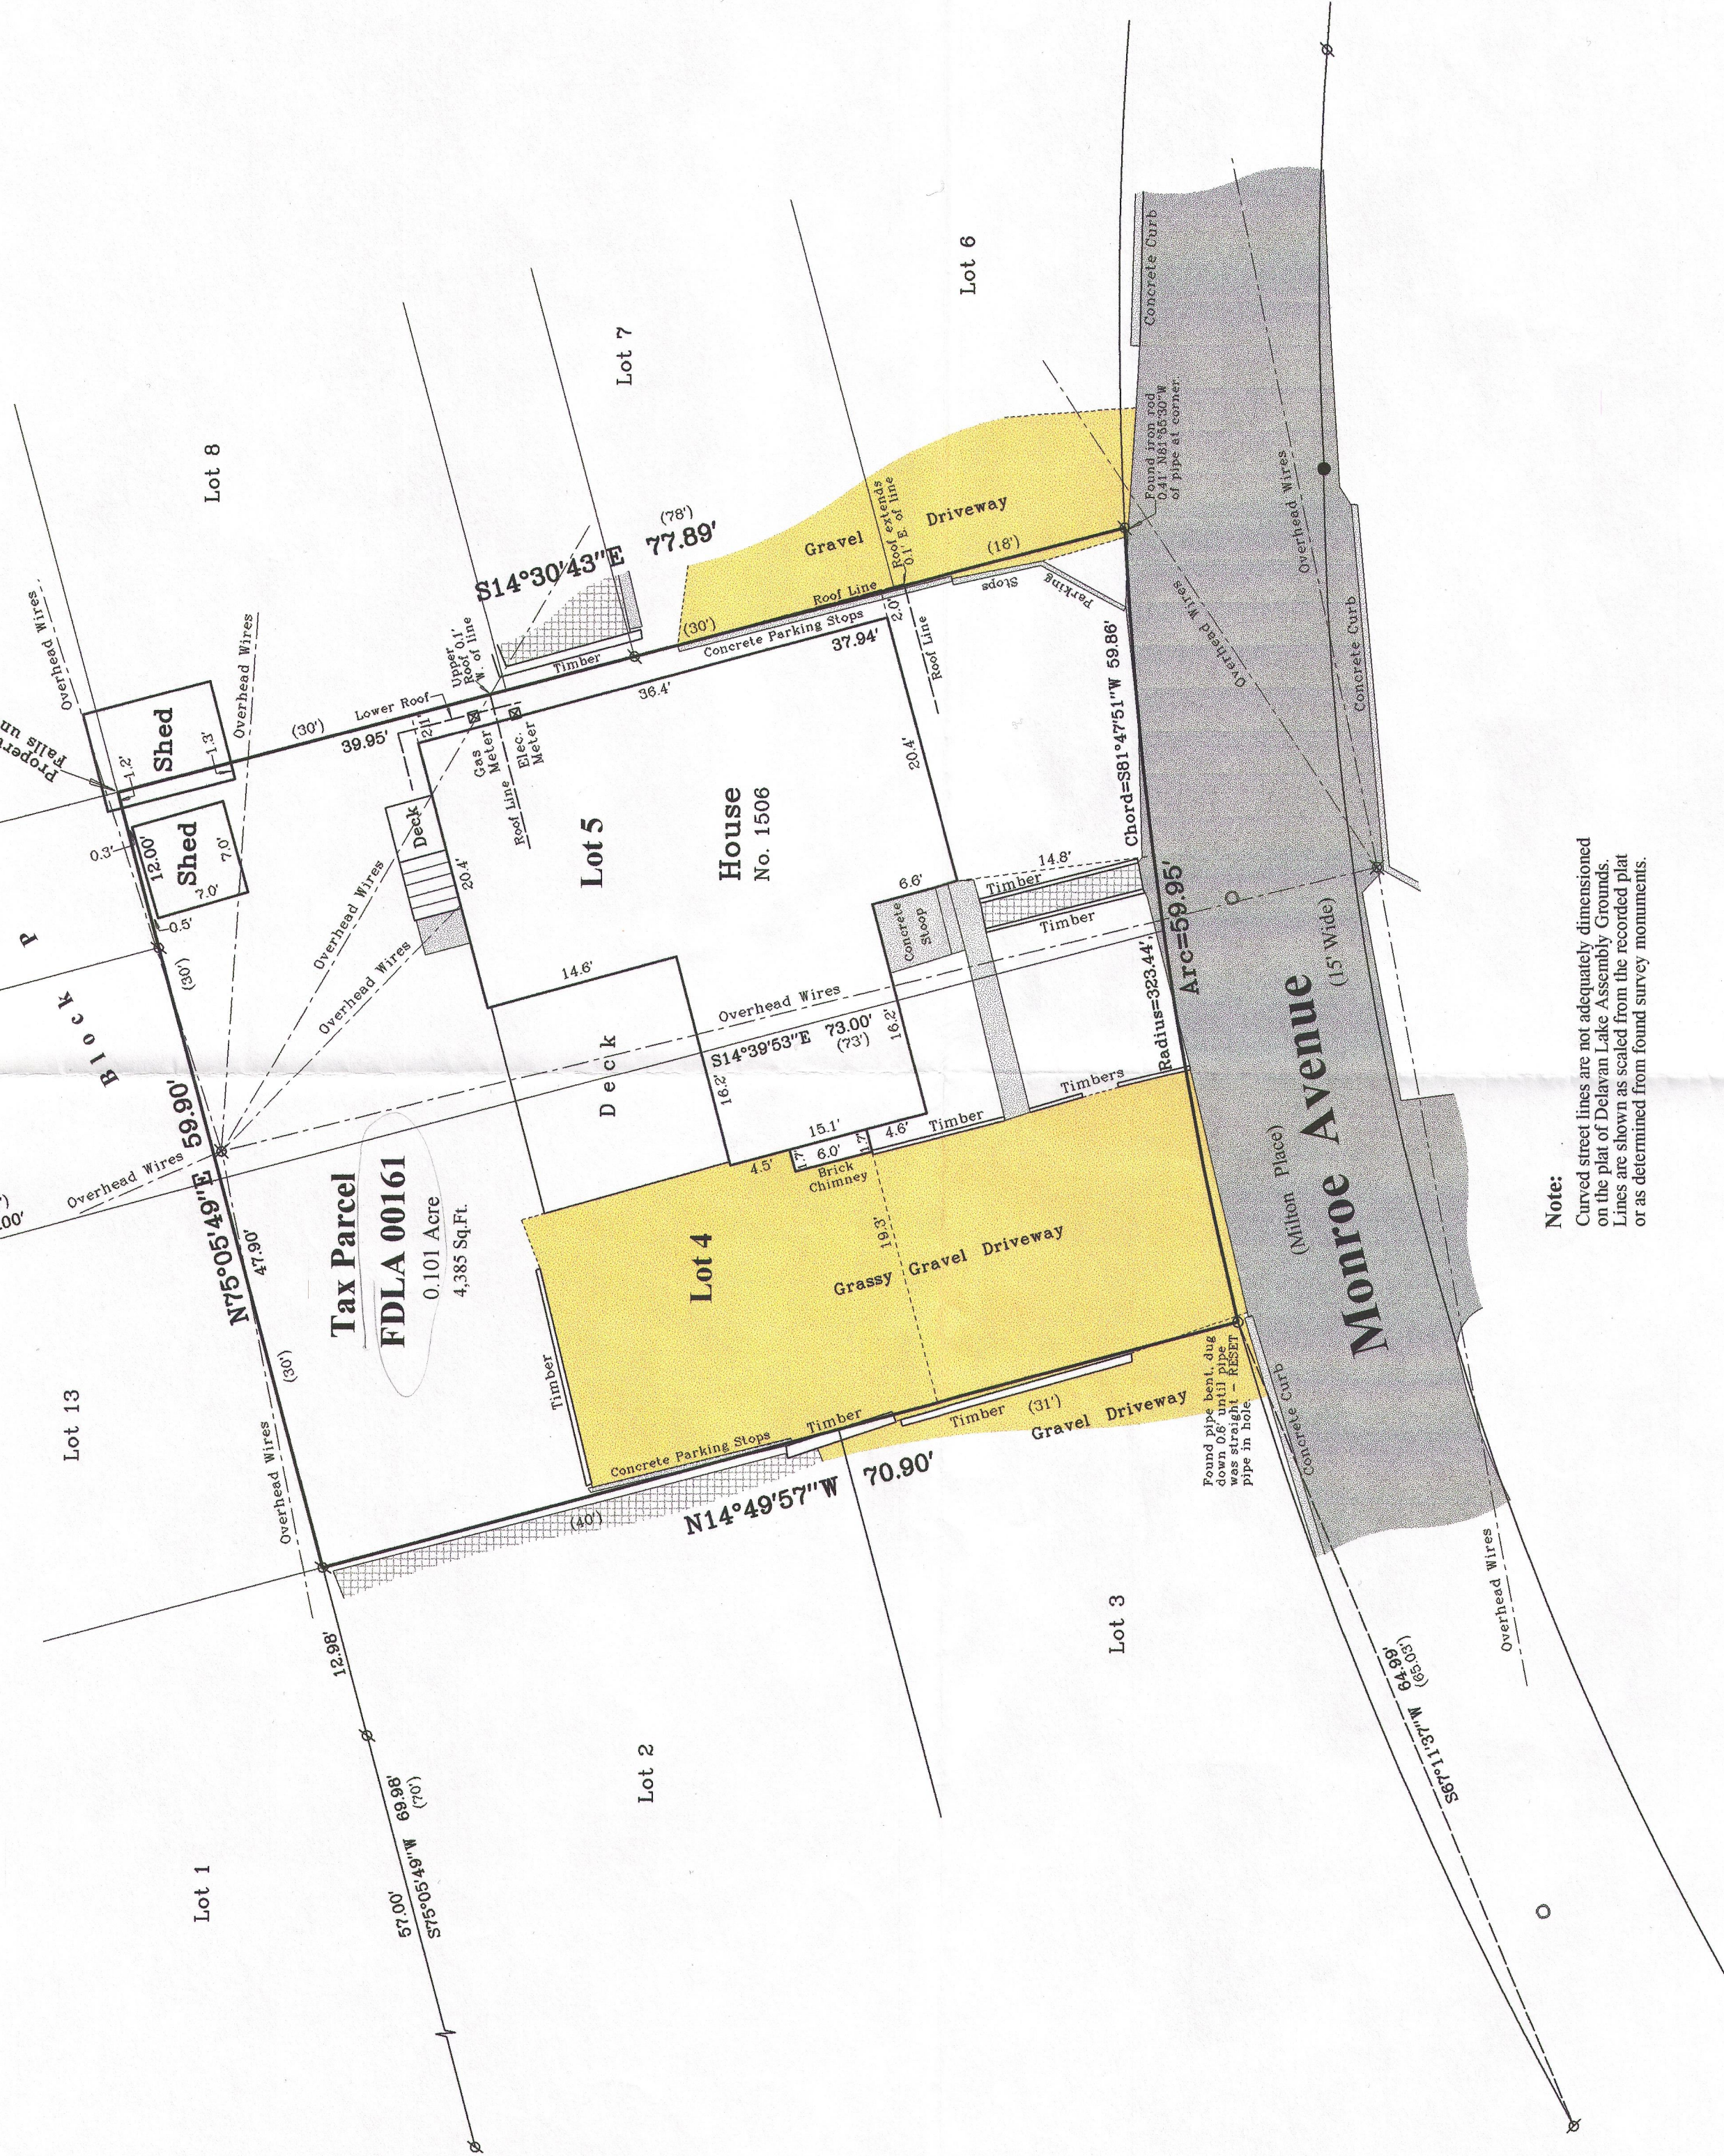

Note:
Curved street lines are not adequately dimensioned on the plat of Delavan Lake Assembly Grounds. Lines are shown as scaled from the recorded plat or as determined from found survey monuments.

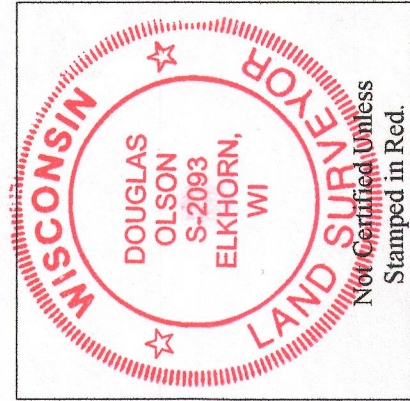

Notes:

- 1) This survey plat is not certified unless signed and sealed in red ink.
- 2) This survey is subject to Wisconsin lien laws. This Plat of Survey is the notice of intent to file lien. Lien waiver required.

Sheet 1 of 1 Sheets
Drawing Name: D:\16-2013-102-2013\102\Plat.dwg


Job Reference Number
2013.102

Legend
● Found Iron Pipe
○ Found Iron Rod
○ Set Iron Pipe, 1" dia.
() Recorded Information
x Utility Pole
□ Asphalt Surface
▨ Concrete
▩ Patio Blocks
▧ Gravel

Jensen & Olson Land Surveying, LLC

45 South Wisconsin Street * P.O. Box 322 * Elkhorn, Wisconsin. 53121
Telephone: (262) 723-3434 * Facsimile: (262) 723-8044
Email: jensen.olson@elknet.net

Survey Date: September 6, 2013
Revisions:

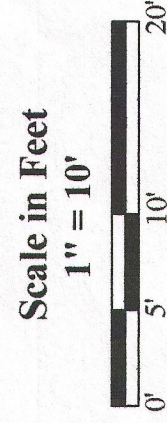

Copyright 2013 by Jensen & Olson Land Surveying, LLC.

All rights reserved. No part of this survey plat may be reproduced or transmitted in any form by any means - graphic, electronic, or mechanical, including photocopying, tracing, or information storage and retrieval systems - without permission in writing from Douglas G. Olson, Jensen & Olson Land Surveying, LLC.

I hereby certify that I have surveyed the above described property and the map hereon is correct to the best of my professional knowledge and belief and shows the size and location of the property, its exterior boundaries, the location and dimensions of all visible structures thereon, boundary fences, apparent easements and roadways and visible encroachments, if any.

This survey is made for the exclusive use of the present owners of the property, and also those who purchase, mortgage or guarantee title thereto, within one year from the date hereof.

Douglas G. Olson
Wisconsin Registered Land Surveyor - 2093

2013.102