Plat of Survey

of

Lots 8, 9, 10, 11 & 12, excepting the West 17 feet thereof, in Block 2 of Delavan Lake-View Crest,

a subdivision located in the Northwest 1/4 of Section 31, Town 2 North, Range 16 East, Town of Delavan, Walworth County, Wisconsin.

Surveyed for: **Gary & Sandy Lenz**
3586 North Shore Drive
Delavan, Wisconsin. 53115

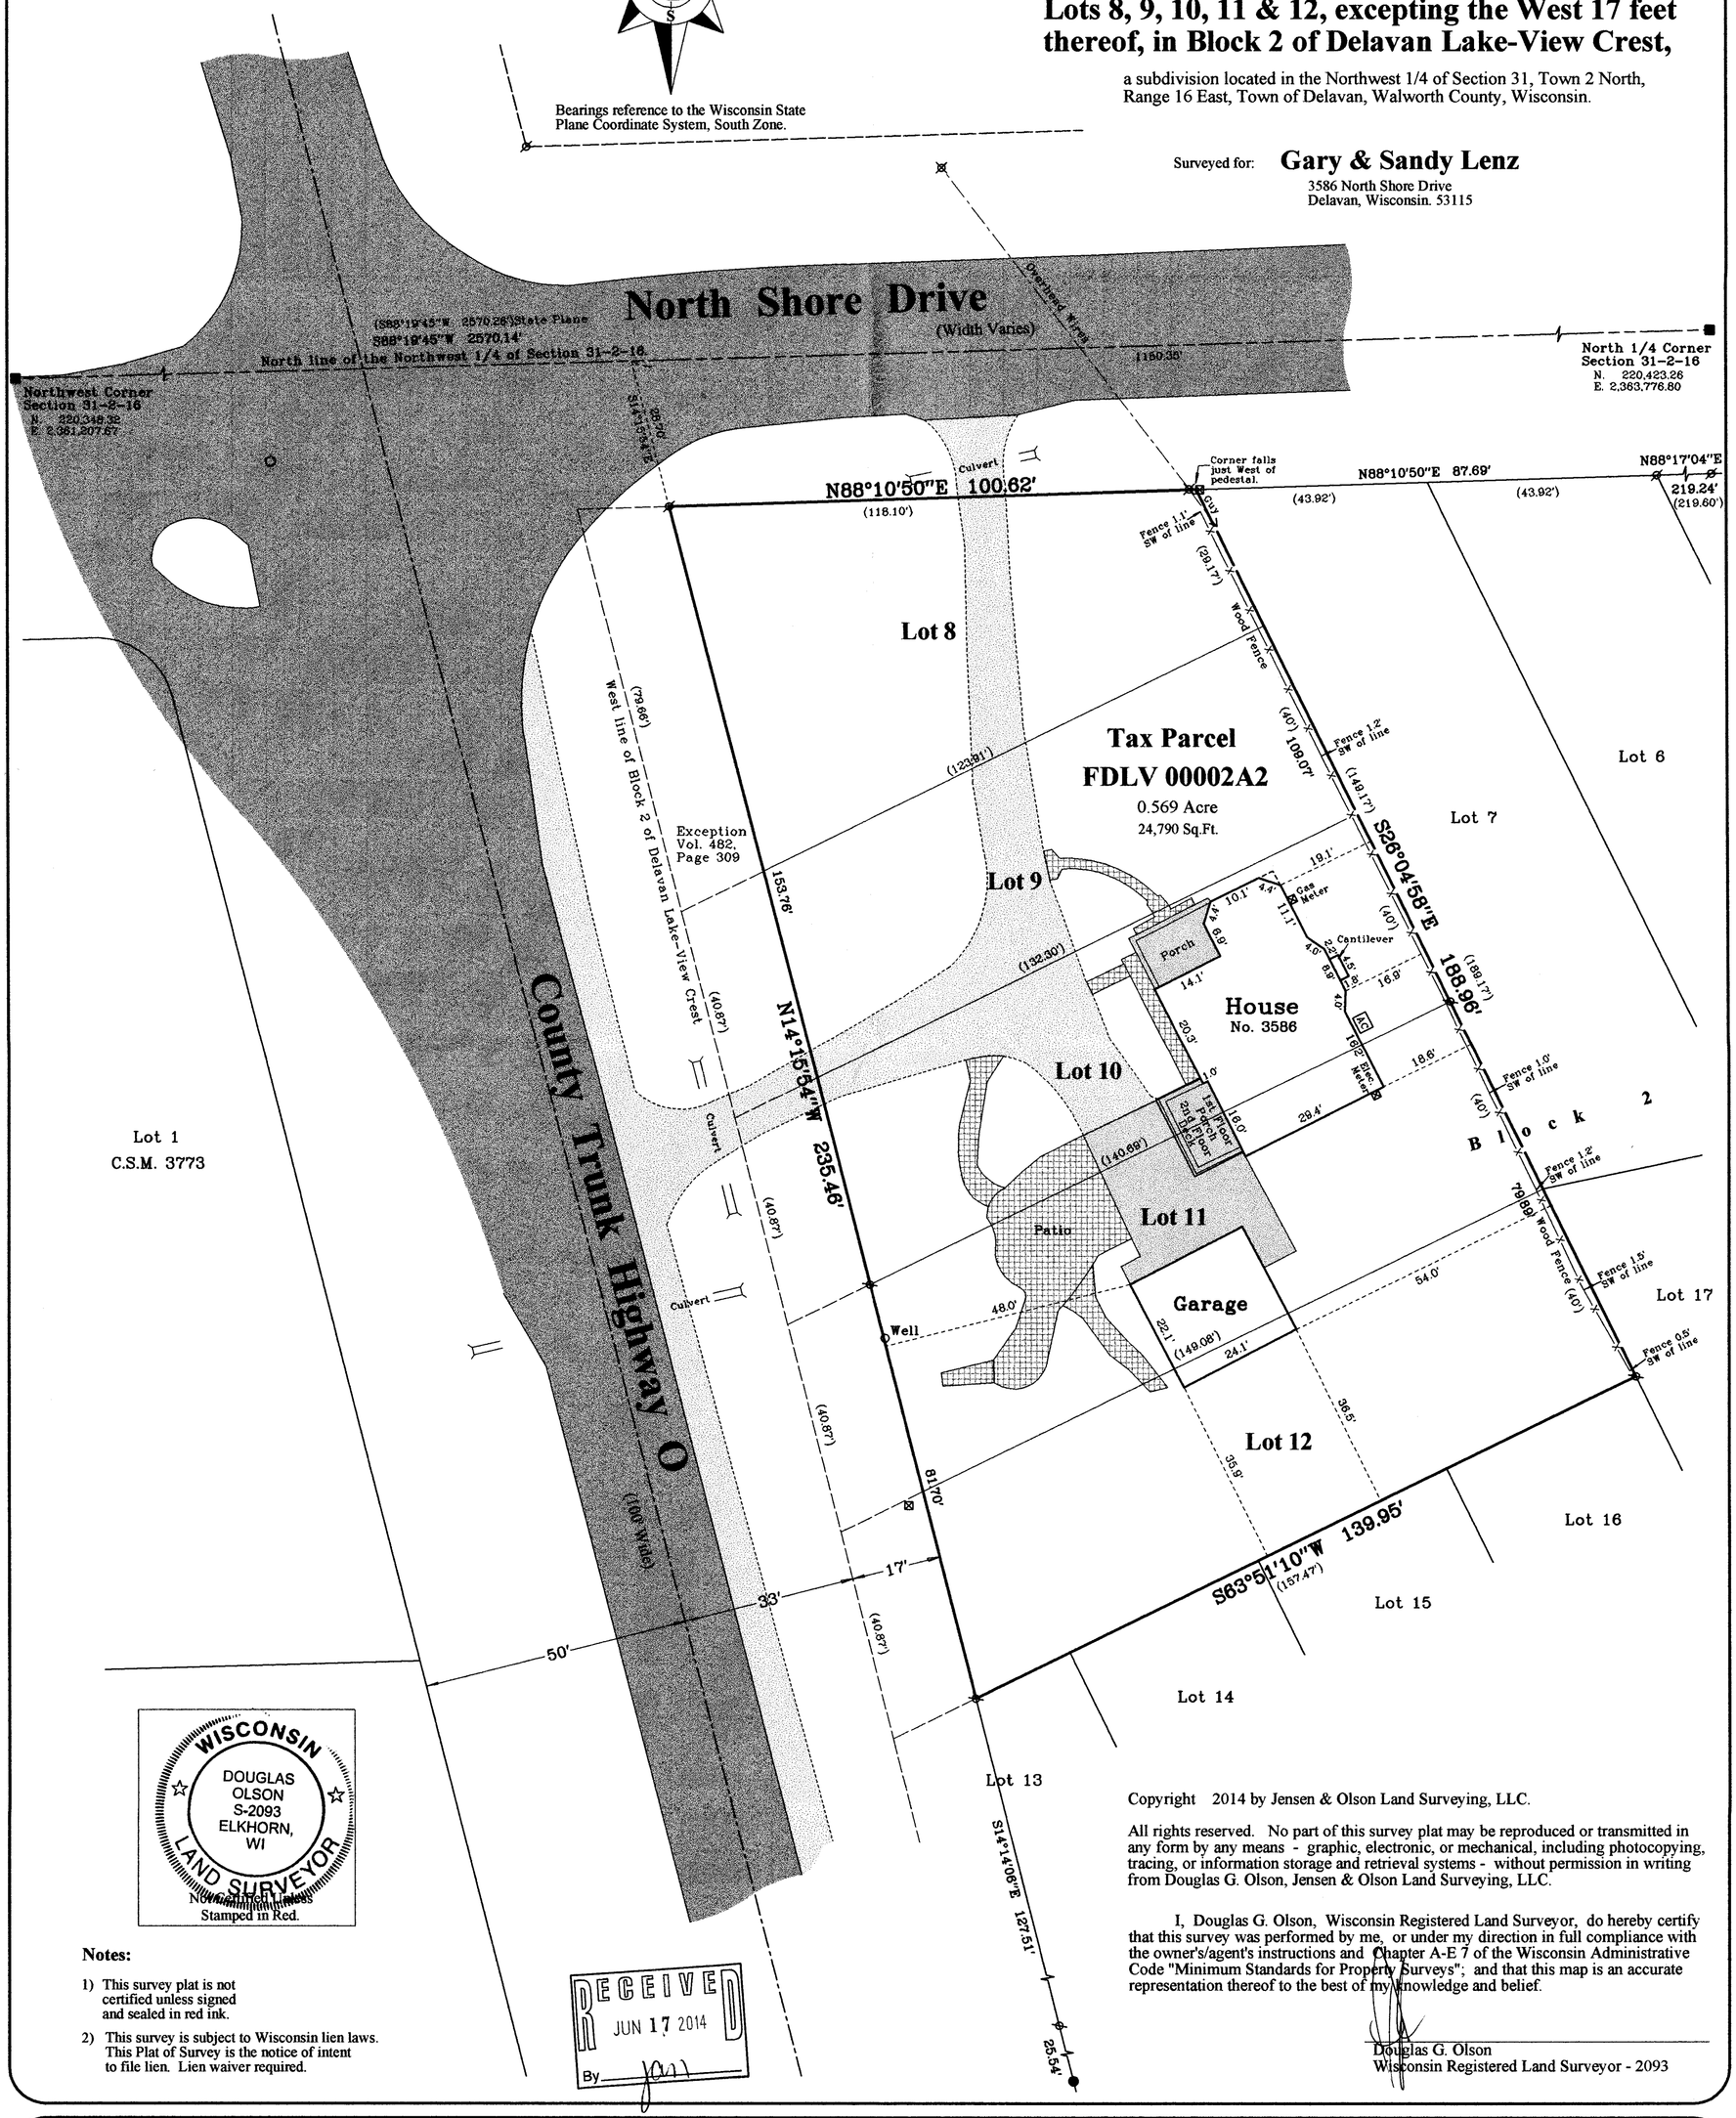

WISCONSIN LAND SURVEYOR
DOUGLAS OLSON
S-2093
ELKHORN, WI


Notes:

1) This survey plat is not certified unless signed and sealed in red ink.

2) This survey is subject to Wisconsin lien laws. This Plat of Survey is the notice of intent to file lien. Lien waiver required.

RECEIVED
JUN 17 2014
By

Copyright 2014 by Jensen & Olson Land Surveying, LLC.

All rights reserved. No part of this survey plat may be reproduced or transmitted in any form by any means - graphic, electronic, or mechanical, including photocopying, tracing, or information storage and retrieval systems - without permission in writing from Douglas G. Olson, Jensen & Olson Land Surveying, LLC.

I, Douglas G. Olson, Wisconsin Registered Land Surveyor, do hereby certify that this survey was performed by me, or under my direction in full compliance with the owner's/agent's instructions and Chapter A-E 7 of the Wisconsin Administrative Code "Minimum Standards for Property Surveys"; and that this map is an accurate representation thereof to the best of my knowledge and belief.

Douglas G. Olson
Wisconsin Registered Land Surveyor - 2093

2014.046

Sheet 1 of 1 Sheets

Drawing Name: t2nr16e-2014046-2014046Plat.scj

Job Reference Number
2014.046

Legend
- Found County Section Corner
- Found Iron Pipe
- Found Iron Rod
- ( ) Recorded Information
- Utility Pole
- Manhole
- Utility Pedestal
- Asphalt Surface
- Concrete Surface
- Gravel Surface
- Brick Pavers, Stone, or Patio Blocks

Jensen & Olson Land Surveying, LLC
45 South Wisconsin Street * P.O. Box 322 * Elkhorn, Wisconsin. 53121
Telephone: (262) 723-3434 * Facsimile: (262) 723-8044
Email: jensen.olson@elknet.net

Scale in Feet
1" = 20'
0' 10' 20' 40'

Survey Date: May 19, 2014.
Revisions:

FdLV -2A2 216-5100