


PREPARED FOR
JERRY KROUPA
KEEFE REAL ESTATE
ELKHORN WI.

PLAT OF SURVEY

- OF -

LOT 4 OF CERTIFIED SURVEY MAP No. 955, LOCATED IN THE NORTHEAST
1/4 OF THE SOUTHEAST 1/4 OF SECTION 3, TOWN 2 NORTH, RANGE 16 EAST, TOWN
OF DELAVAN, WALWORTH COUNTY, WISCONSIN.


PATHFINDER SURVEYING INC.
(formerly)
J.K. SURVEYING INC.
P.O. BOX 322
LAKE GENEVA, WI. 53147
WWW.PATHFINDERSURVEYING.NET
262-248-8303

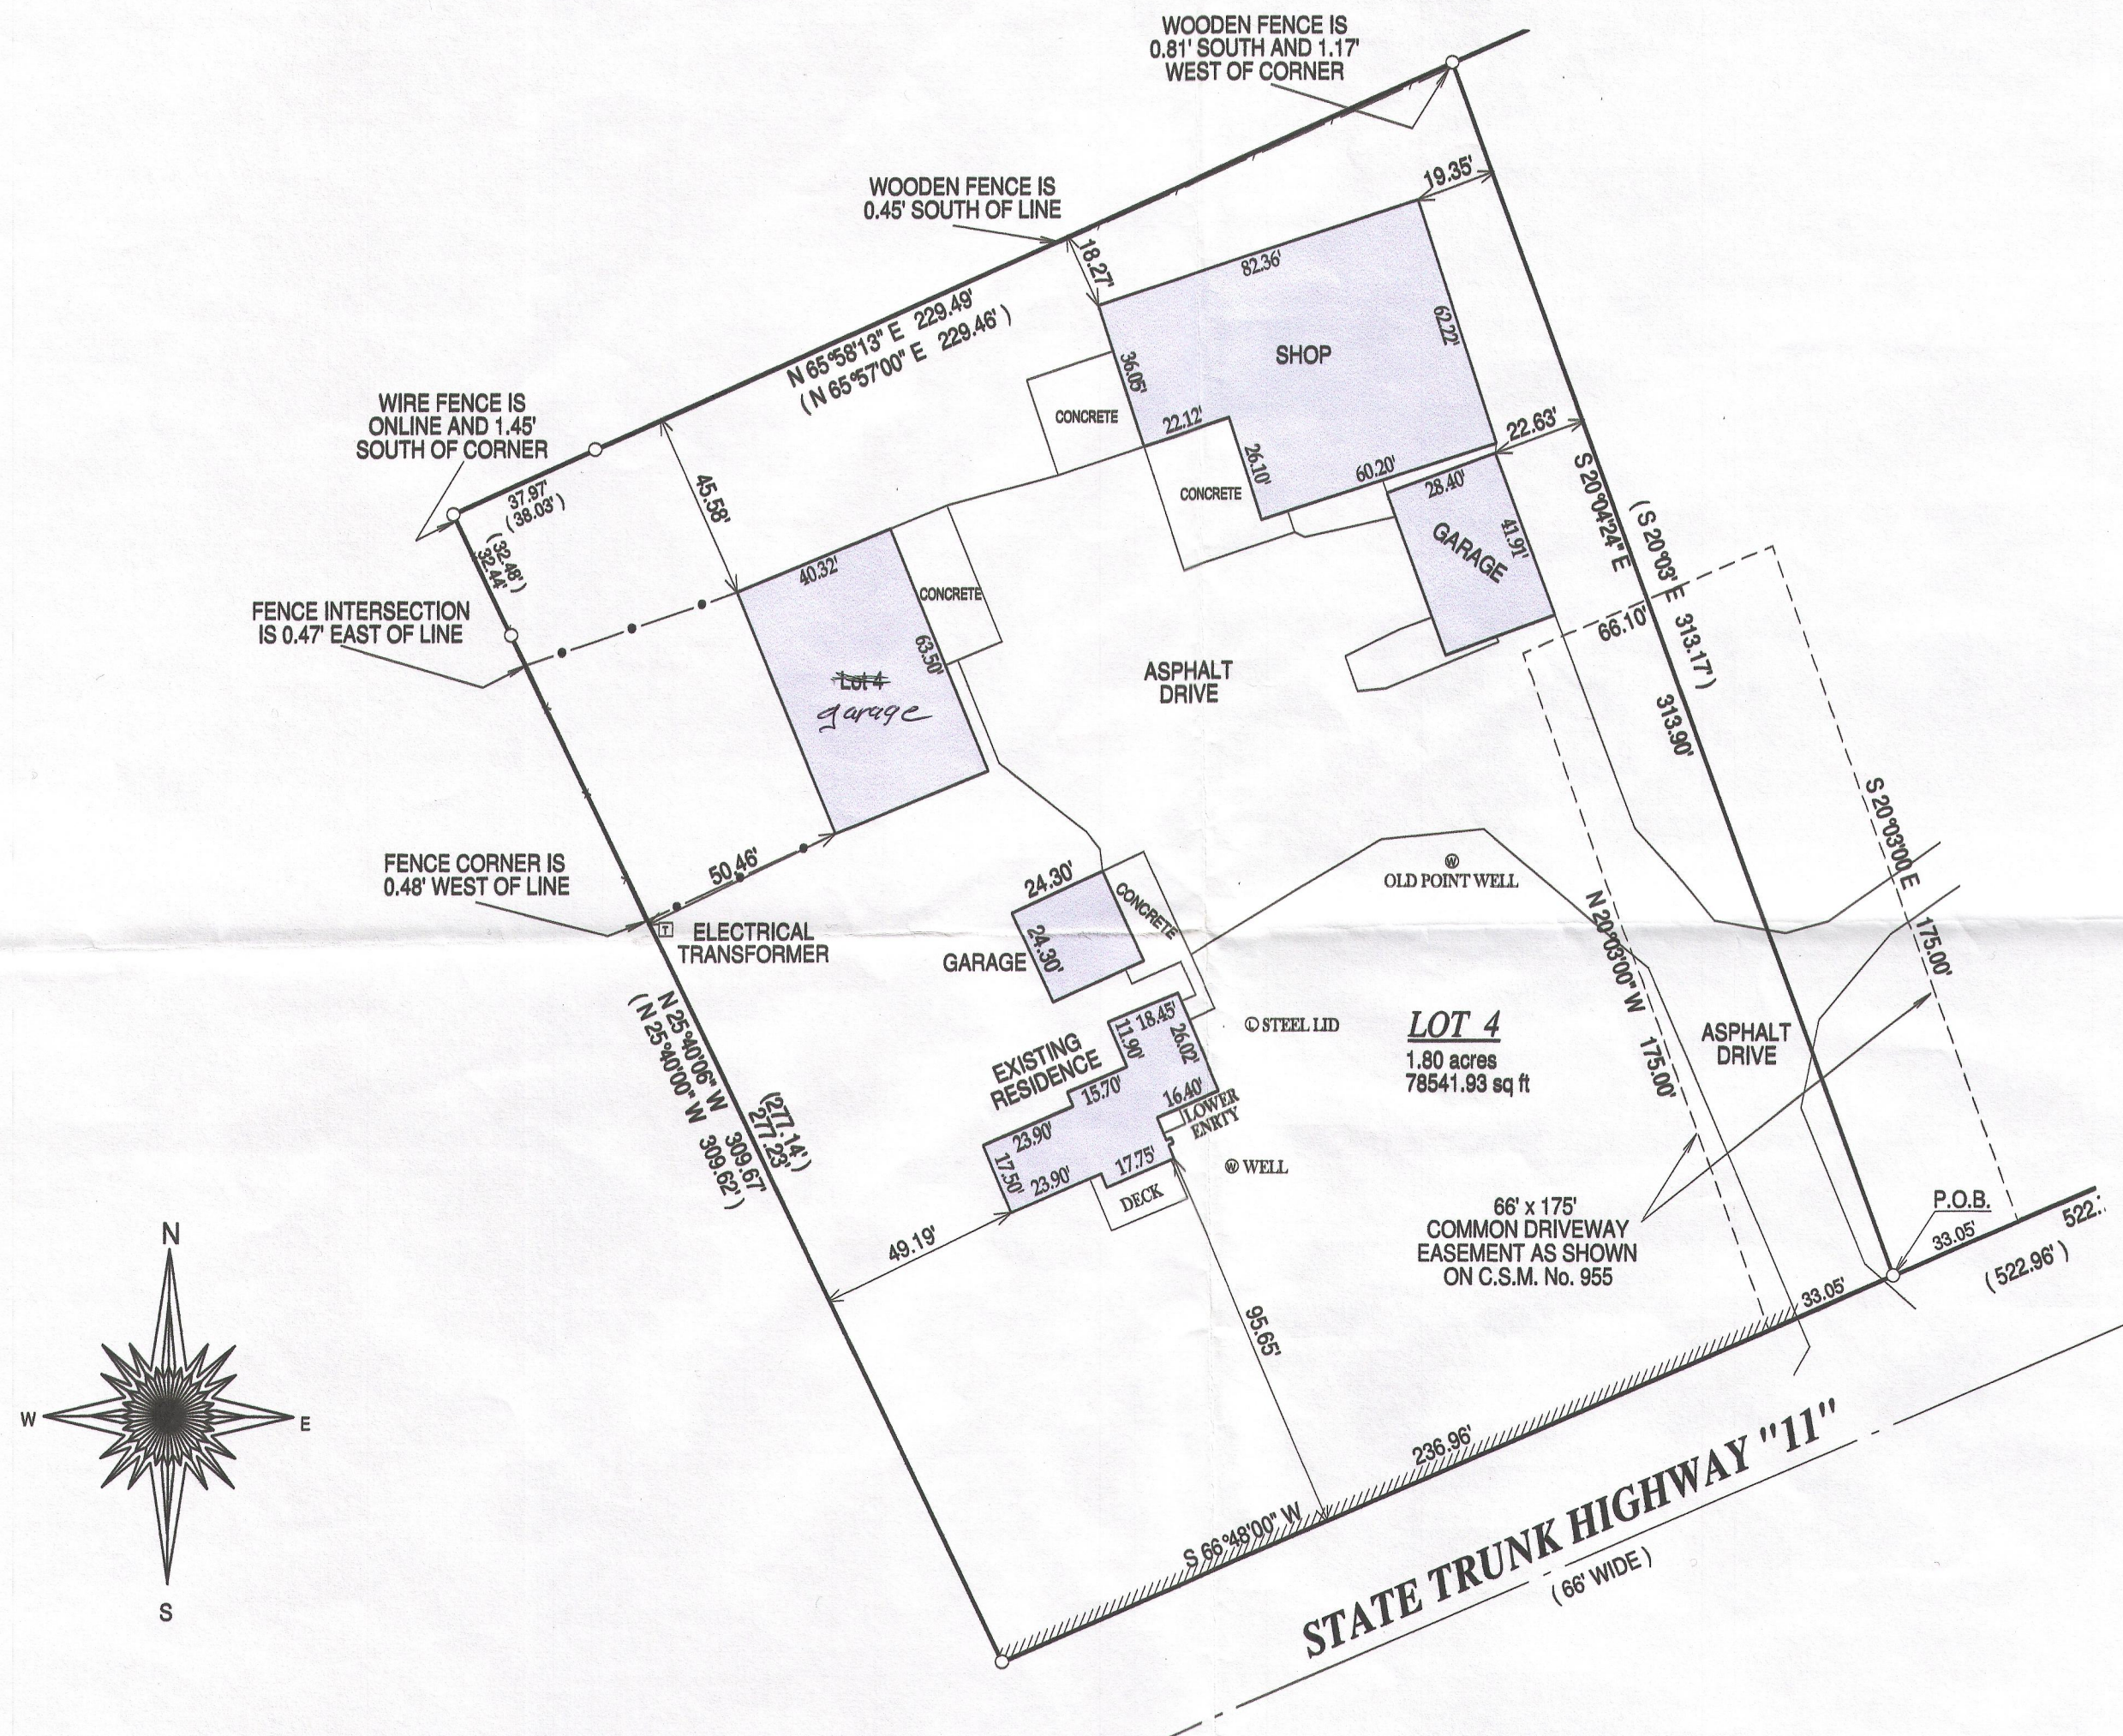

- = WIRE FENCE
 - - - = CHAINLINK FENCE
 - () = RECORDED AS
 - = FOUND IRON BAR
 - = FOUND IRON PIPE
 - = SET IRON BAR
 - = SET IRON PIPE
- SCALE: 1" = 40'



JOB #: 14-282

TAX ID #: FA 95500004

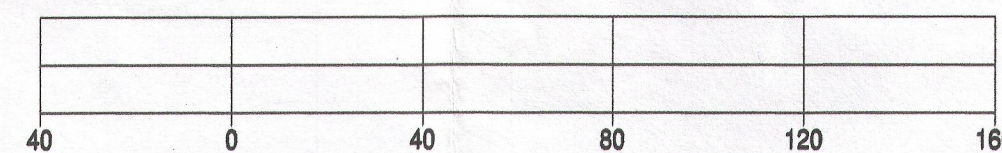

NOTE: BASIS OF BEARING IS C.S.M. OF RECORD.

"I hereby certify that I have surveyed the above described property and that the above map, to the best of my knowledge and belief, is a true representation thereof and shows the size and location of all visible structures, apparent easements and encroachments if any." This survey is made for the present owners of the property, and those who purchase, mortgage, or guarantee the title thereto, within one year from the date hereof.

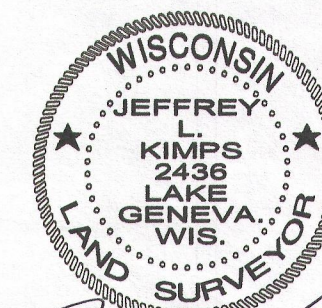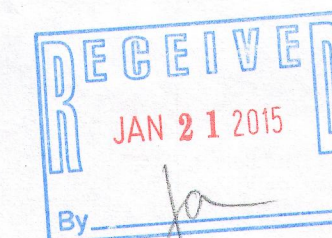

JEFFREY L. KIMPS S. 2436
Wisconsin Registered Land Surveyor
(original if signed in red)

DATED THIS 17TH DAY OF NOVEMBER, 2014.

FA 955-4

216-5165