

PLAT OF SURVEY

LOT 3, LAKEWOOD ESTATES SUBDIVISION, LOCATED IN THE SOUTHWEST 1/4 OF SECTION 21, TOWN 2 NORTH, RANGE 16 EAST, DELAVAN TOWNSHIP, WALWORTH COUNTY, WISCONSIN.

OWNER:
MARSHA OBERRIEDER TRUST
275 NOBLE CIRCLE
VERNON HILLS, IL 60061


SITE ADDRESS:
1770 LAKE TRAIL DRIVE
DELAVAN, WI 53115

ZONING: R-2A

LOT 4

LOT 3
25,680 SQ. FT.

LOT 2

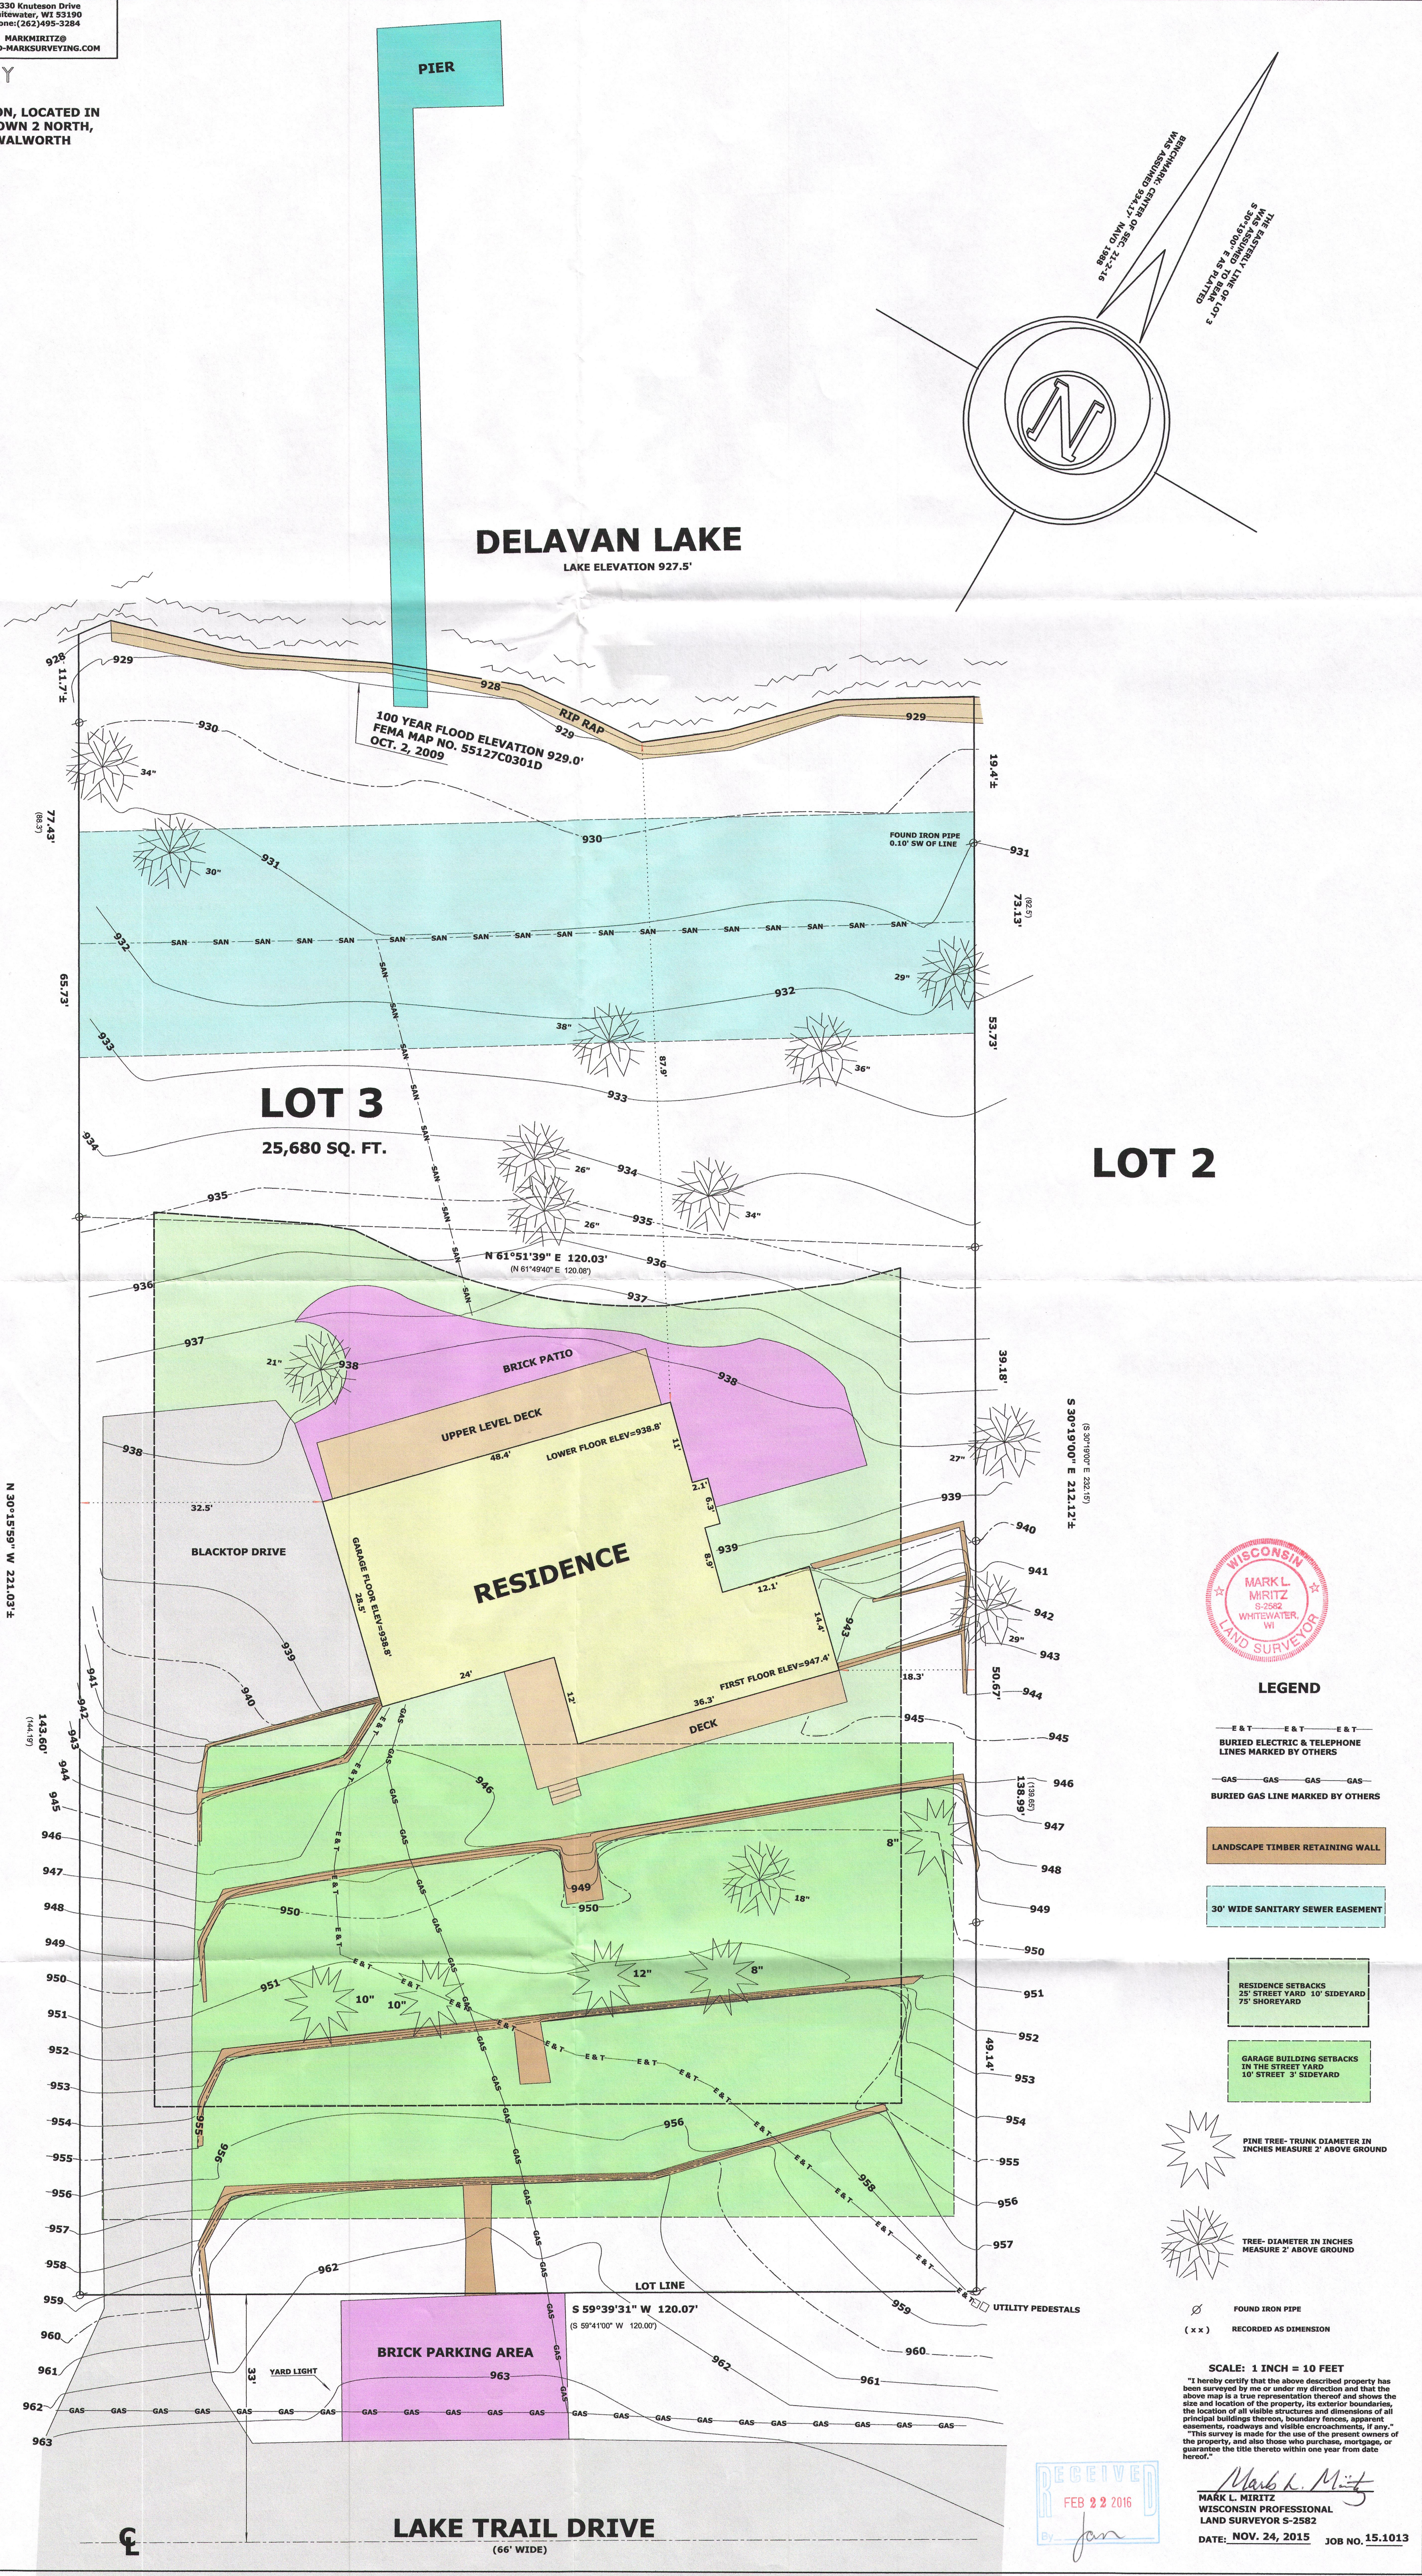

FILE-3 216-5269