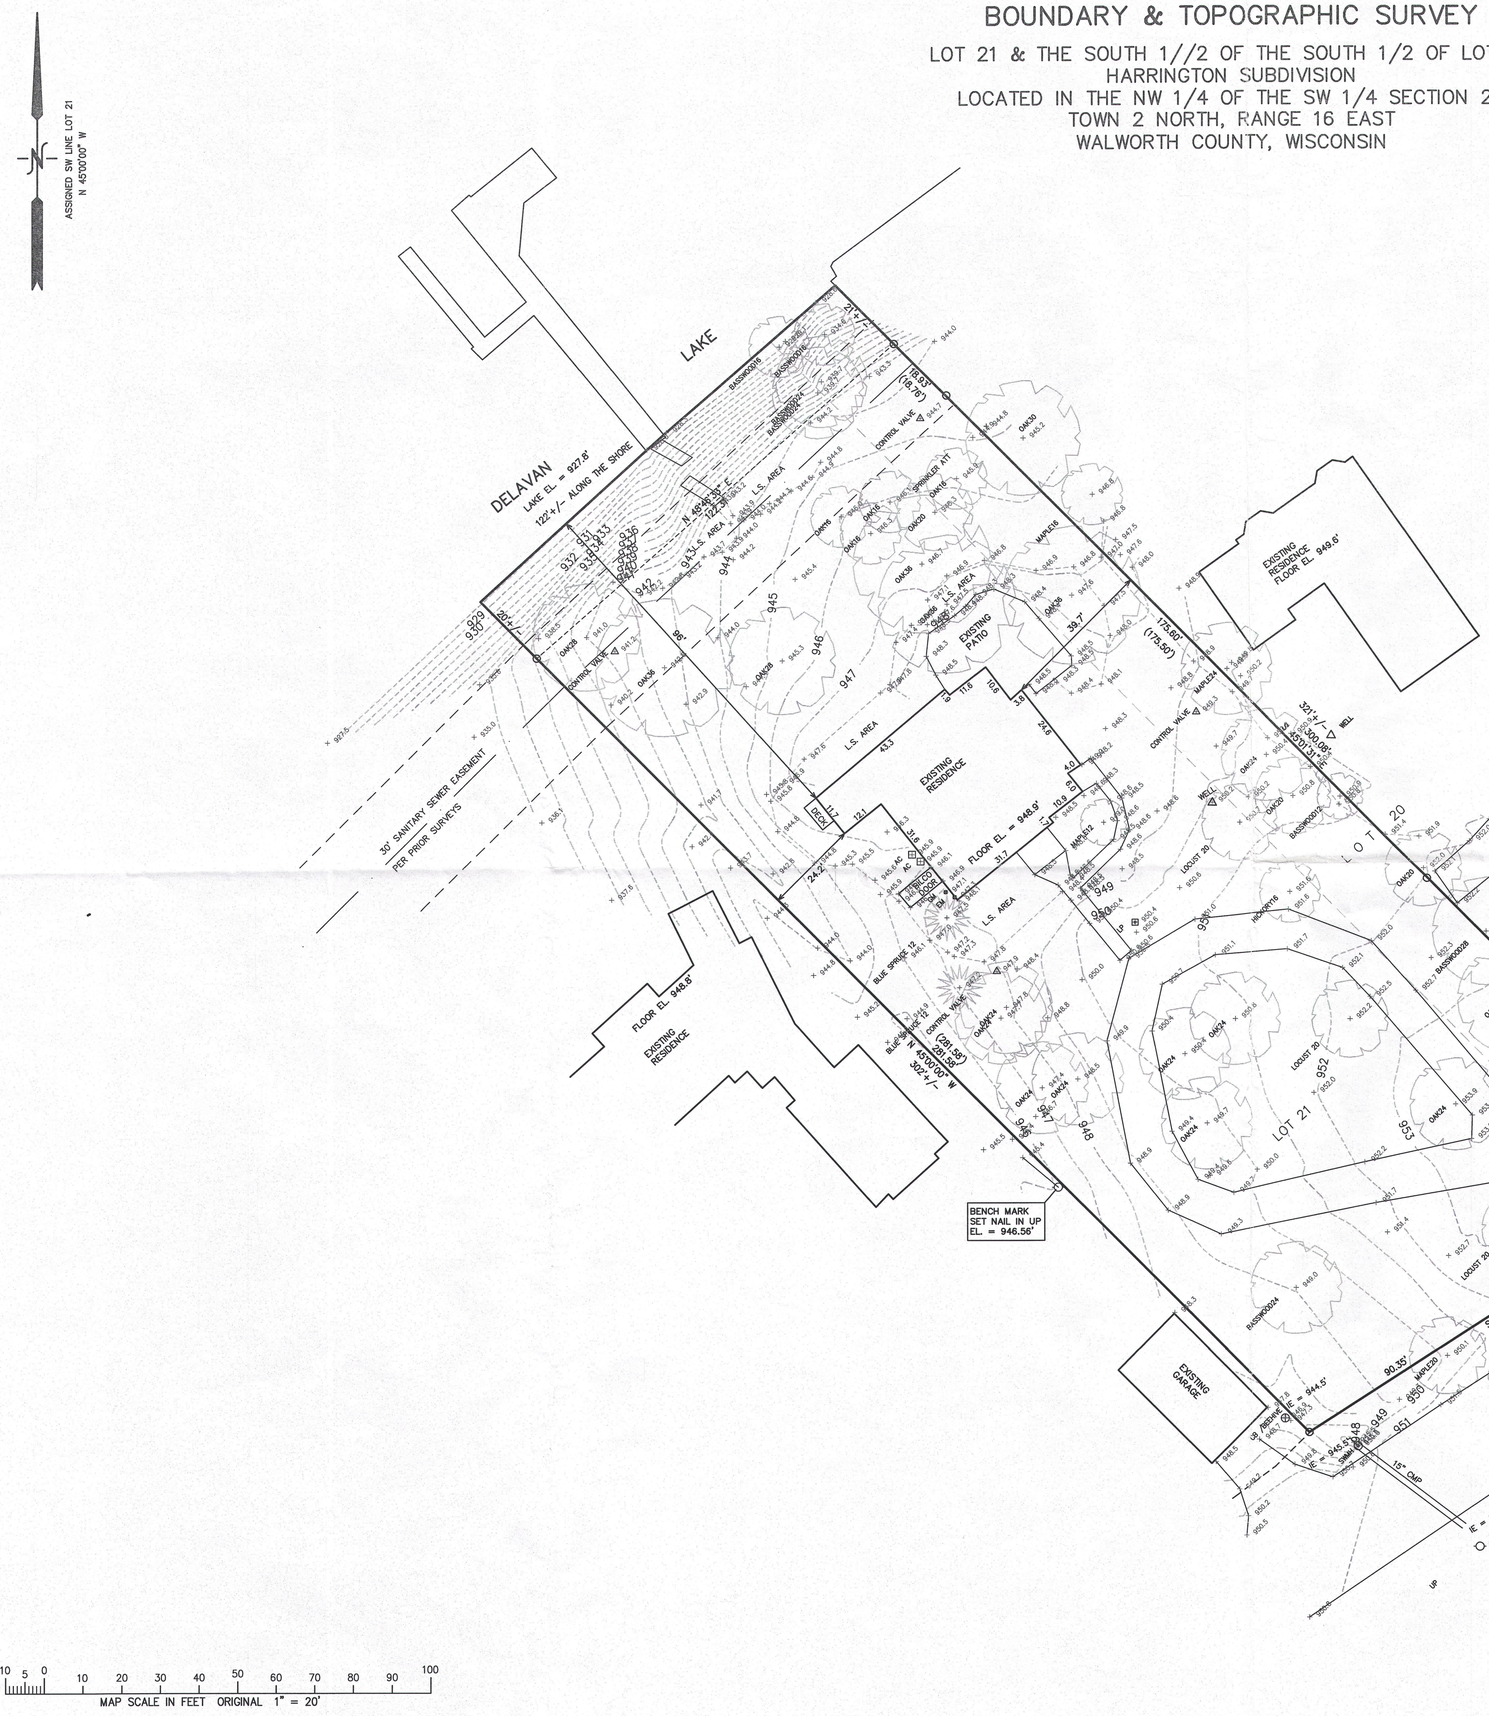
BOUNDARY & TOPOGRAPHIC SURVEY

LOT 21 & THE SOUTH 1//2 OF THE SOUTH 1/2 OF LOT 20
HARRINGTON SUBDIVISION
LOCATED IN THE NW 1/4 OF THE SW 1/4 SECTION 27
TOWN 2 NORTH, RANGE 16 EAST
WALWORTH COUNTY, WISCONSIN


ASSIGNED SW LINE LOT 21
N 45°00'00" W
LAKE
DELAVAN
LAKE EL. = 927.8'
122'+/- ALONG THE SHORE
N 48°46'39" E
122.39'
L.S. AREA
L.S. AREA
L.S. AREA