

DELAVAN, WALWORTH COUNTY, WISCONSIN

- WORK ORDERED BY -
SUNSET CONDOMINIUM ASSOCIATION


FARRIS, HANSEN & ASSOCIATES, INC.
ENGINEERING - ARCHITECTURE - SURVEYING
7 RIDGWAY COURT P.O. BOX 437
ELKHORN, WISCONSIN 53121
OFFICE: (262) 723-2098 FAX: (262) 723-5686

REVISIONS
06/20/2017
UPDATE BY LB

PROJECT NO.
9776
DATE
06/13/2017
SHEET NO.
1 OF 1

PLAT OF SURVEY SUNSET CONDOMINIUM OF DELAVAN LAKE

LOCATED IN PART OF THE SW 1/4 AND THE SW 1/4 OF THE SW 1/4
OF SECTION 32, TOWN 2 NORTH, RANGE 16 EAST,
DELAVAN, WALWORTH COUNTY, WISCONSIN

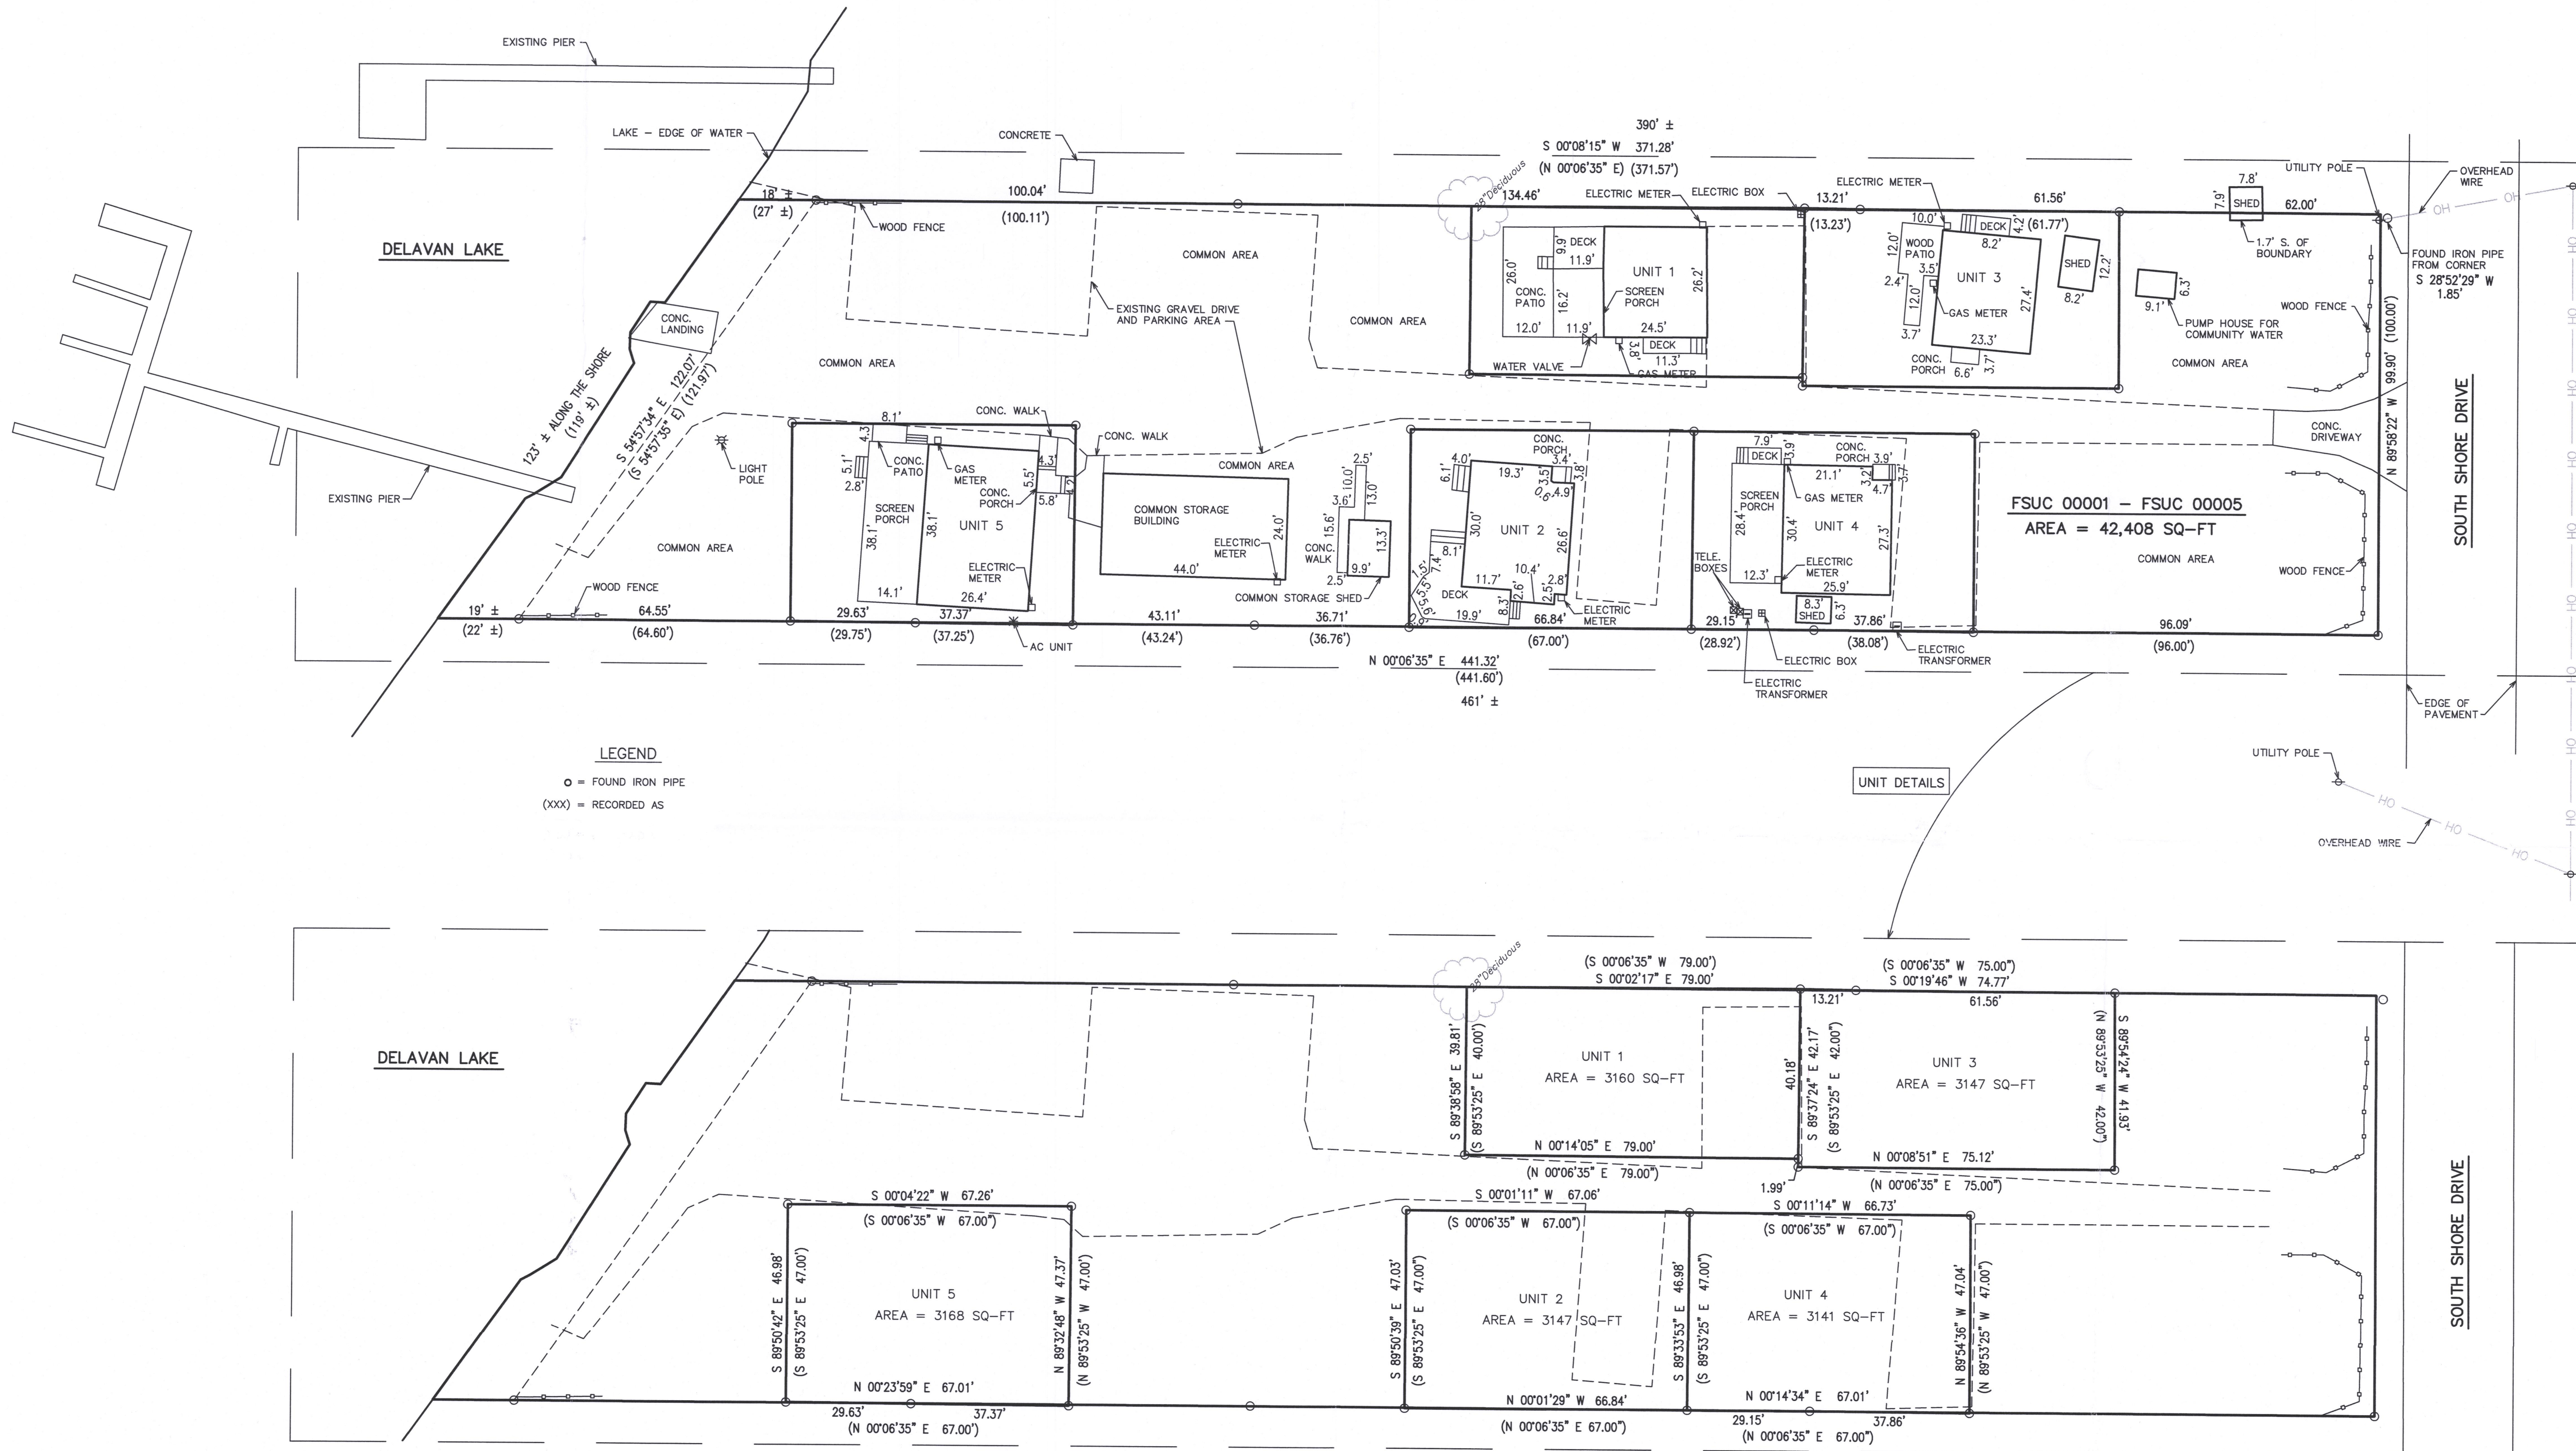

NOTE: COPIES OF THIS MAP TO WHICH THE FOLLOWING CERTIFICATE WILL APPLY SHOW THE SURVEYOR'S ORIGINAL SEAL AND SIGNATURE IN RED INK. COPIES BY ANY OTHER MEANS MAY HAVE ALTERATIONS WHICH DO NOT REPRESENT THE SURVEYOR'S WORK PRODUCT.

I HEREBY CERTIFY THAT THE ABOVE DESCRIBED PROPERTY HAS BEEN SURVEYED UNDER MY DIRECTION AND THAT THE ABOVE MAP IS A TRUE REPRESENTATION THEREOF AND SHOWS THE SIZE AND LOCATION OF THE PROPERTY AND ITS EXTERIOR BOUNDARIES. THIS SURVEY IS MADE FOR THE USE OF THE PRESENT OWNERS OF THE PROPERTY, AND ALSO THOSE WHO PURCHASE, MORTGAGE, OR GUARANTEE THE TITLE THERETO WITHIN ONE YEAR FROM THE DATE HEREOF.

DATE: 06/13/2017

PETER S. GORDON P.L.S. 2101

F8uc-1 F8uc-4
F8uc-2 F8uc-5
F8uc-3 216-5405