







Vanderstappen
Land Surveying, Inc.
www.vandersinc.com
1316 N. Madison St.
Woodstock, Illinois 60098
ph. 815-337-8310 fax 815-337-8314
"Always faithful to the property line"

PLAT OF SURVEY

Lot 20, Block 2 in the Plat of Delmar, being a Subdivision of part of Government Lot 3, part of the Southwest Quarter of the Southwest Quarter, all of the Southeast Quarter of the Southwest Quarter and part of the Northeast Quarter of the Southwest Quarter of Section 27, Township 2 North, Range 16 East of the Third Principal Meridian; and Lot 19 in Block 2 in said Plat of Delmar; (Excepting therefrom a parcel of land located in said Lot 19, Block 2, Delmar Subdivision, described as follows, to-wit: Beginning at the most Westerly corner of said Lot 19; thence South 45 degrees 22 minutes East along the Southwesterly line of said Lot 19 a distance of 94.79 feet; thence North 2 degrees 31 minutes West, 29.68 feet; thence North 60 degrees 48 minutes West, 75.74 feet to the Place of Beginning), in Walworth County, Wisconsin.

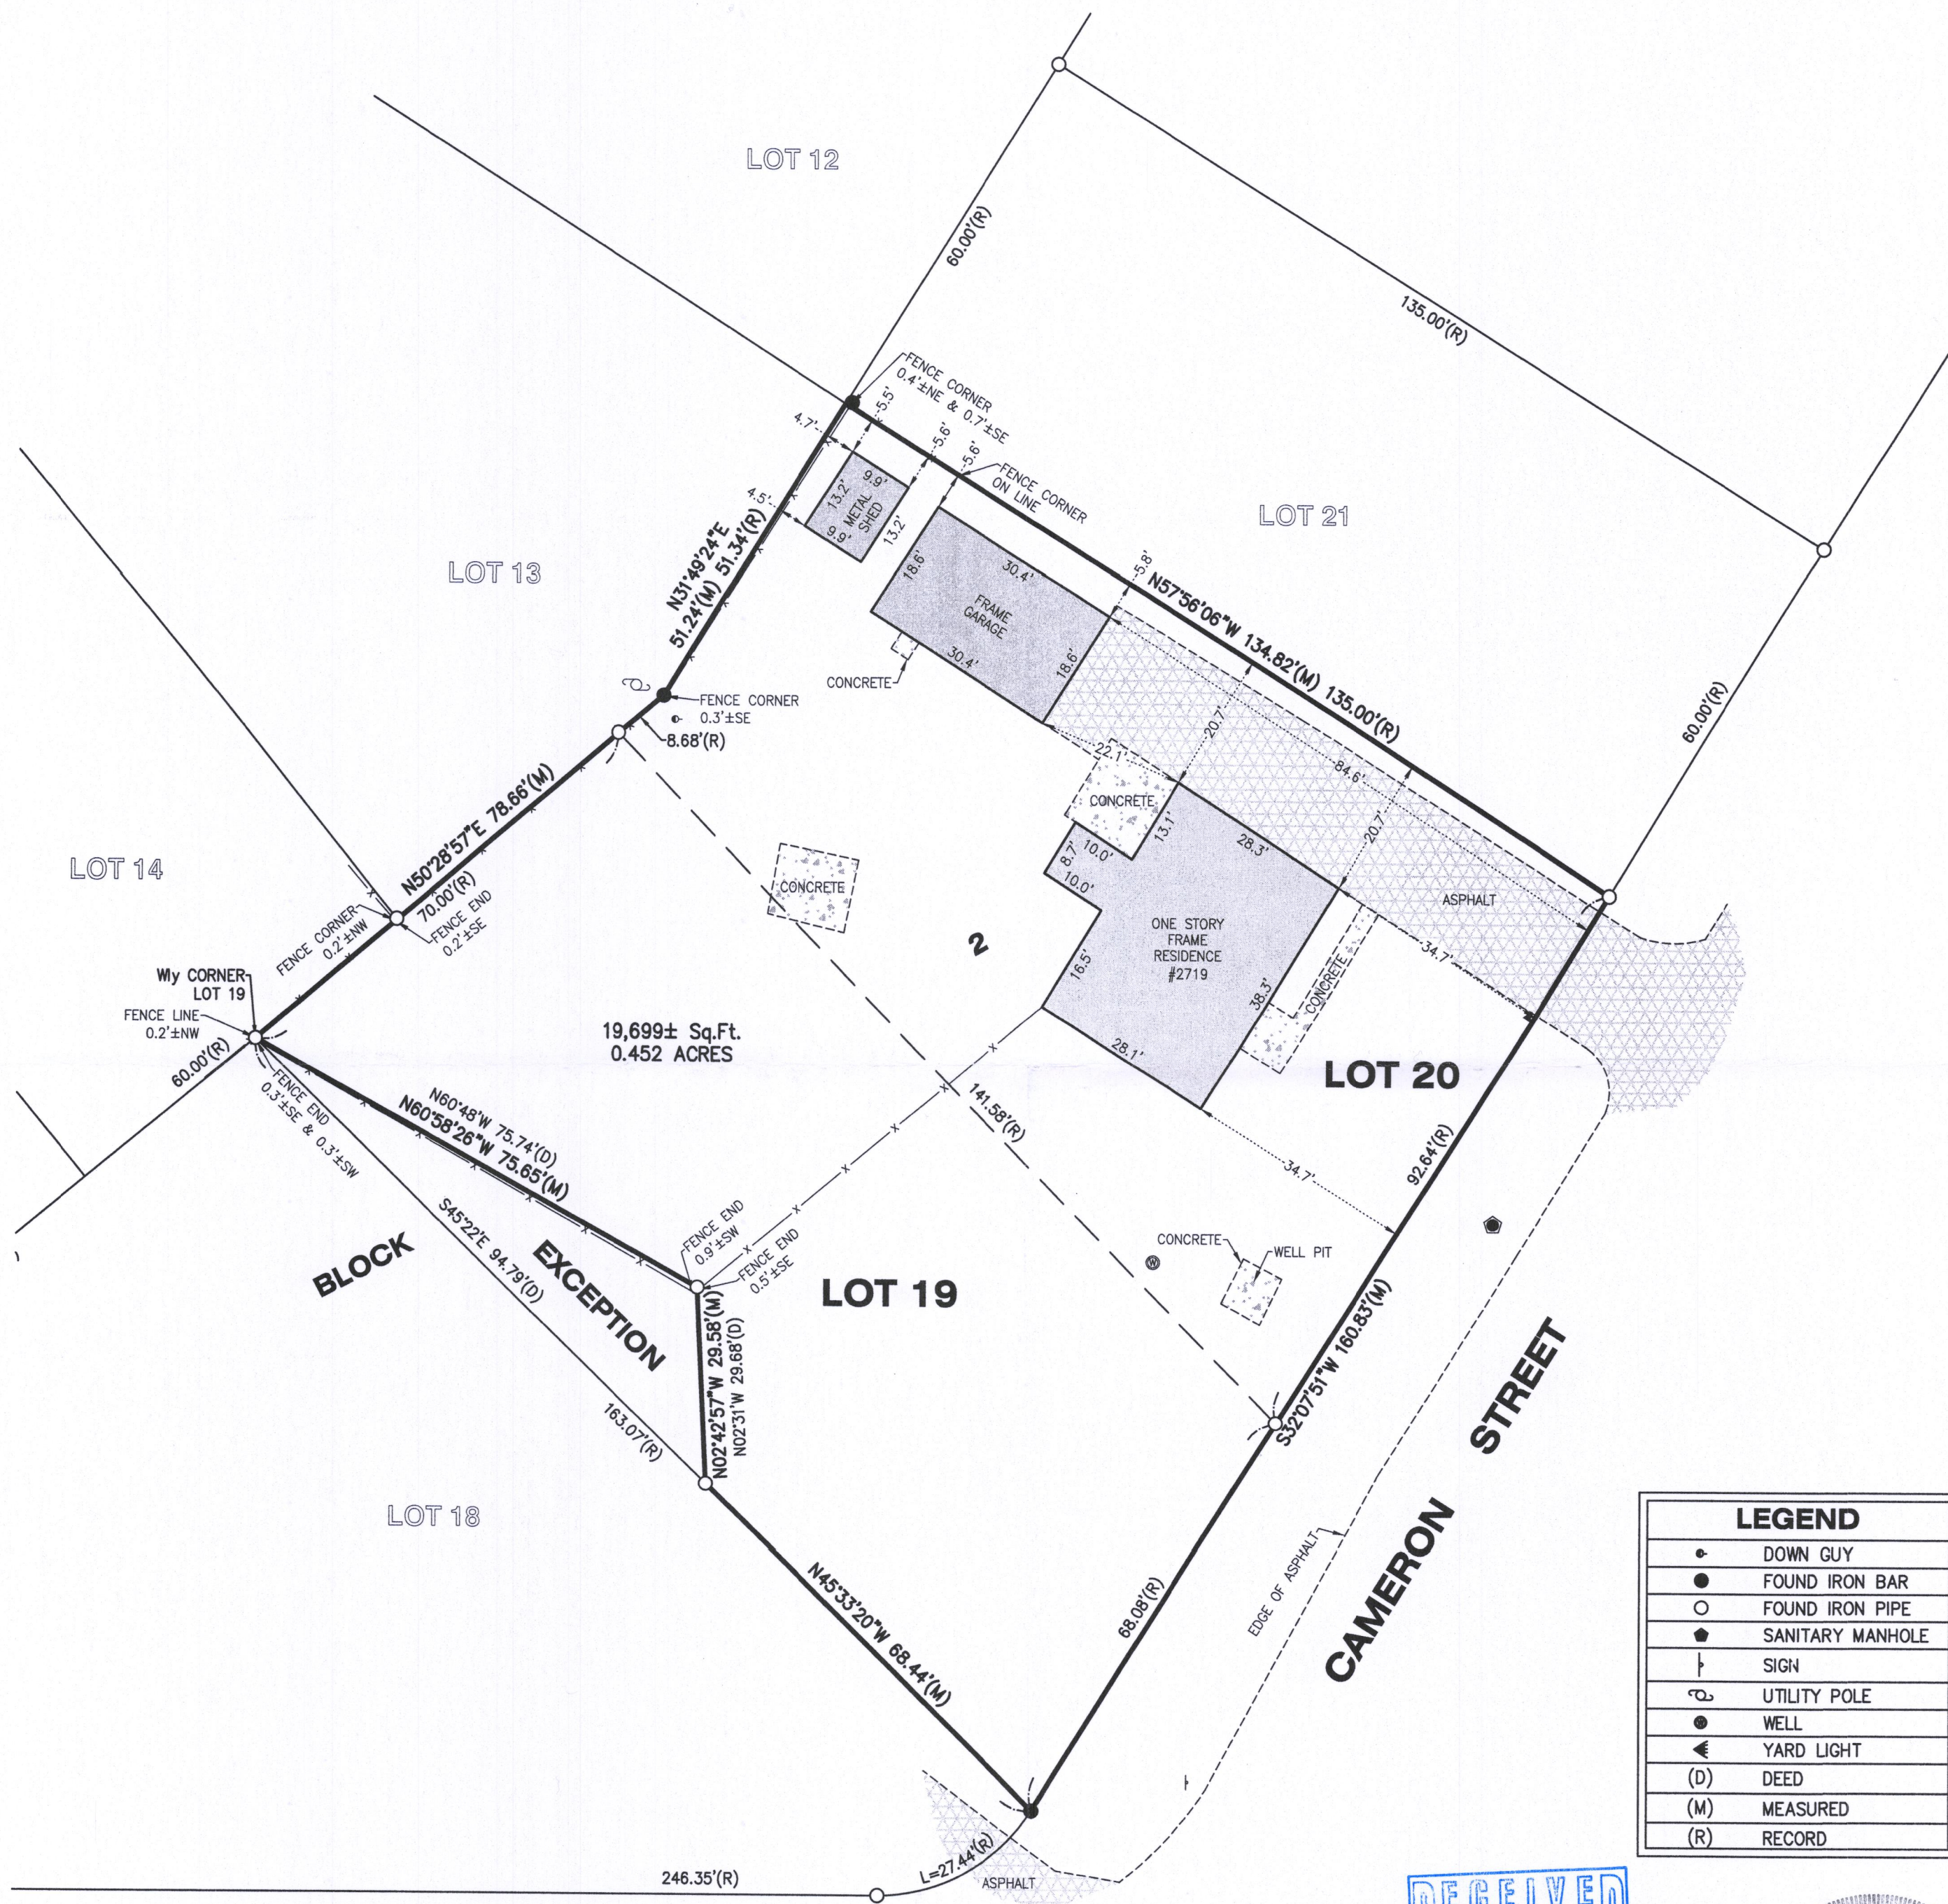

LEGEND	
•	DOWN GUY
●	FOUND IRON BAR
○	FOUND IRON PIPE
●	SANITARY MANHOLE
+	SIGN
⊙	UTILITY POLE
●	WELL
▲	YARD LIGHT
(D)	DEED
(M)	MEASURED
(R)	RECORD

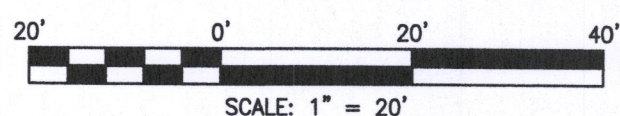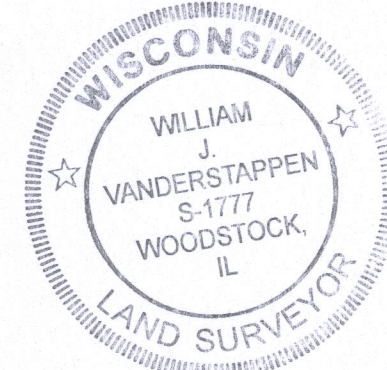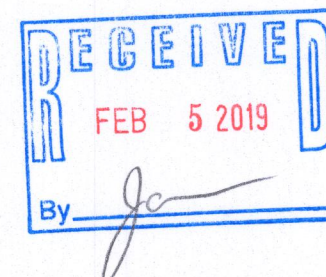

NOTE: Only those Building Line Restrictions or Easements shown on a Recorded Subdivision Plat are shown hereon unless the description ordered to be surveyed contains a proper description of the required building lines or easements.
* No distance should be assumed by scaling.
* No underground improvements have been located unless shown and noted.
* No representation as to ownership, use, or possession should be hereon implied.
* This Survey and Plat of Survey are void without original embossed or colored seal and signature affixed.

Compare your description and site markings with this plat and AT ONCE report any discrepancies which you may find.

STATE OF ILLINOIS)
COUNTY OF McHENRY) S.S.

In my professional opinion, and based on my observations, I hereby certify that the above described property has been surveyed under my direction and that the above map is a true representation thereof and shows the size and location of all visible structures, and dimensions of all principle buildings thereon, boundary fences, apparent easements, roadways, and visible encroachments, if any. This survey is made for the use of the present owners of the property, and also those who purchase, mortgage, or guarantee the title thereto within one year from the date hereof.

Dated at Woodstock, McHenry County, Illinois 9/19 A.D., 20 18.

Vanderstappen Land Surveying, Inc.
Design Firm No. 184-002792

By: *William J. Vanderstappen*
Wisconsin Registered Land Surveyor No. S1777

CLIENT: BILLIE JO PAPCKE
DRAWN BY: DAM CHECKED BY: WJV
SCALE: 1"=20' SEC. 27 T. 02 R. 16 E.
BASIS OF BEARING: ASSUMED
P.I.N.: FDM 00012D
JOB NO.: 180713 I.D. LSS
FIELDWORK COMP.: 9/17/18 BK. PG.
ALL DISTANCES SHOWN IN FEET AND DECIMAL REF:
PARTS THEREOF CORRECTED TO 68° F.