
Plat of Survey

of

Lots 9 & 10 of Willow Point Park,

a subdivision located in Government Lot 1 the Southeast 1/4 of Section 29, Town 2 North, Range 16 East, Town of Delavan, Walworth County, Wisconsin.

Surveyed for: **Keefe Real Estate, Inc.**
416 Bauer Parkway
Delavan, Wisconsin. 53115

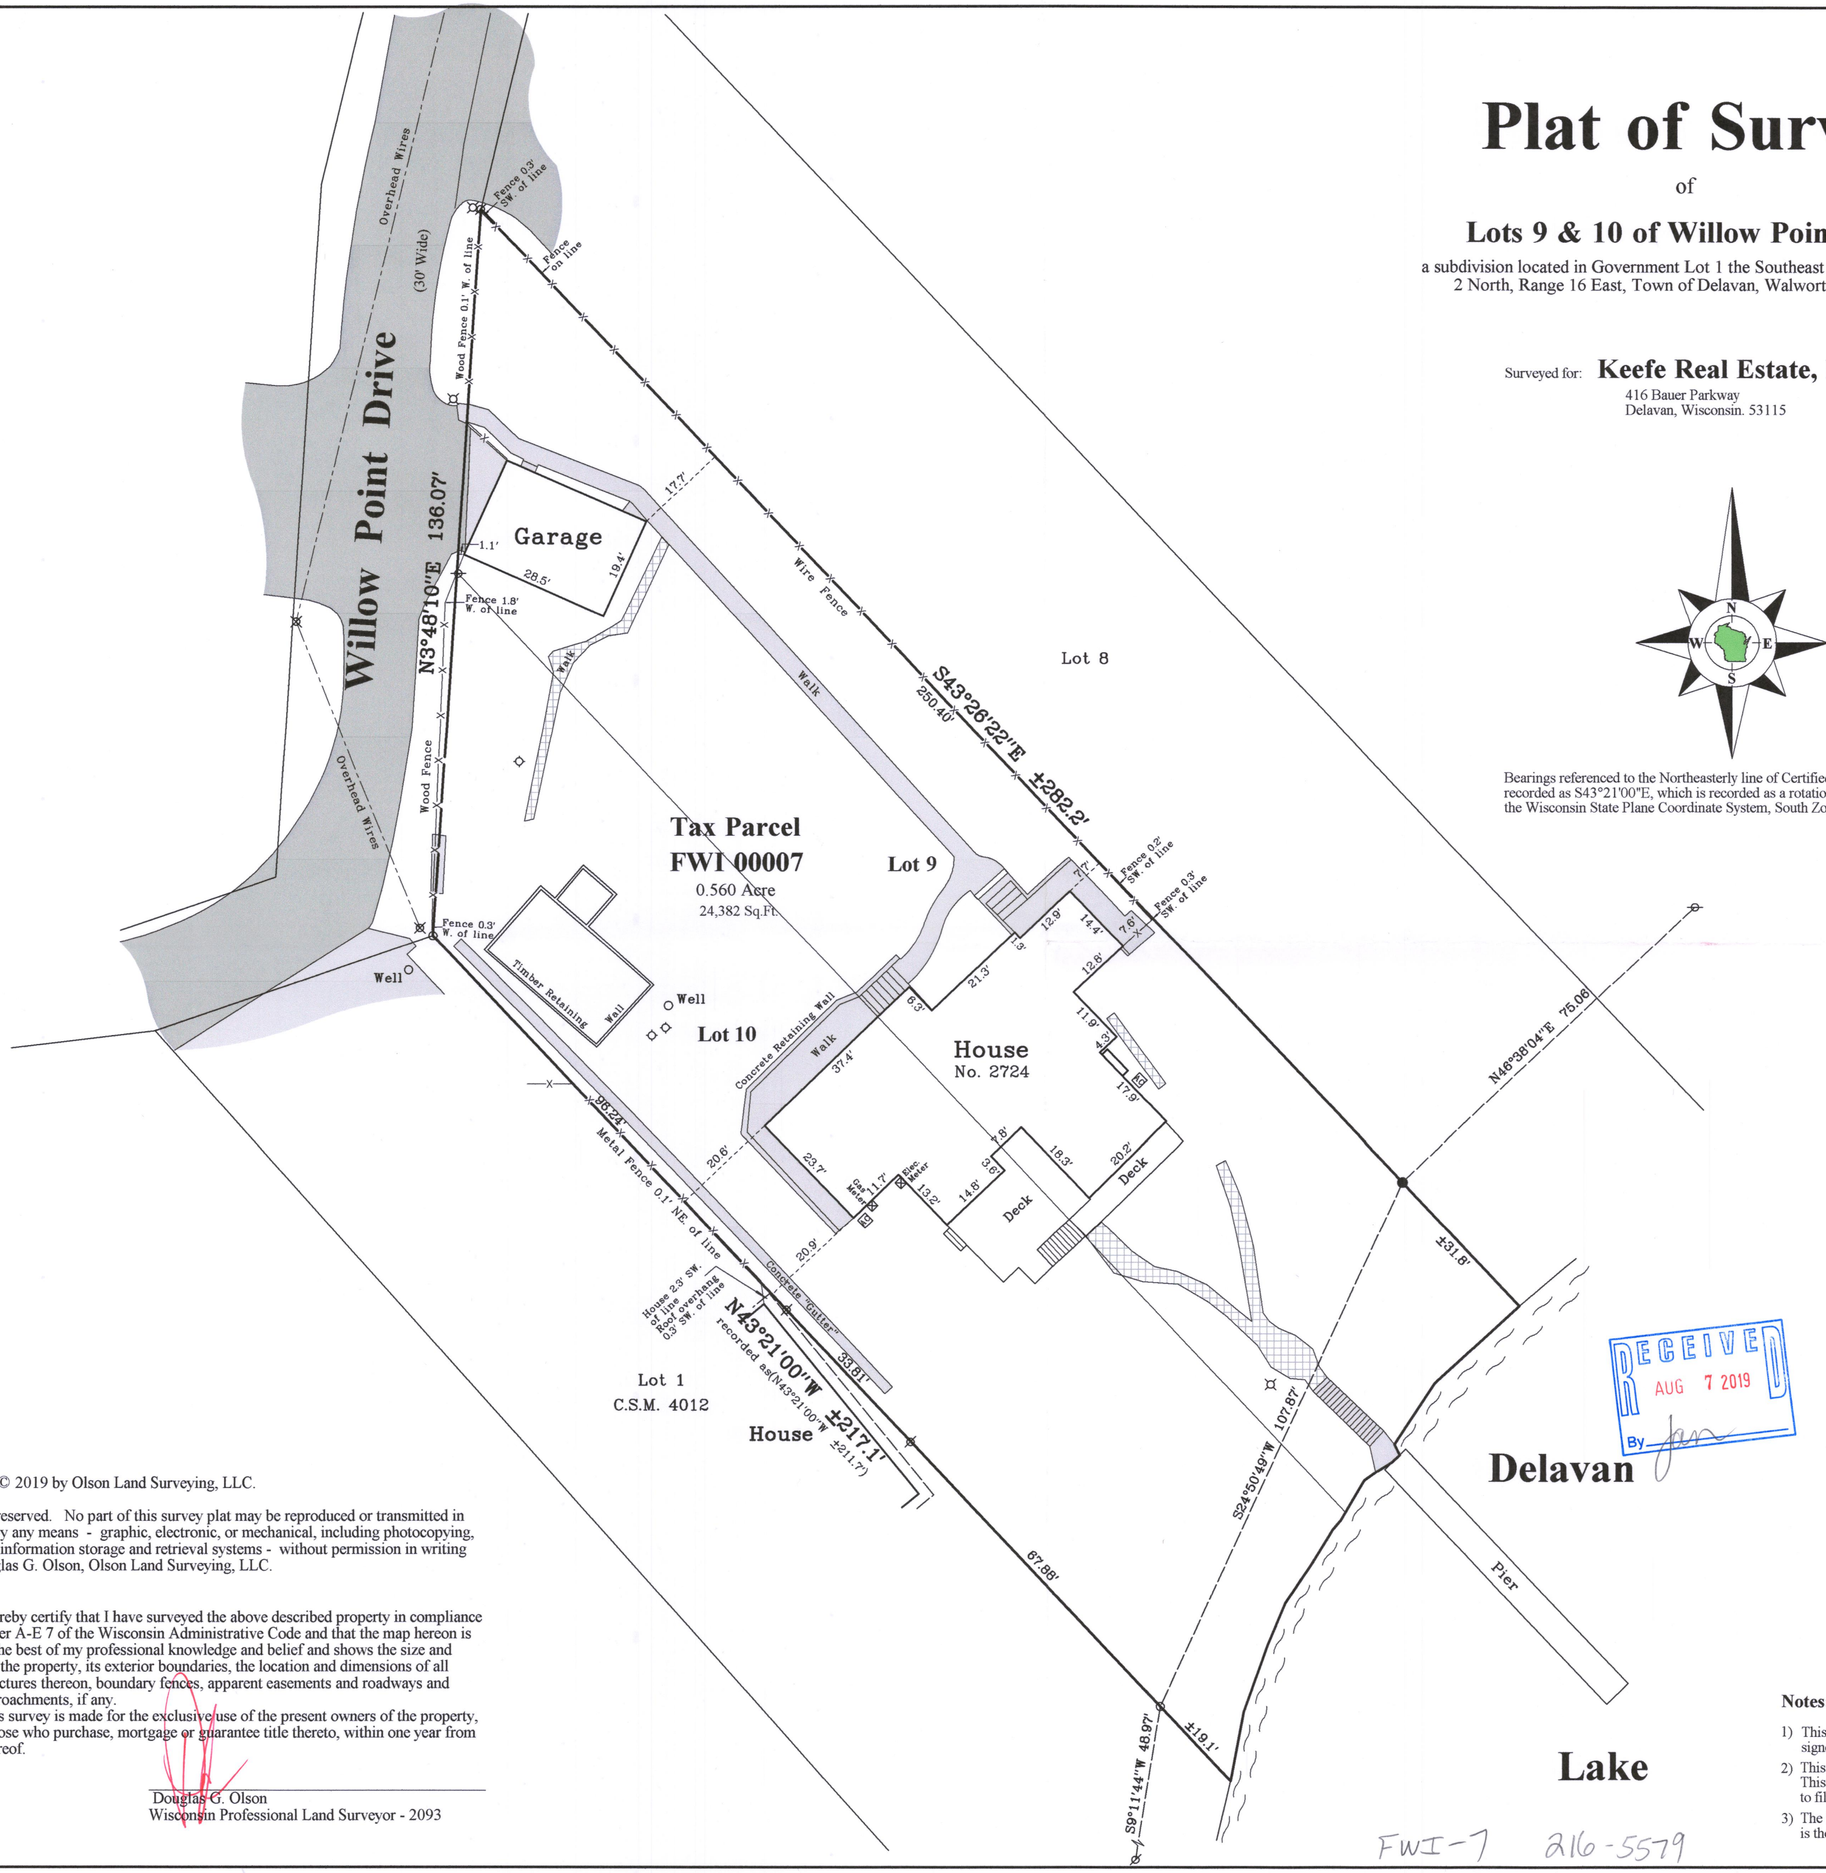

Bearings referenced to the Northeasterly line of Certified Survey Map No. 4012, recorded as S43°21'00"E, which is recorded as a rotation of -5°50'27" from the Wisconsin State Plane Coordinate System, South Zone, (NAD-27).

RECEIVED
AUG 7 2019
By

WISCONSIN
DOUGLAS OLSON
S-2093
ELKHORN, WI
LAND SURVEYOR
Not Certified Unless Stamped in Red.

Notes:

1) This Plat of Survey is not certified unless signed and sealed in red ink.
2) This survey is subject to Wisconsin lien laws. This Plat of Survey is the notice of intent to file lien. Lien waiver required.
3) The Survey Date shown on this Plat of Survey is the completion date of the field work.

Copyright © 2019 by Olson Land Surveying, LLC.

All rights reserved. No part of this survey plat may be reproduced or transmitted in any form by any means - graphic, electronic, or mechanical, including photocopying, tracing, or information storage and retrieval systems - without permission in writing from Douglas G. Olson, Olson Land Surveying, LLC.

I hereby certify that I have surveyed the above described property in compliance with Chapter A-E 7 of the Wisconsin Administrative Code and that the map hereon is correct to the best of my professional knowledge and belief and shows the size and location of the property, its exterior boundaries, the location and dimensions of all visible structures thereon, boundary fences, apparent easements and roadways and visible encroachments, if any.

This survey is made for the exclusive use of the present owners of the property, and also those who purchase, mortgage or guarantee title thereto, within one year from the date hereof.

Douglas G. Olson
Wisconsin Professional Land Surveyor - 2093

FWI-7 216-5579

Survey Date: April 9, 2019.
Revisions:

Scale in Feet
1" = 20'
0' 10' 20' 40' 60'

45 South Wisconsin Street | P.O. Box 322
Elkhorn, Wisconsin. 53121
Telephone: (262) 723-3434
Facsimile: (262) 723-8044
Email: doug@olsonsurveying.com
Website: www.olsonsurveying.com

OLSON
LAND SURVEYING, LLC
Rural | Residential | Commercial

Legend of Symbols & Abbreviations

Found Iron Pipe
Found Iron Rod
Set Iron Pipe, 1" dia.
Recorded Information
Utility Pole
Utility Pedestal
Asphalt Surface
Concrete Surface
Stone Surface
Lamp

N North
S South
E East
W West
In Bearings
° Degrees
' Minutes
" Seconds
In Distances
Feet
" Inches

Sheet 1 of 1 Sheets

Drawing Name:

Job Reference Number
2019.031

2019.031