

# Property Exhibit

of  
A Portion of  
Lot 1 & Outlot 1 of Certified  
Survey Map No. 4842,



recorded in Vol. 32 of Certified Survey Maps of Walworth County on Page 189 and located in the Southwest 1/4 of the Northeast 1/4, and in Government Lot 2 in the Northwest 1/4 of Section 33, Town 2 North, Range 16 East, Town of Delavan, Walworth County, Wisconsin.

Prepared for: **Law Offices of Anthony A. Coletti, S.C.**

101 Evergreen Parkway, #3  
Elkhorn, Wisconsin. 53121

**Lot 1**  
**C.S.M. 4842**  
**Tax Parcel**  
**FA484200001**  
1.821 Acres  
79,337 Sq.Ft.


**Outlot 1**  
**C.S.M. 4842**  
**Tax Parcel**  
**FA484200002**  
0.561 Acre  
24,430 Sq.Ft.  
Ingress & Egress Easement

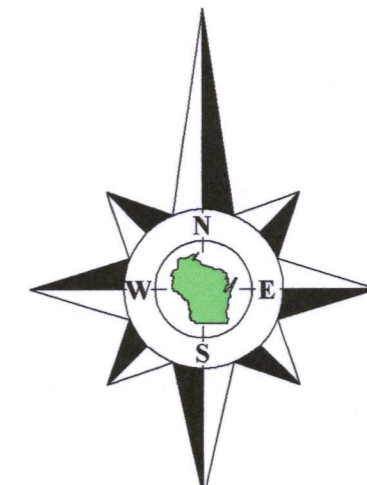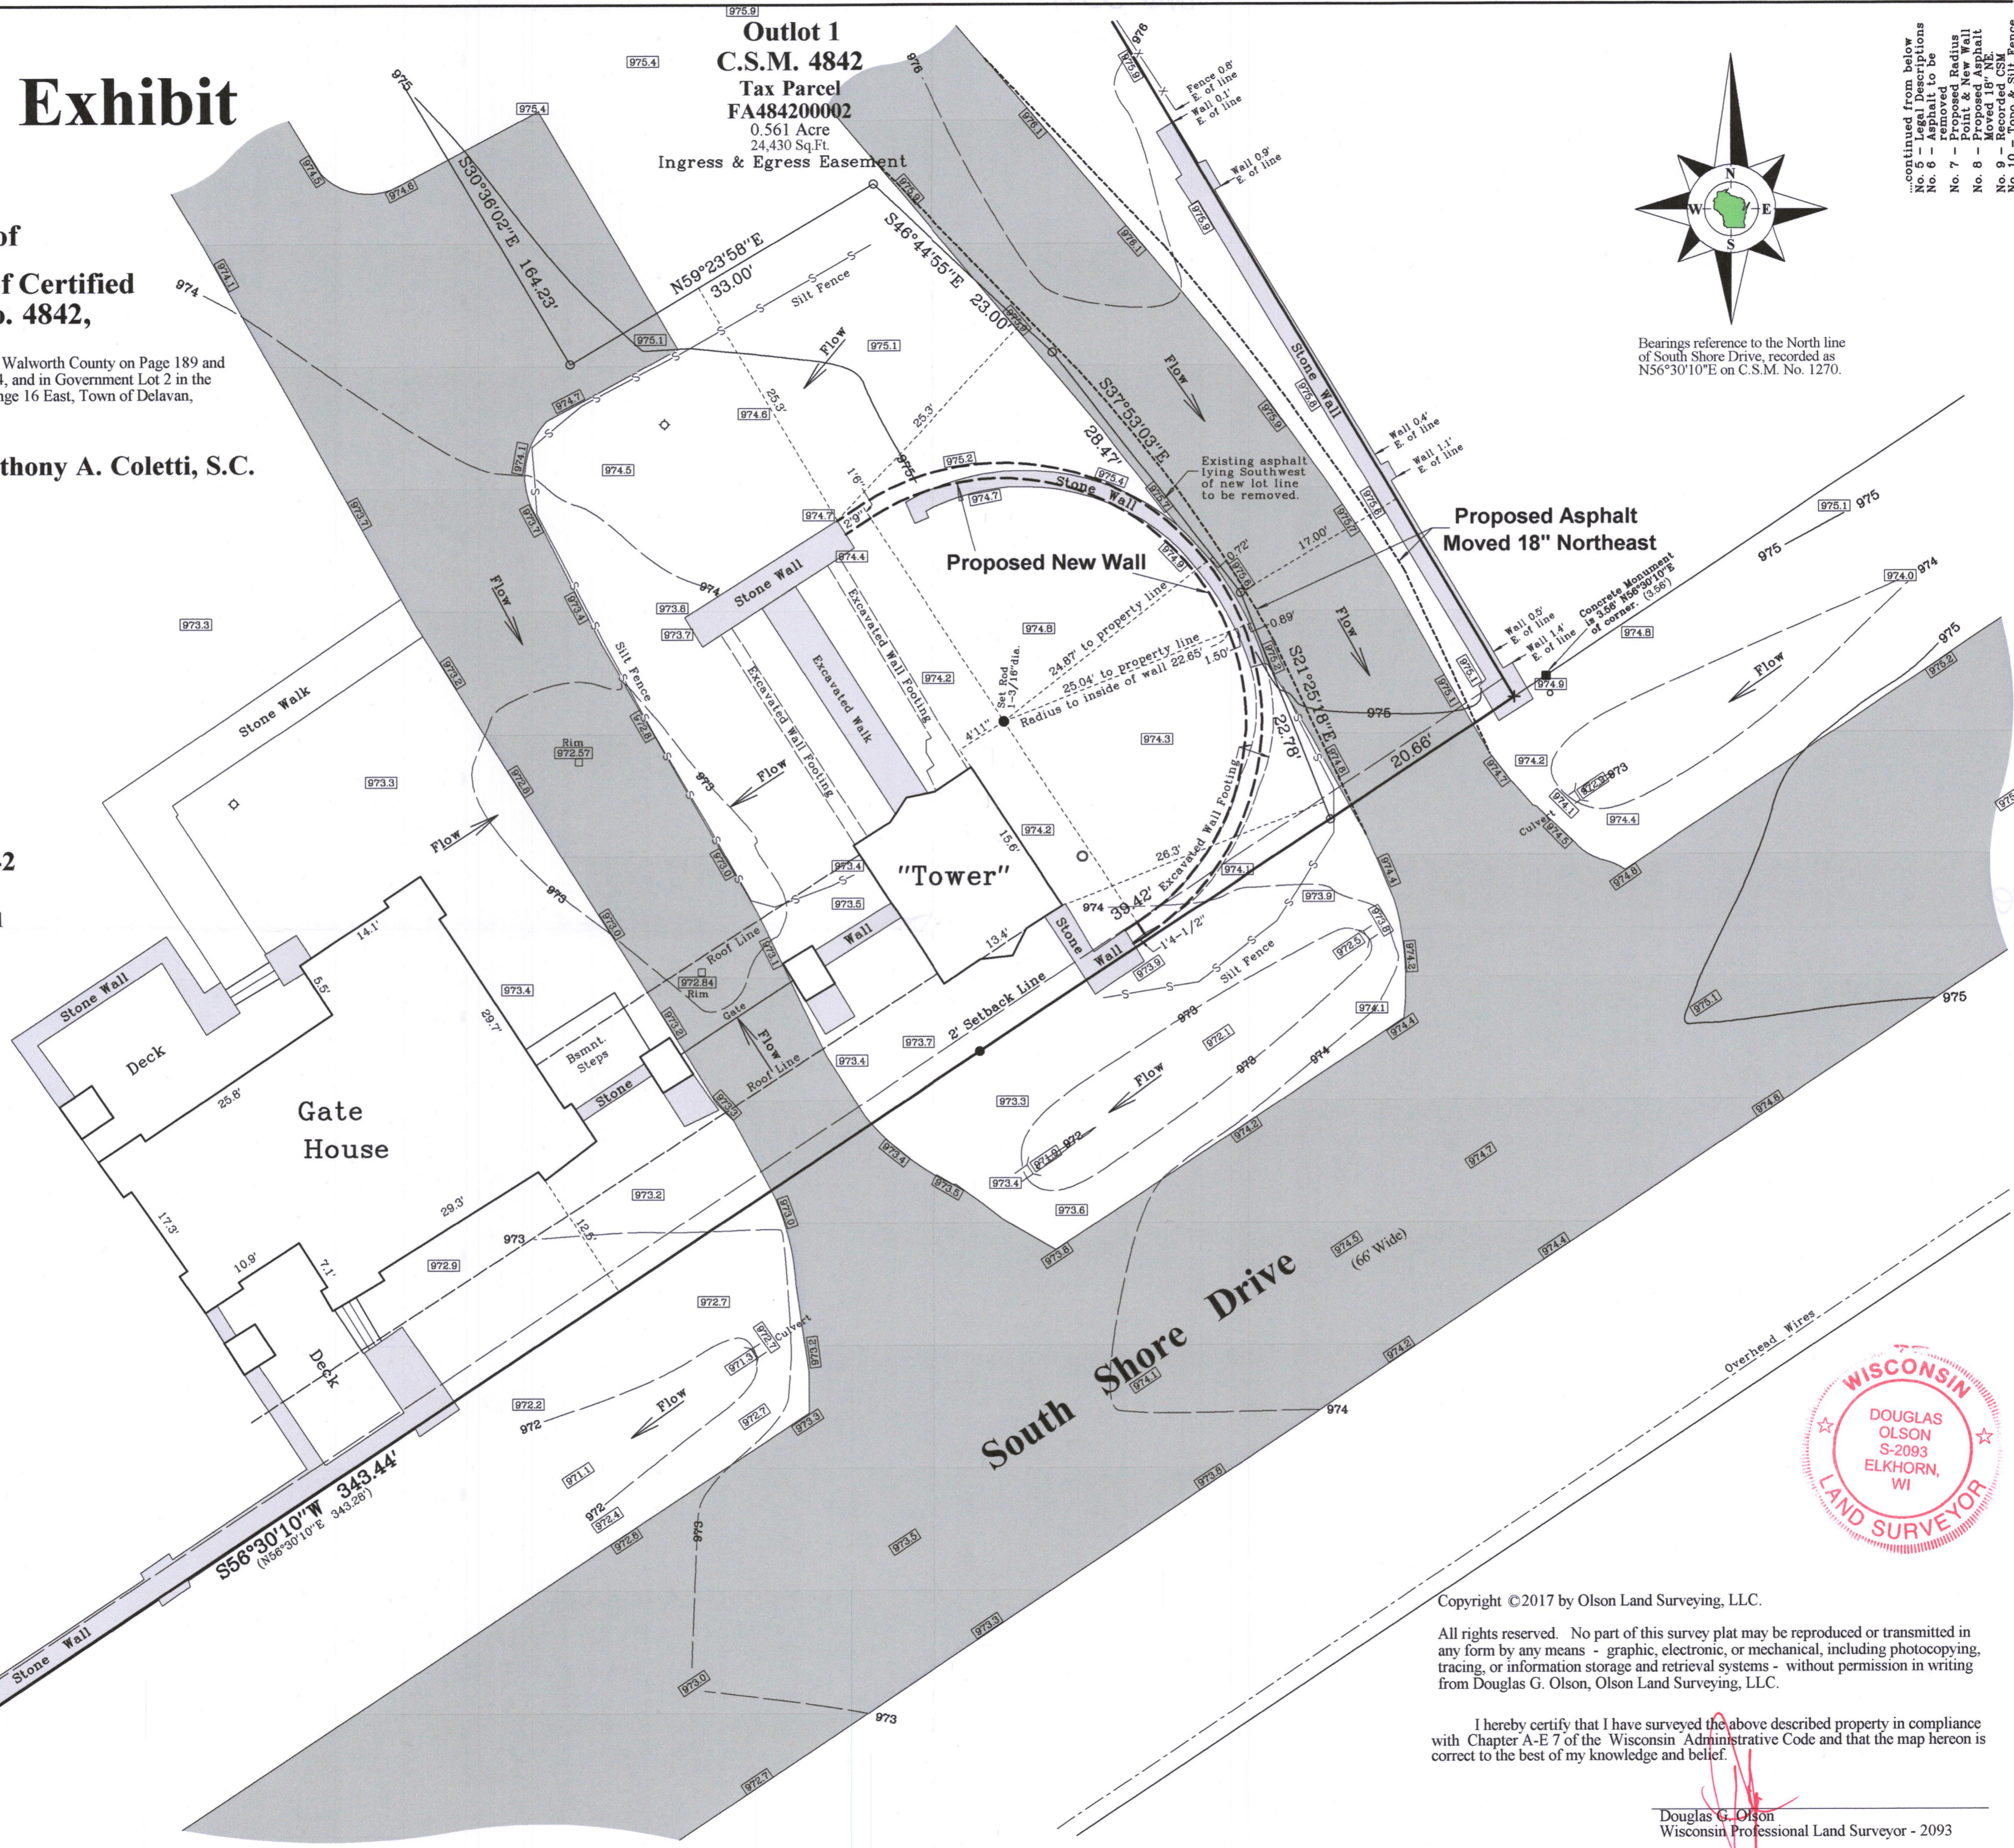


Bearings reference to the North line of South Shore Drive, recorded as N56°30'10"E on C.S.M. No. 1270.


**Survey Date:** December 19, 2017.  
**Revisions:**  
continued above...

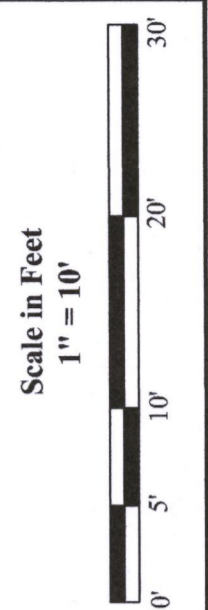


45 South Wisconsin Street | P.O. Box 322  
Elkhorn, Wisconsin, 53121  
Telephone: (262) 723-3434  
Facsimile: (262) 723-8044  
Email: doug@olsonsurveying.com  
Website: www.olsonsurveying.com

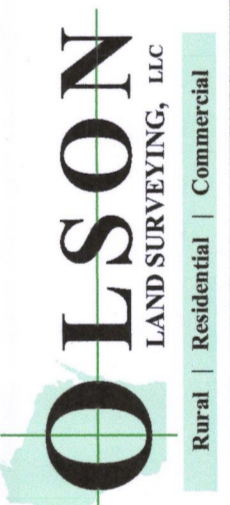

**Legend of Symbols & Abbreviations**

Found Concrete Monument	■
Found Iron Pipe	●
Found Iron Rod	○
Found Chiseled Cross	✕
Found Monument	⊕
Utility Pole	⊙
Utility Pedestal	⊗
Manhole	⊖
Asphalt Surface	▨
Concrete Surface	▩
Gravel Surface	▧

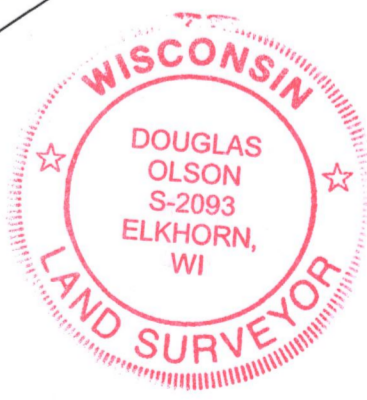

RECEIVED  
AUG 7 2019  
By: *SMF*

Copyright ©2017 by Olson Land Surveying, LLC.  
All rights reserved. No part of this survey plat may be reproduced or transmitted in any form by any means - graphic, electronic, or mechanical, including photocopying, tracing, or information storage and retrieval systems - without permission in writing from Douglas G. Olson, Olson Land Surveying, LLC.

I hereby certify that I have surveyed the above described property in compliance with Chapter A-E 7 of the Wisconsin Administrative Code and that the map hereon is correct to the best of my knowledge and belief.

Douglas G. Olson  
Wisconsin Professional Land Surveyor - 2093

Sheet 1 of 1 Sheets  
Job Reference Number  
**2017.141**  
2017.141

FA4842-1 + FA4842-2

216-5594