


PLAT OF SURVEY
PART OF UNIT 1 OF CHATEAU CONDOMINIUM

LOCATED IN PART OF THE NW 1/4 OF THE NE 1/4
OF SECTION 27, TOWN 2 NORTH, RANGE 16 EAST,
TOWN OF DELAVAN, WALWORTH COUNTY, WISCONSIN

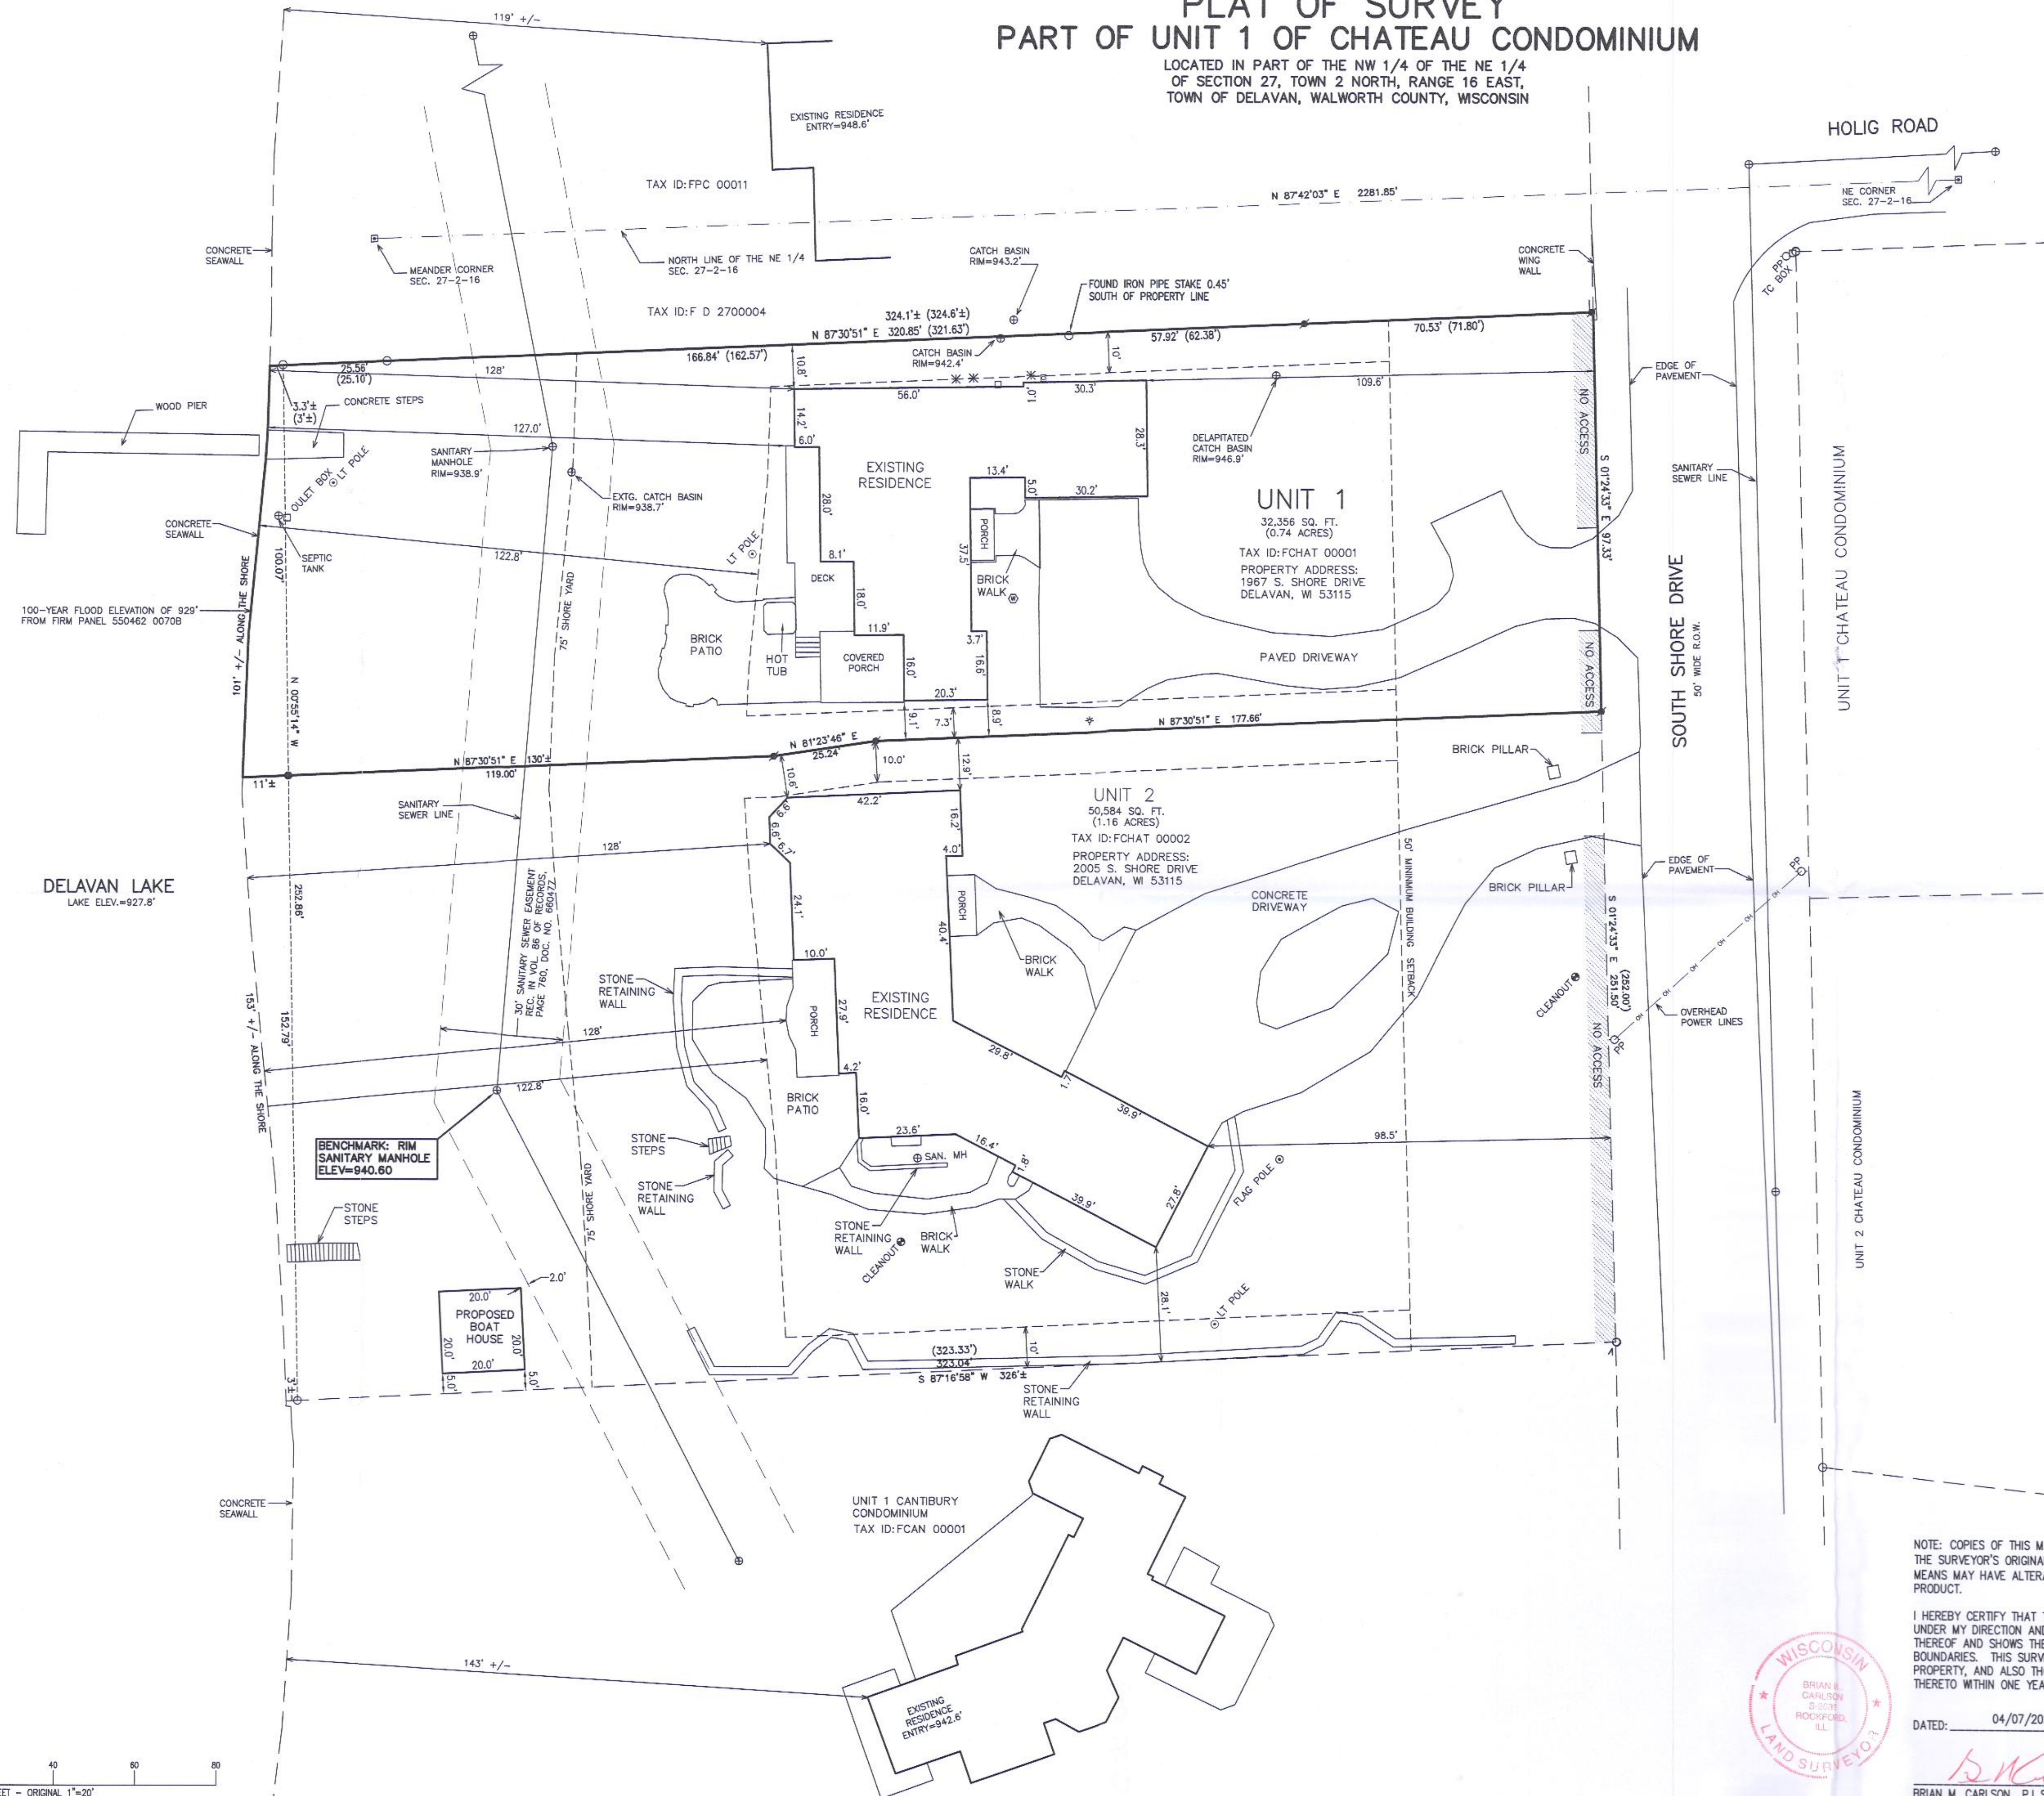

LEGEND

- = FOUND IRON PIPE STAKE
- = FOUND REBAR STAKE
- ✕ = SET CHISELED "X" IN CONCRETE (03/20/2006)
- ✱ = SET REBAR STAKE
- ✱ = AIR CONDITIONING UNIT
- = ELECTRIC METER
- = GAS METER
- ⊙ = WELL
- ✱ = BASKETBALL HOOP
- (XXX) = RECORDED AS

NOTE: COPIES OF THIS MAP TO WHICH THE FOLLOWING CERTIFICATE WILL APPLY SHOW THE SURVEYOR'S ORIGINAL SEAL AND SIGNATURE IN RED INK. COPIES BY ANY OTHER MEANS MAY HAVE ALTERATIONS WHICH DO NOT REPRESENT THE SURVEYOR'S WORK PRODUCT.

I HEREBY CERTIFY THAT THE ABOVE DESCRIBED PROPERTY HAS BEEN SURVEYED UNDER MY DIRECTION AND THAT THE ABOVE MAP IS A TRUE REPRESENTATION THEREOF AND SHOWS THE SIZE AND LOCATION OF THE PROPERTY AND ITS EXTERIOR BOUNDARIES. THIS SURVEY IS MADE FOR THE USE OF THE PRESENT OWNERS OF THE PROPERTY, AND ALSO THOSE WHO PURCHASE, MORTGAGE, OR GUARANTEE THE TITLE THERETO WITHIN ONE YEAR FROM THE DATE HEREOF.

DATED: 04/07/2020 - RESURVEYED UNIT 1

BRIAN M. CARLSON P.L.S. 2039



PLAT OF SURVEY
PART OF UNIT 1 OF CHATEAU CONDO.
1967 SOUTH SHORE DRIVE
DELAVAN, WI 53115

WORK ORDERED BY -
D.T. DESIGN
17337 W. KELLY ROAD
OLD MILL CREEK, IL 60083

FARRIS, HANSEN & ASSOCIATES, INC.
ENGINEERING - ARCHITECTURE - SURVEYING
7 RIDGWAY COURT P.O. BOX 437
ELKHORN, WISCONSIN 53121
OFFICE: (262) 723-2098 FAX: (262) 723-5886

REVISIONS
10/22/2019 - LB
UNIT 2 PERMIT
01/29/2020 - LB
ADD OLD DRIVE NOTES
02/07/2020 - LK
UPDATE DETAIL UNIT 2
04/07/2020 - LB
RESURVEY UNIT 1

PROJECT NO.
6564.20
DATE
03/20/2006
SHEET NO.
1 OF 1



X:\PROJECTS\6564\6564_20\ACAD\6564-20.DWG

FCHAT-1

2110-5673