


PLAT OF SURVEY & TOPOGRAPHIC MAPPING
UNITS 1 & 2 OF CAMERON ESTATE CONDOMINIUM

LOCATED IN PART OF THE NW 1/4 OF THE NE 1/4 OF SECTION 33,
TOWN 2 NORTH, RANGE 16 EAST, WALWORTH COUNTY, WISCONSIN

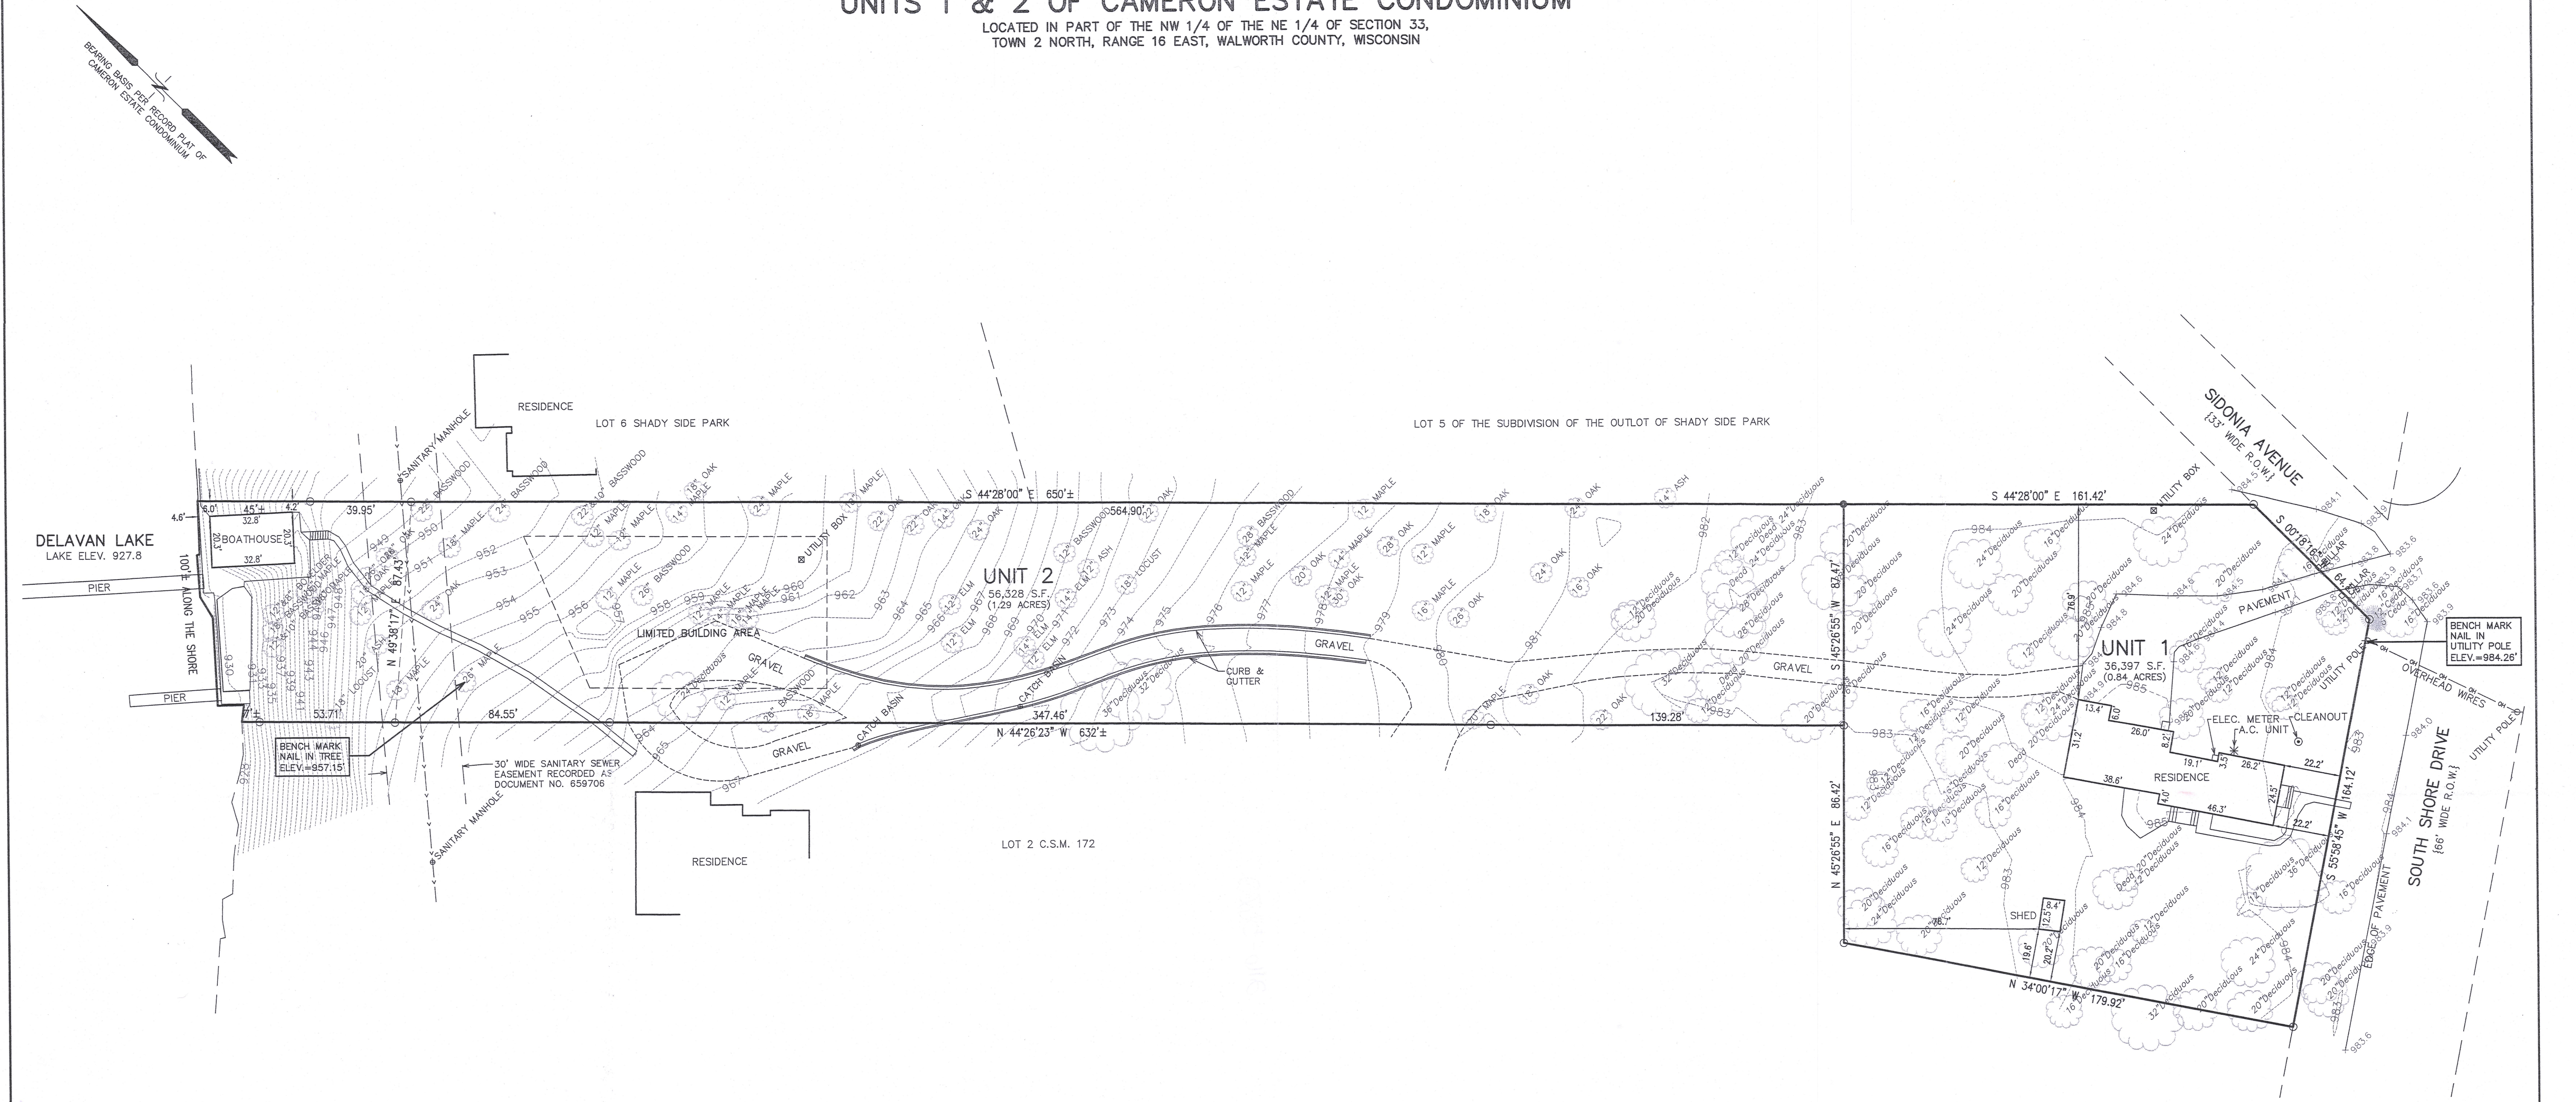

RECEIVED
JUN 30 2020
By *smf*

NOTE: COPIES OF THIS MAP TO WHICH THE FOLLOWING CERTIFICATE WILL APPLY SHOW THE SURVEYOR'S ORIGINAL SEAL AND SIGNATURE IN RED INK. COPIES BY ANY OTHER MEANS MAY HAVE ALTERATIONS WHICH DO NOT REPRESENT THE SURVEYOR'S WORK PRODUCT.


I HEREBY CERTIFY THAT THE ABOVE DESCRIBED PROPERTY HAS BEEN SURVEYED UNDER MY DIRECTION AND THAT THE ABOVE MAP IS A TRUE REPRESENTATION THEREOF AND SHOWS THE SIZE AND LOCATION OF THE PROPERTY AND ITS EXTERIOR BOUNDARIES. THIS SURVEY IS MADE FOR THE USE OF THE PRESENT OWNERS OF THE PROPERTY, AND ALSO THOSE WHO PURCHASE, MORTGAGE, OR GUARANTEE THE TITLE THERETO WITHIN ONE YEAR FROM THE DATE HEREOF.


DATED: 6/24/2020

Brian M. Carlson
BRIAN M. CARLSON P.L.S. 2039



LEGEND
○ = FOUND IRON PIPE STAKE
● = FOUND IRON REBAR STAKE
{XXX} = RECORDED AS

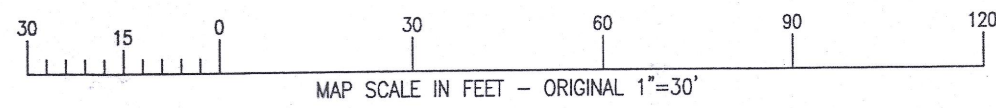

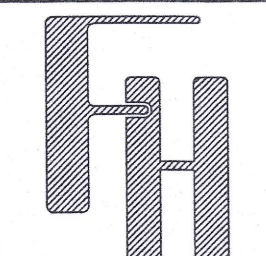	PLAT OF SURVEY 3265 SOUTH SHORE DRIVE DELAVER, WI 53115	— WORK ORDERED BY — GINA NOCEK 880 W. MAIN STREET LAKE GENEVA, WI 53147	FARRIS, HANSEN & ASSOCIATES, INC. ENGINEERING — ARCHITECTURE — SURVEYING 7 RIDGWAY COURT P.O. BOX 437 ELKHORN, WISCONSIN 53121 OFFICE: (262) 723-2098 FAX: (262) 723-5886	REVISIONS		PROJECT NO. 7109.20 DATE 06/24/2020 SHEET NO. 1 OF 1

X:\PROJECTS\7109.20\ACAD\7109.20.dwg

FCAM-1 FCAM-2

216-5862