

Plat of Survey

of

A parcel of land described in Title Commitment No. WA-14694 prepared by Chicago Title Insurance Company, dated July 16, 2019 as shown below:

Parcel 1:

A parcel of land located in the Southwest 1/4 of Section 32, Town 2 North, Range 16 East described as follows: Beginning 734 1/4 feet East and 49 1/2 feet North of the Southwest corner of Government Lot 3, Section 32; thence North 100 feet; thence East 150 feet; thence South 100 feet; thence West 150 feet to the beginning. Said land being in the Town of Delavan, County of Walworth, State of Wisconsin.



Tax Key No. F D 3200055

Parcel 2:


Lot 1 of Certified Survey Map No. 4807 according to the recorded plat thereof, recorded September 26, 2018 in Volume 32 of Certified Surveys on Page 83 as Document No. 975893, located in Government Lot 3 in the Southwest 1/4 of Section 32, Town 2 North, Range 16 East, Town of Delavan, Walworth County, Wisconsin.

Tax Key No. FA480700001

Surveyed for: Mike & Rachel Kirsh
1815 North Howe Street
Chicago, Illinois 60614

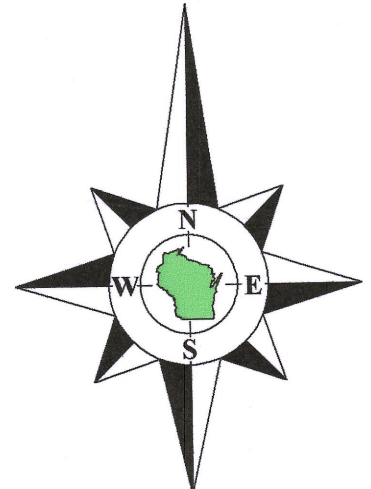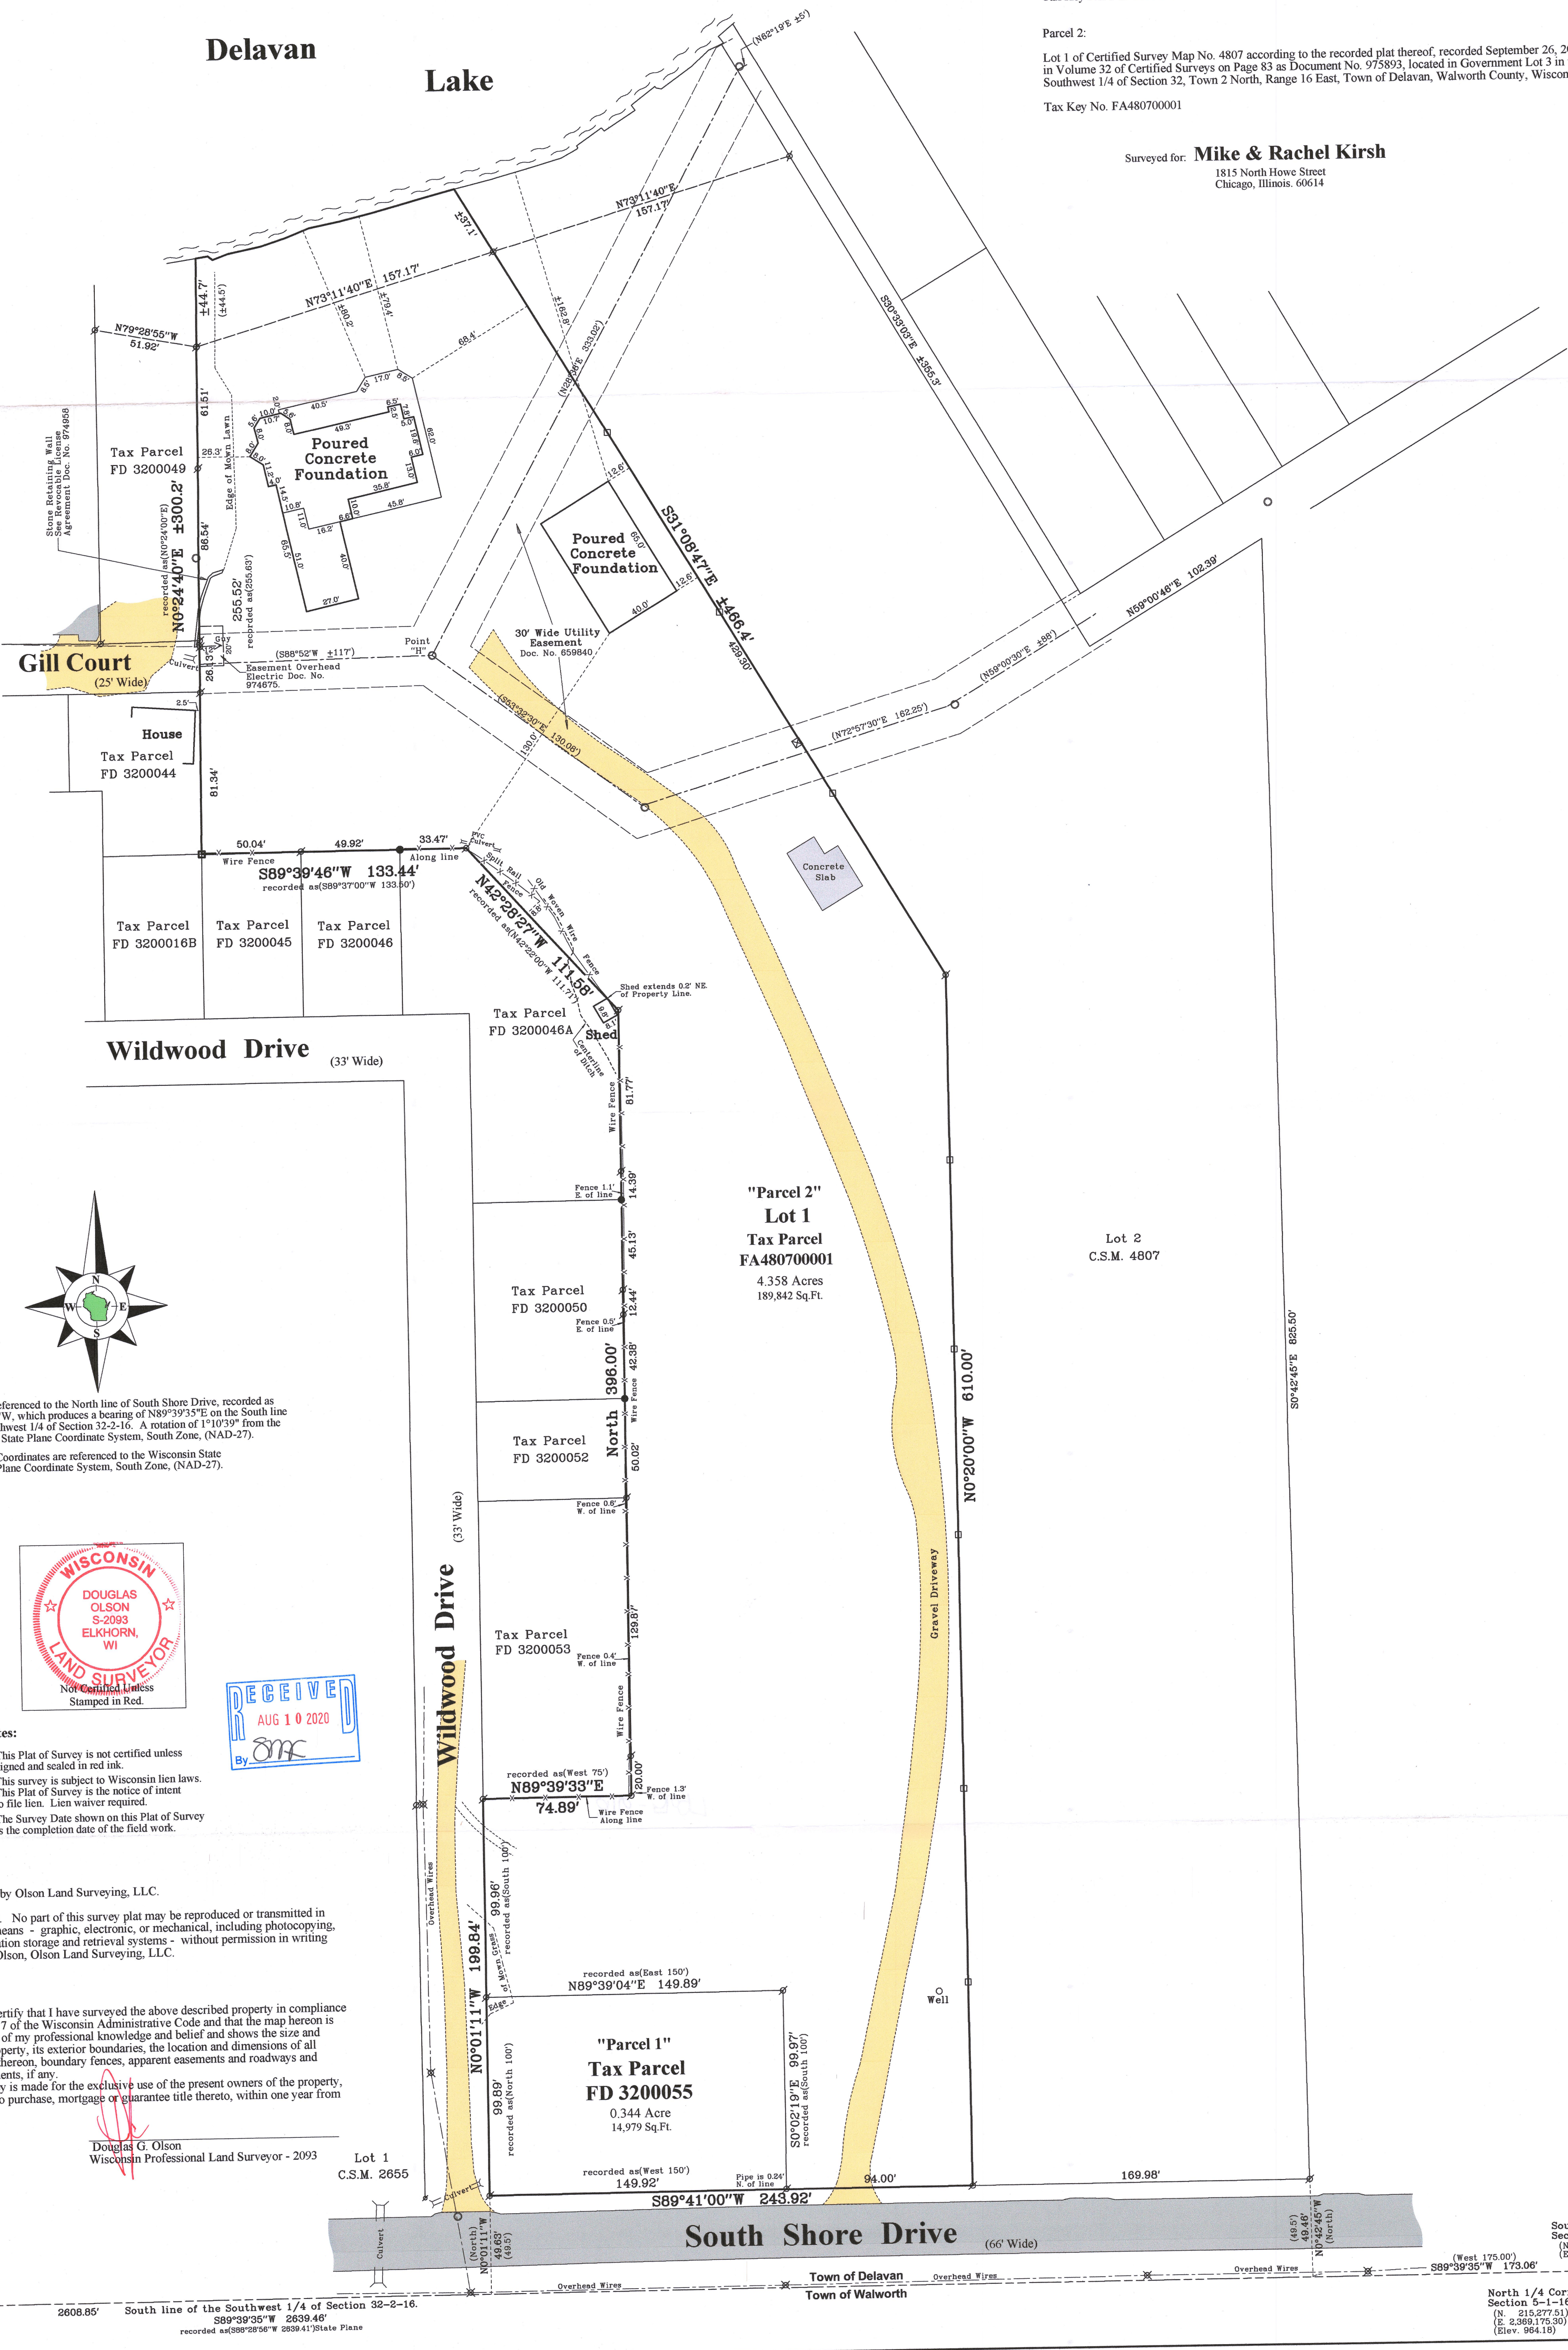

Bearings referenced to the North line of South Shore Drive, recorded as S89°41'00\"/>

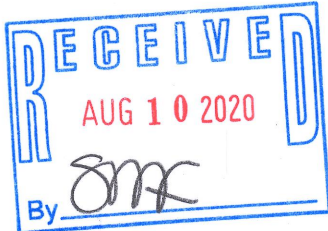

Notes:

- 1) This Plat of Survey is not certified unless signed and sealed in red ink.
- 2) This survey is subject to Wisconsin lien laws. This Plat of Survey is the notice of intent to file lien. Lien waiver required.
- 3) The Survey Date shown on this Plat of Survey is the completion date of the field work.

Copyright © 2019 by Olson Land Surveying, LLC.

All rights reserved. No part of this survey plat may be reproduced or transmitted in any form by any means - graphic, electronic, or mechanical, including photocopying, tracing, or information storage and retrieval systems - without permission in writing from Douglas G. Olson, Olson Land Surveying, LLC.

I hereby certify that I have surveyed the above described property in compliance with Chapter A-E 7 of the Wisconsin Administrative Code and that the map hereon is correct to the best of my professional knowledge and belief and shows the size and location of the property, its exterior boundaries, the location and dimensions of all visible structures thereon, boundary fences, apparent easements and roadways and visible encroachments, if any.

This survey is made for the exclusive use of the present owners of the property, and also those who purchase, mortgage or guarantee title thereto, within one year from the date hereof.

Douglas G. Olson
Wisconsin Professional Land Surveyor - 2093

Lot 1
C.S.M. 2655

"Parcel 1"
Tax Parcel
FD 3200055
0.344 Acre
14,979 Sq.Ft.

"Parcel 2"
Lot 1
Tax Parcel
FA480700001
4.358 Acres
189,842 Sq.Ft.

Lot 2
C.S.M. 4807

South Shore Drive (66' Wide)

Southwest Corner
Section 32-2-16
(N. 215,208.41)
(E. 2,366,567.57)

2608.85' South line of the Southwest 1/4 of Section 32-2-16.
S89°39'35\"/>

South 1/4 Corner
Section 32-2-16
(N. 215,278.33)
(E. 2,369,206.01)

North 1/4 Corner
Section 5-1-16
(N. 215,277.51)
(E. 2,380,175.30)
(Elev. 964.18)

Sheet 1 of 1 Sheets

Drawing Name:

Job Reference Number

2019.145

Legend of Symbols & Abbreviations

- Found County Section Corner
- Found Iron Pipe
- Found Iron Rod
- Set Iron Pipe, 1" dia.
- Recorded Information
- Utility Pole
- Utility Pedestal
- Concrete Cover
- Concrete Vent
- Asphalt Surface
- Gravel Surface
- Brick Pavers
- Found Monument
- Metal Fence Post

OLSON

LAND SURVEYING, LLC

Rural | Residential | Commercial

45 South Wisconsin Street | P.O. Box 322

Elkhorn, Wisconsin. 53121

Telephone: (262) 723-3434

Facsimile: (262) 723-8044

Email: doug@olsonsurveying.com

Website: www.olsonsurveying.com

Scale in Feet

1" = 40'

0' 20' 40' 80' 120'

Survey date: August 15, 2019.

Revisions:

- No. 1 - Topo. & Misc. Items
- No. 2 - Misc. Items
- No. 3 - Proposed House & Shed
- No. 4 - Proposed Driveway
- No. 5 - Gravel Driveway
- No. 6 - Poured Concrete Foundation
- No. 7 - Proposed Shed
- No. 8 - As-built Shed

216-5697