


PLAT OF SURVEY & TOPOGRAPHIC MAPPING UNIT 2 OF CANTIBURY CONDOMINIUM

LOCATED IN PART OF THE NW 1/4 OF THE NE 1/4 OF SECTION 27, TOWN 2 NORTH,
RANGE 16 EAST, WALWORTH COUNTY, WISCONSIN

ASSIGNED THE SOUTHERLY BOUNDARY OF
THE WESTERLY PORTION OF UNIT 2
S 84°54'09" W PER RECORD PLAT

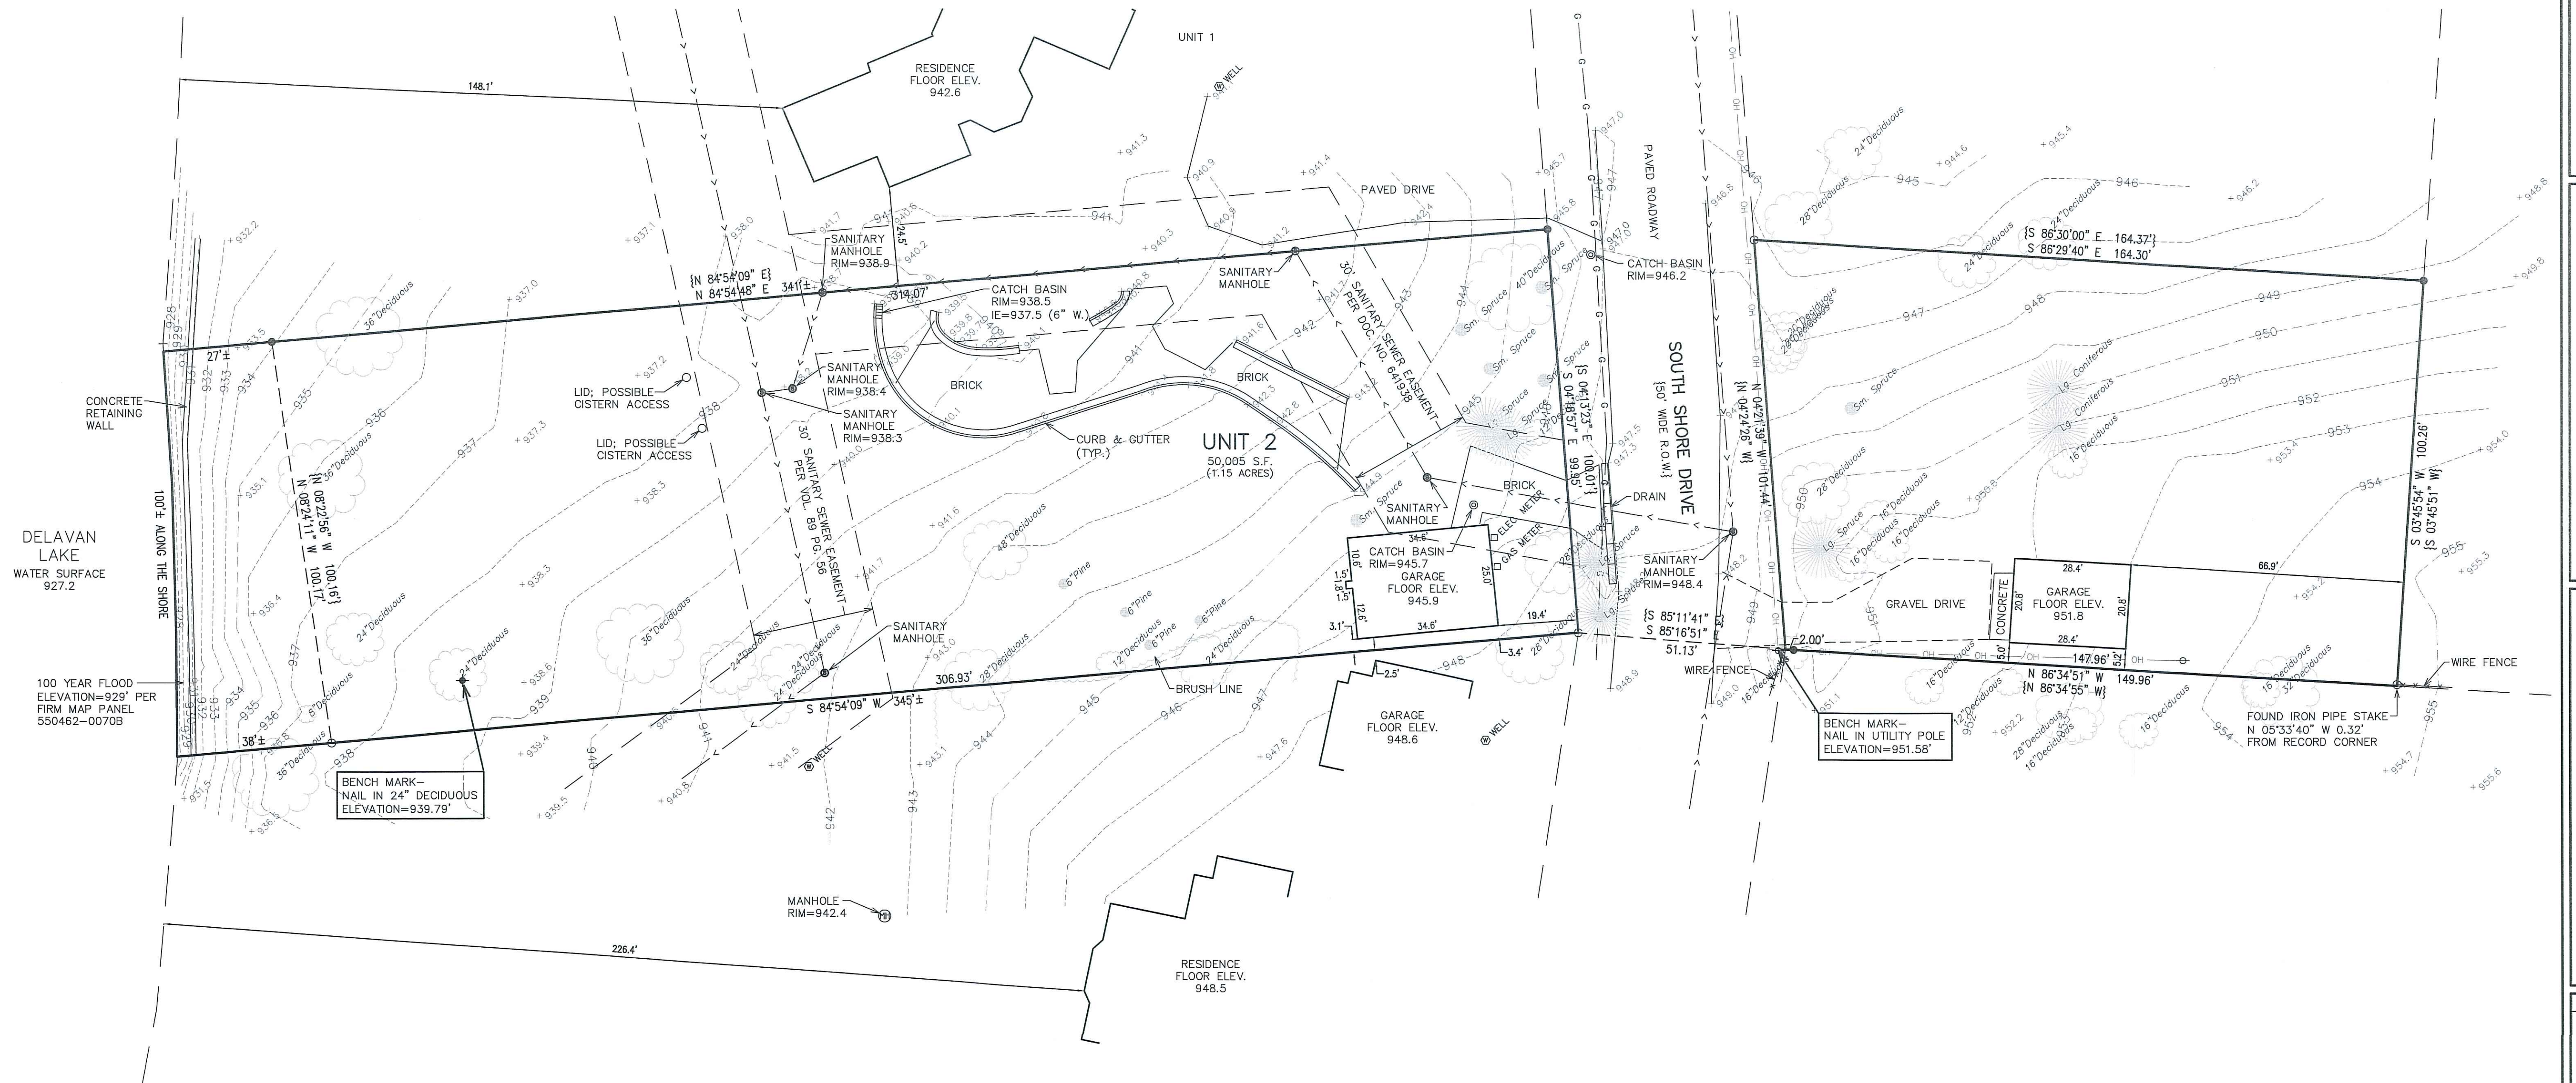

DELAVAN LAKE
WATER SURFACE
927.2

100 YEAR FLOOD
ELEVATION=929' PER
FIRM MAP PANEL
550462-0070B

BENCH MARK—
NAIL IN 24" DECIDUOUS
ELEVATION=939.79'

MANHOLE
RIM=942.4

RESIDENCE
FLOOR ELEV.
948.5

LEGEND

- = FOUND IRON PIPE STAKE
- = FOUND IRON REBAR STAKE
- ⊕ = UTILITY POLE LOCATED
- OH — = OVERHEAD WIRES LOCATED
- {XXX} = RECORDED AS




NOTE: COPIES OF THIS MAP TO WHICH THE FOLLOWING CERTIFICATE WILL APPLY SHOW
THE SURVEYOR'S ORIGINAL SEAL AND SIGNATURE IN RED INK. COPIES BY ANY OTHER
MEANS MAY HAVE ALTERATIONS WHICH DO NOT REPRESENT THE SURVEYOR'S WORK
PRODUCT.

I HEREBY CERTIFY THAT THE ABOVE DESCRIBED PROPERTY HAS BEEN SURVEYED
UNDER MY DIRECTION AND THAT THE ABOVE MAP IS A TRUE REPRESENTATION
THEREOF AND SHOWS THE SIZE AND LOCATION OF THE PROPERTY AND ITS EXTERIOR
BOUNDARIES. THIS SURVEY IS MADE FOR THE USE OF THE PRESENT OWNERS OF THE
PROPERTY, AND ALSO THOSE WHO PURCHASE, MORTGAGE, OR GUARANTEE THE TITLE
THERETO WITHIN ONE YEAR FROM THE DATE HEREOF.

DATE: 4/9/2021

Christopher A. Hodges
CHRISTOPHER A. HODGES P.L.S. 2780

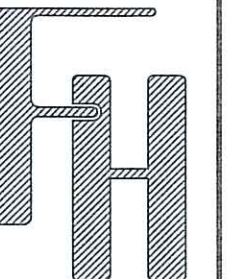

SURVEY & TOPOGRAPHY

2087 SOUTH SHORE DRIVE

— WORK ORDERED BY —
THELEN TOTAL CONSTRUCTION, INC.
P.O. BOX 17
ELKHORN, WI 53121

FARRIS, HANSEN & ASSOCIATES, INC.
ENGINEERING — ARCHITECTURE — SURVEYING
7 RIDGEWAY COURT
ELKHORN, WISCONSIN 53121
OFFICE: (262) 723-2088 FAX: (262) 723-5886

REVISIONS

PROJECT NO.
5129.02.21
DATE
04/09/2021
SHEET NO.
1 OF 1