
#37-67

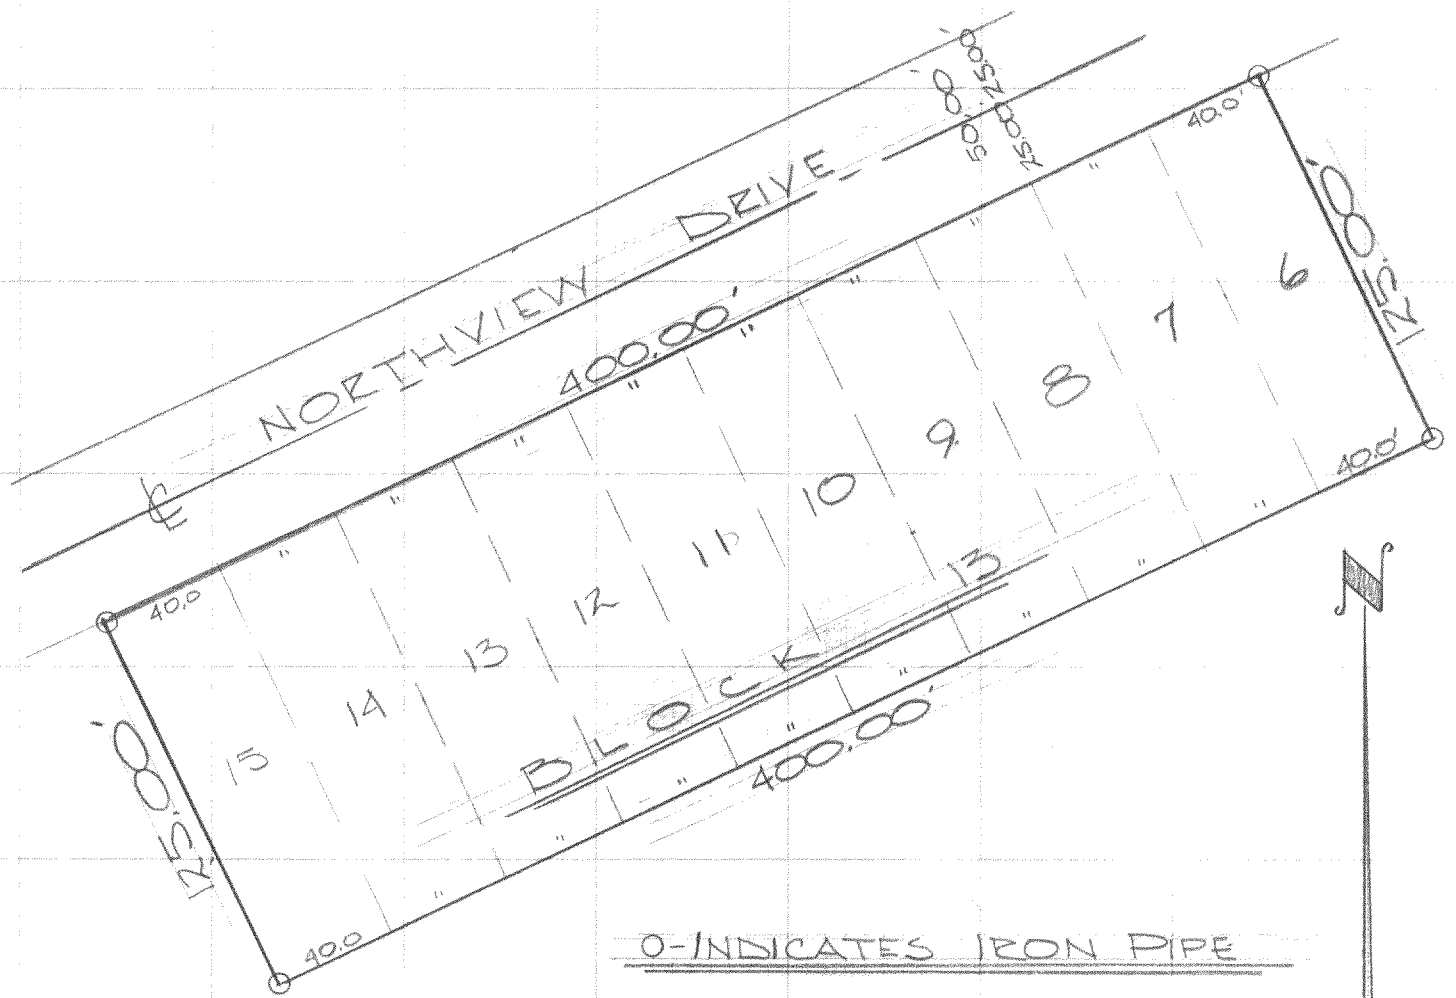

O-INDICATES IRON PIPE

DESCRIPTION: Lots 6, 7, 8, 9, 10, 11, 12, 13, 14, and 15 of Block 13 of Delavan Lake View Crest Subdivision, located in Section 31, T. 2 N., R. 16 E.. Walworth County, Wisconsin.

CERTIFICATE: I, James F. Biagi, surveyor do hereby certify that I have surveyed the property hereon described.

March 30, 1967.

James F. Biagi

James F. Biagi, RLS 272

WISCONSIN JAMES F. BIAGI MILWAUKEE WIS. LAND SURVEYOR

FDLW-51A, 52, 52A

216-59B