
PLAT OF SURVEY

Lots 31, and 32 of The Annex To Inlet Oaks, a subdivision located in the SE 1/4 of Section 15, and the NE 1/4 of Section 22, T 2 N, R 16 E, Town Of Delavan, Walworth County, Wisconsin.

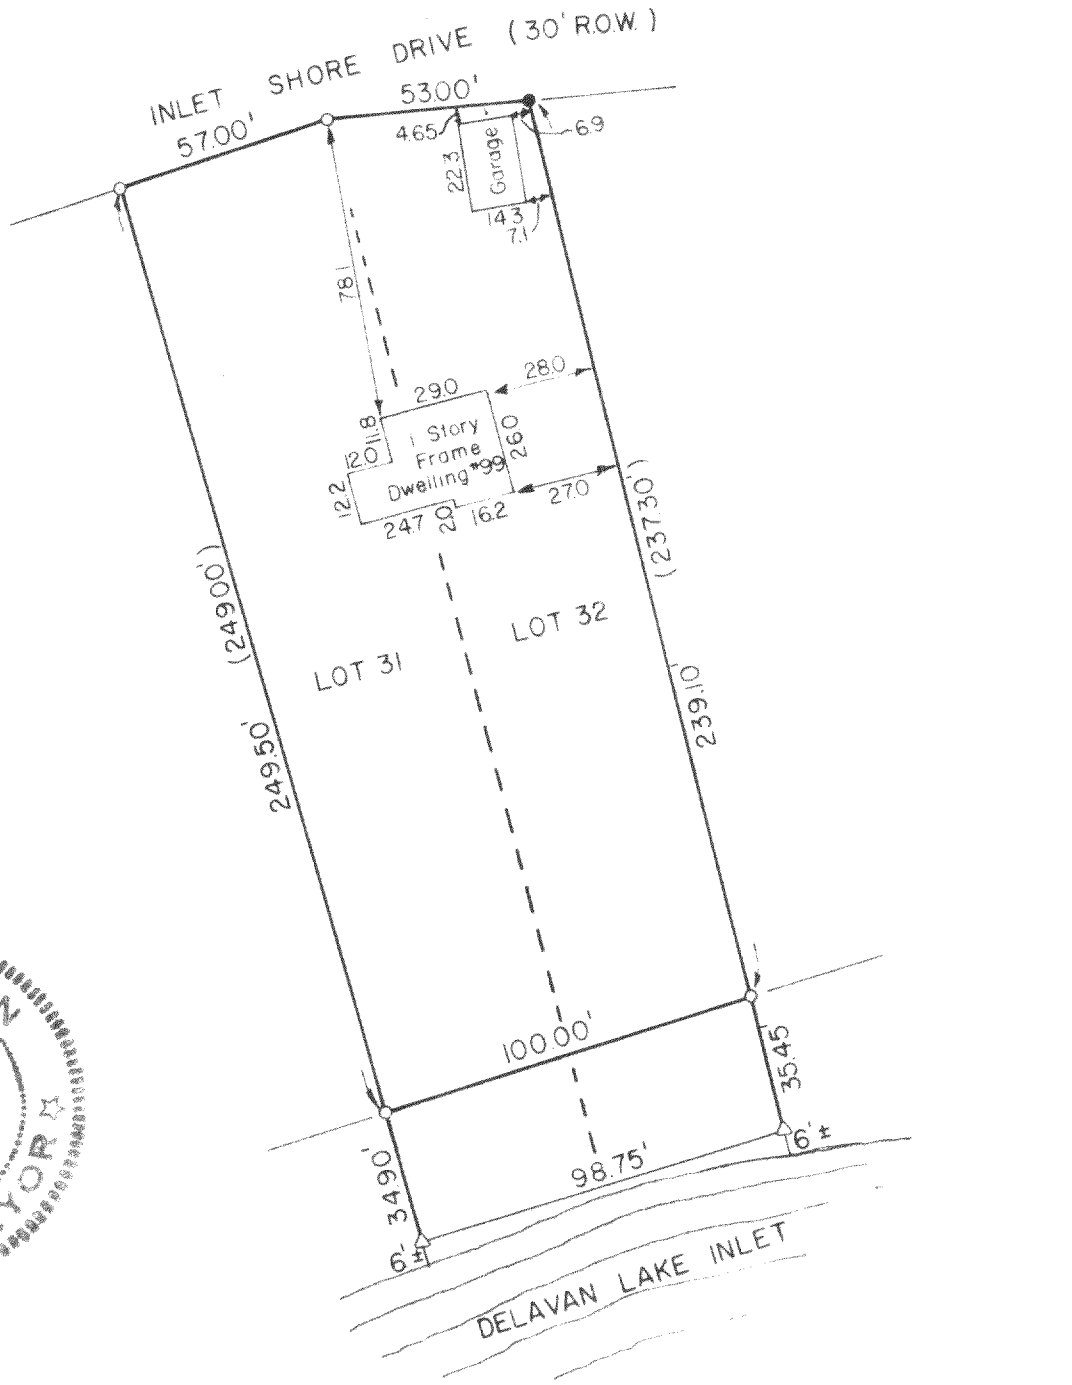

Scale 1" = 50'

KEY

- ○ Iron Pipe Set
- ● Iron Rod Set
- △ Plastic Stake Set
- ( ) Recorded As

WISCONSIN
RALPH L ANDERSON S 1327 DELAVAN WIS
LAND SURVEYOR

SURVEYOR'S CERTIFICATE

I have surveyed the above described property and the above map is a true representation thereof and shows the size and location of the property, its exterior boundaries, the location and dimensions of all visible structures thereon, fences, apparent easements and roadways and visible encroachments. This survey is made for the exclusive use of the present owners of the property, and also those who purchase, mortgage, or guarantee the title thereto within one (1) year from date hereof and as to them I warrant the accuracy of said survey and map.

11 November 1977
Date

Ralph L. Anderson
Ralph L. Anderson, RLS 1327

FIA-24

Prepared By	Prepared For	Date	Sheet Number
VALENTINE AND ASSOCIATES, INC. DELAVAN, WISCONSIN	CHARLES SIANO OAK LAWN, ILLINOIS	11/11/77	1 of 1
		Job Number 7793	Reference file

216-614