


Lot 18 in Woodland Shores, a subdivision in the Southeast 1/4 of Section 20 and the Southwest 1/4 of Section 21, Township 2 North, Range 16 East, Walworth County, Wisconsin, according to the recorded plat thereof recorded in Cabinet 8 of plats, Slides 74 and 75 as Document No. 120541. Town of Delavan, Walworth County, Wisconsin.

ORDERED BY:
JAMES HANNES

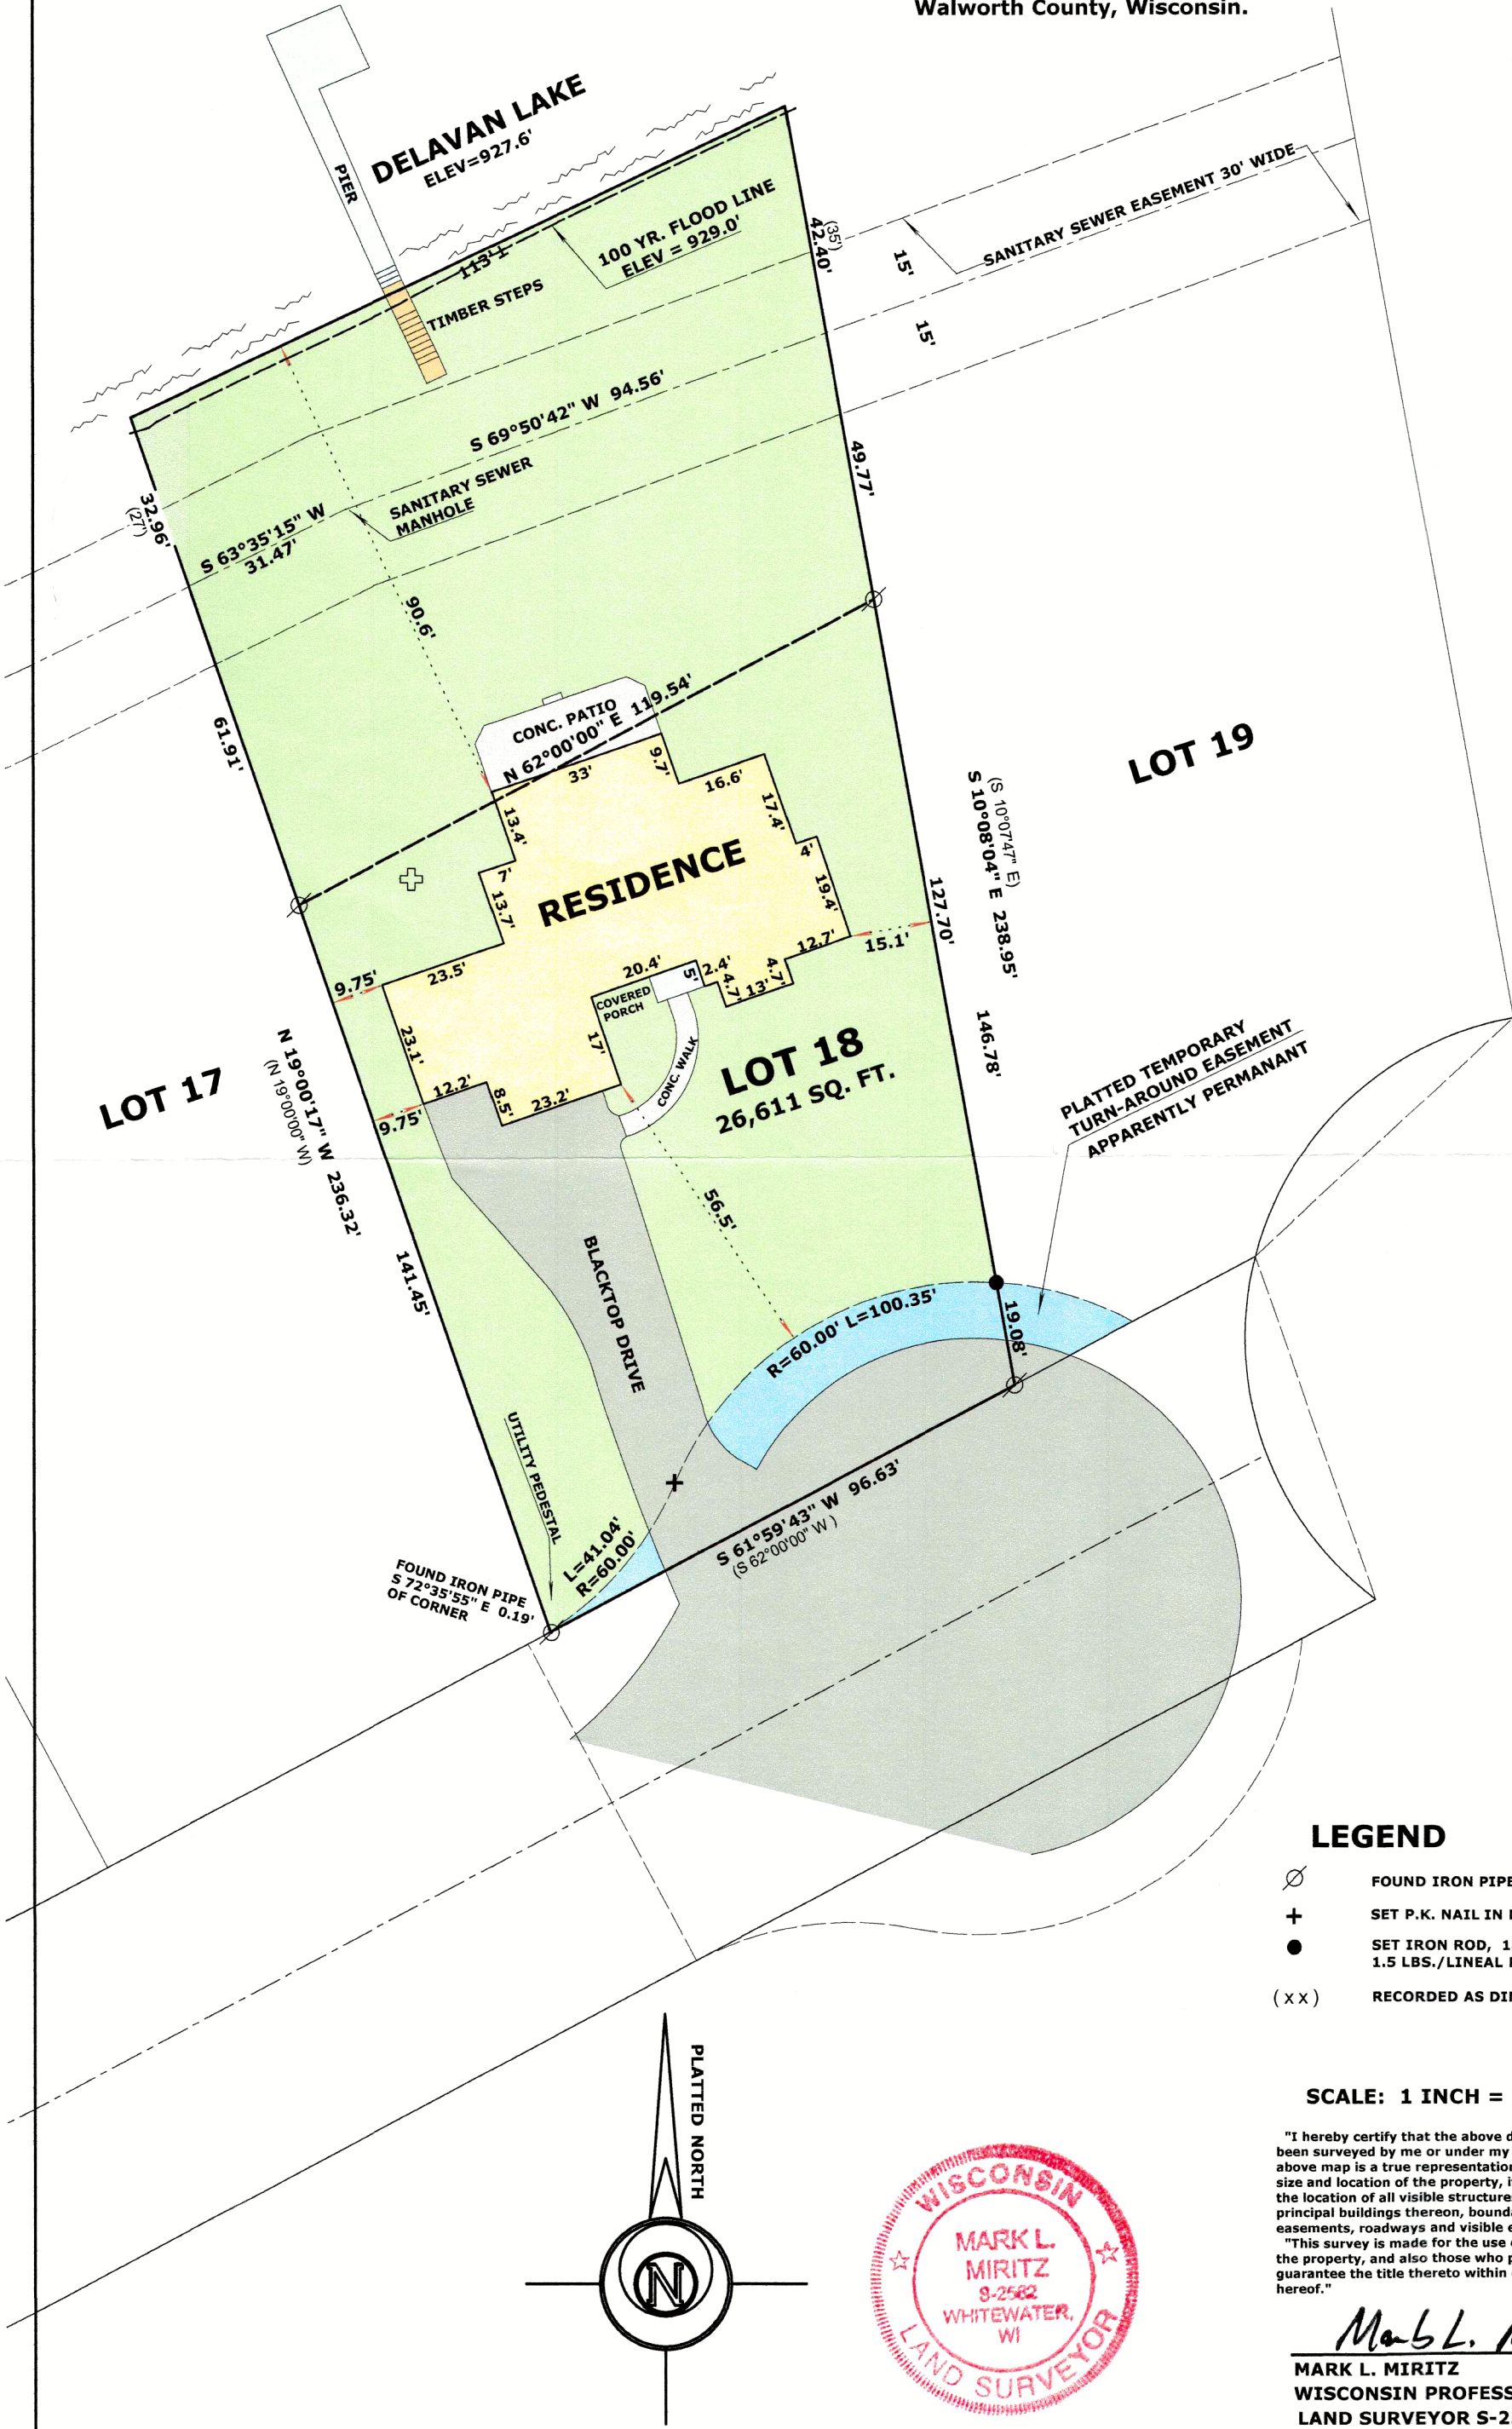

LEGEND

- FOUND IRON PIPE 1 1/4"
- SET P.K. NAIL IN DRIVE
- SET IRON ROD, 18" LONG, WEIGHING 1.5 LBS./LINEAL FT., 3/4" DIA.
- RECORDED AS DIMENSION

SCALE: 1 INCH = 30 FEET

"I hereby certify that the above described property has been surveyed by me or under my direction and that the above map is a true representation thereof and shows the size and location of the property, its exterior boundaries, the location of all visible structures and dimensions of all principal buildings thereon, boundary fences, apparent easements, roadways and visible encroachments, if any." "This survey is made for the use of the present owners of the property, and also those who purchase, mortgage, or guarantee the title thereto within one year from date hereof."

Mark L. Miritz
MARK L. MIRITZ
WISCONSIN PROFESSIONAL
LAND SURVEYOR S-2582

DATE: MARCH 12, 2024 JOB NO. 24.301

FWLS-18

216-4200