


PLAT OF SURVEY WITH TOPOGRAPHY
OF LOT 10, BLOCK "E", DELAVAN LAKE ASSEMBLY GROUND,
BEING PART OF THE NW 1/4 OF THE SE 1/4
OF SECTION 21, T. 2 N., R. 16 E., OF THE 4TH P.M.,
TOWN OF DELAVAN, WALWORTH COUNTY, WISCONSIN.

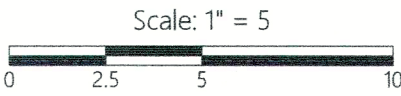

DISTANCE UNITS BASED ON THE UNITED STATES SURVEY FOOT
BEARINGS BASED ON THE WISCONSIN COORDINATE REFERENCE SYSTEM,
WALWORTH ZONE, THE WEST LINE OF 10
BEARING N 13° 49' 30" W.
VERTICAL DATUM BASED ON NAVD-88 (2012)
GEOID 18 WISCONSIN
STARTING BENCHMARK: NGS MONUMENT
PID: NH1666
PUBLISHED ELEVATION: 966.60

LEGEND

- Existing Boundary Line
- Existing Right-of-Way
- Existing Adjacent Property
- OH Existing Overhead Power
- (XXX.XX) Record Information
 - Iron Rebar Found (Size Noted)
 - Iron Pipe Found (Size Noted)
 - Mag Nail Found
 - Cut Cross Found
- Benchmark
- Existing Well
- Existing Air Conditioner
- Existing Electric Meter
- Existing Gas Meter
- Deciduous Tree
- Existing Utility Pole
- Existing Cleanout
- Existing Guy Wire
- Existing Spot Elevation

SURVEY NOTES

- SURVEYED PROPERTY SUBJECT TO ANY AND ALL EASEMENTS AND AGREEMENTS RECORDED AND UNRECORDED.
- THERE IS NO CURVE DATA ON THE ORIGINAL PLAT OF DELAVAN LAKE ASSEMBLY GROUNDS AND THE SOUTHERLY LINE OF LOT 10, BLOCK E WAS SCALED OFF THE ORIGINAL PLAT AND ASSUMED TO BE A LINE.



Kristin J. Belongia

Kristin J. Belongia, P.L.S.
Wisconsin Professional Land Surveyor S-2943

State of Wisconsin } ss

I hereby certify that I have supervised the survey of the property described above and to the best of my knowledge and belief, the plat drawn hereon complies with Chapter A-E 7 of the State of Wisconsin Administrative Code, Minimum Standards for Property Surveys and correctly represents said survey and its location.
Given under my hand and seal at Elkhorn, Wisconsin this 8th day of September, 2025.
Last day of field work September 9th, 2025.

If the surveyor's signature is not red in color, the plan is a copy that should be assumed to contain unauthorized alterations. The certification contained on this document shall not apply to any copies.