
PLAT OF SURVEY

A PARCEL OF LAND LOCATED IN THE NE 1/4 OF SECTION 9, TOWNSHIP 2 NORTH, RANGE 16 EAST IN DELAVAN TOWNSHIP, WALWORTH COUNTY, WISCONSIN

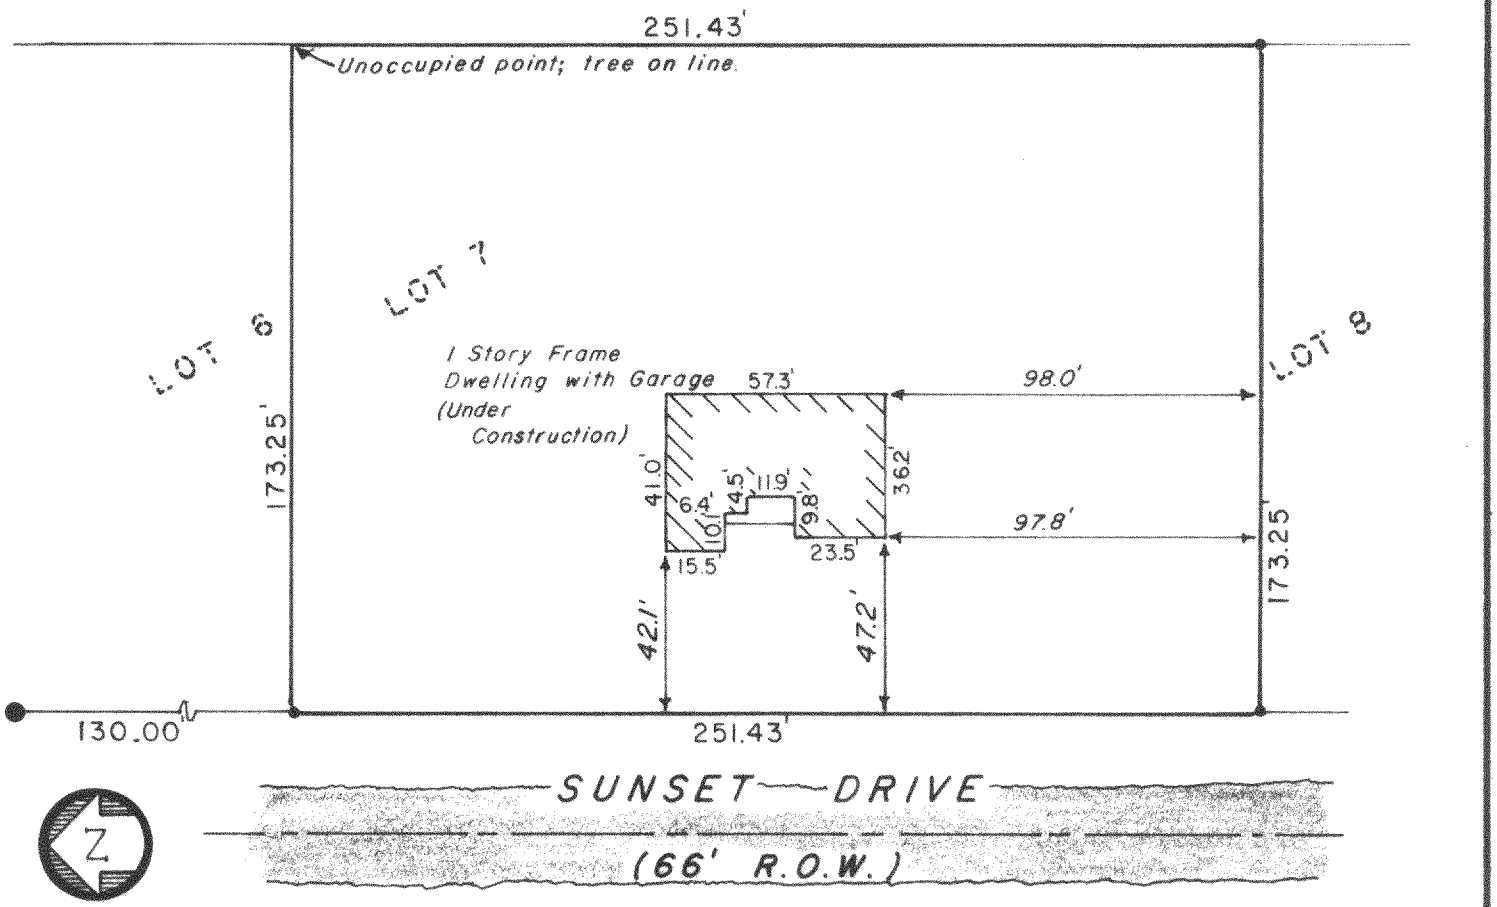

50' 0' 50'
Scale: 1" = 50'

KEY

● Iron Rod Found, 1-1/4" Dia.

• Iron Rod Found, 3/4" Dia.

DESCRIPTION: Lot 7 of Sunset Acres, a recorded subdivision located in the NE 1/4 of Section 9, Township 2 North, Range 16 East in Delavan Township, Walworth County, Wisconsin and recorded as Document No. 49160.

SURVEYOR'S CERTIFICATE: I hereby certify that I have surveyed the above described property and that the above map is a true representation thereof and shows the size and location of the property, its exterior boundaries, apparent easements, roadways and visible encroachments, if any. This survey is made for the use of the present owners of the property, and also those who purchase, mortgage, or guarantee the title thereto within one (1) year from date hereof.

February 11, 1980
Date

Dennis W. Valentine
Dennis W. Valentine, RLS 1419

WISCONSIN DENNIS W. VALENTINE S-1419 STATE OF WIS. HARVARD, ILL. LAND SURVEYOR

SURVEYOR'S OFFICE

Prepared By	Prepared For	Date	Sheet Number
VALENTINE AND ASSOCIATES, INC. DELAVAN, WISCONSIN	MARTIN VENEMA DELAVAN, WISCONSIN	2/10/80	1 of 1
		Job Number 80002	Reference File

FSVA 00007

216-720