
DUNHAM SURVEYING, S. C.
SURVEYING & SUBDIVIDING
DELAVAN, WISCONSIN 53115

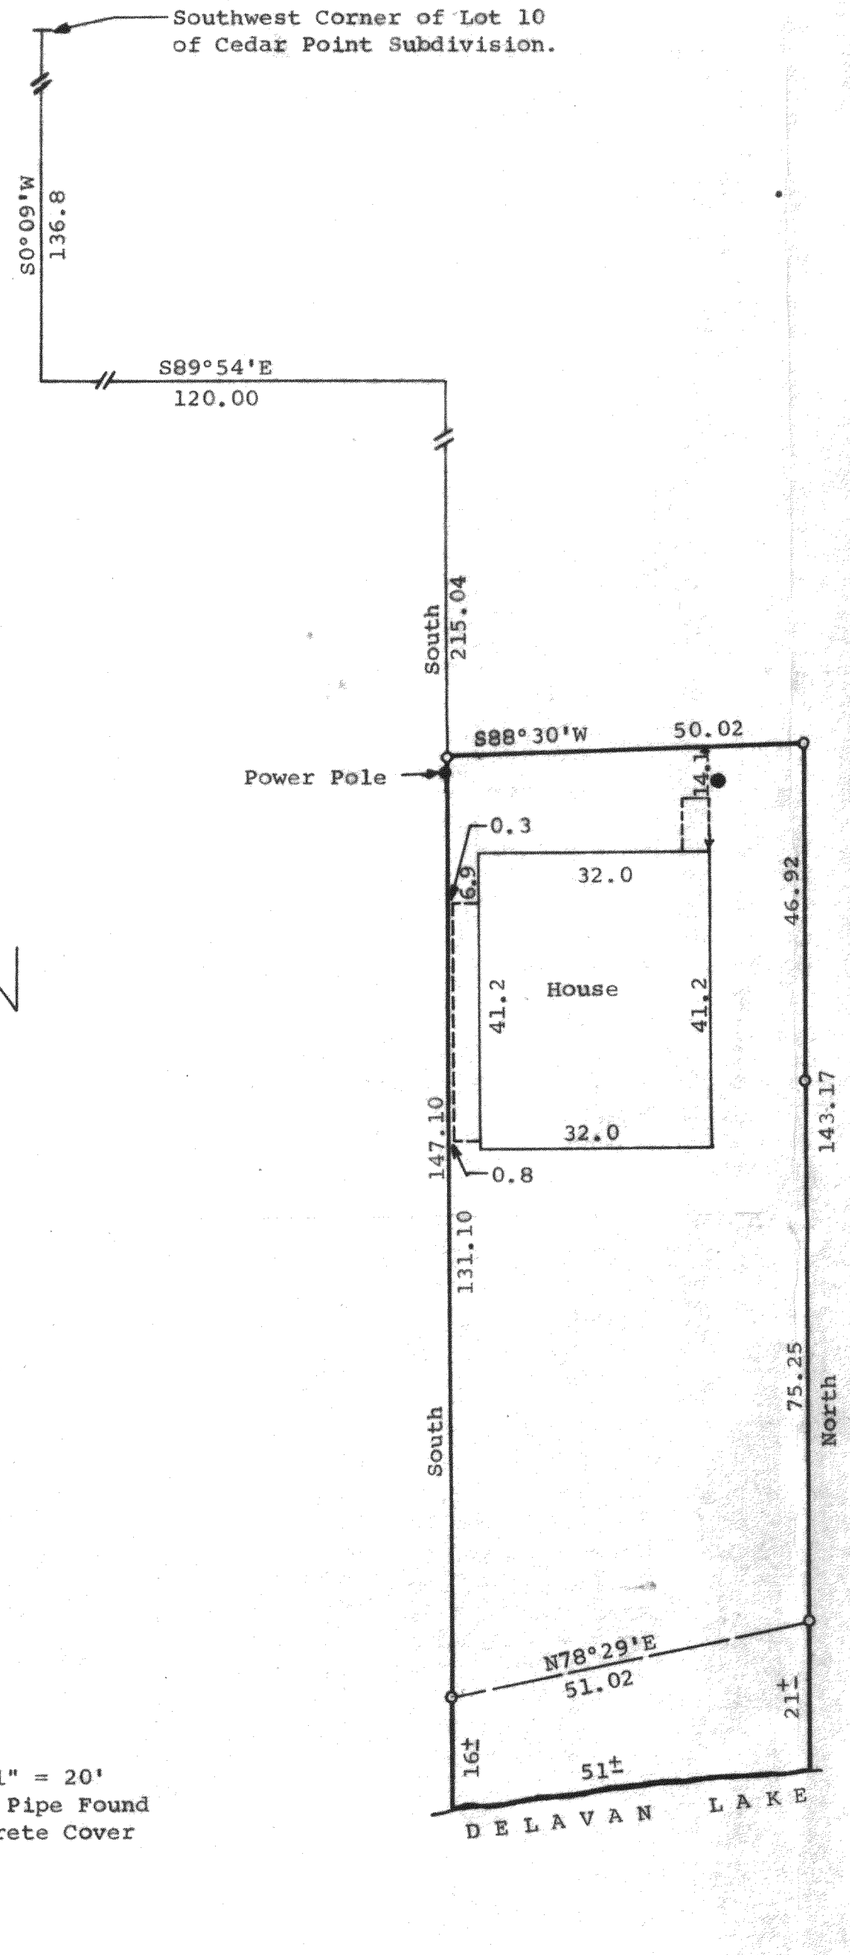

STATE OF WISCONSIN)
COUNTY OF WALWORTH) SS

I, James M. Dunham, Surveyor, certify that I have surveyed the property described as follows,

A part of Lot 9 of Cedar Point, according to a plat thereof recorded in the Office of the Register of Deeds in and for Walworth County, Wisconsin, in Volume 6 of Plats on pages 50 and 51, and located in the Northeast fractional ¼ of Section 28, T2N, R16E, described as follows: Commencing at the Southwest corner of Lot 10 of said Cedar Point; thence S0°09'W along the West line of said Lot 9, 136.8 feet to a point; thence S89°54'E, 120.00 feet to a point; thence South 215.04 feet to the place of beginning; thence continue South 147.10 feet (recorded as 139.17 feet) to the shore of Delavan Lake; thence Easterly along the shore 51 feet more or less to a point that is located 50 feet East of, at right angles from the last mentioned line; thence North, 143.17 feet (recorded as 132.24 feet) to an iron pipe; thence S88°30'W, 50.02 feet to an iron pipe and the place of beginning, subject to easements of record.

and that the above map is a true representation thereof and shows the size and location of the property, its exterior boundaries, the location of all visible structures and dimensions of all principal buildings thereon, boundary fences, apparent easements, roadways and visible encroachments, if any.

This survey is made for the use of the present owners of the property and also those who purchase, mortgage, or guarantee the title thereto within one (1) year from date hereof.

November 10, 1980

James M Dunham

James M. Dunham, Surveyor

WISCONSIN
JAMES M. DUNHAM
S-1331
DELAVAN, WIS.
LAND SURVEYOR

FC-9D

216-724-D