DUNHAM SURVEYING, S. C.

SURVEYING & SUBDIVIDING

DELAVAN, WISCONSIN 53115

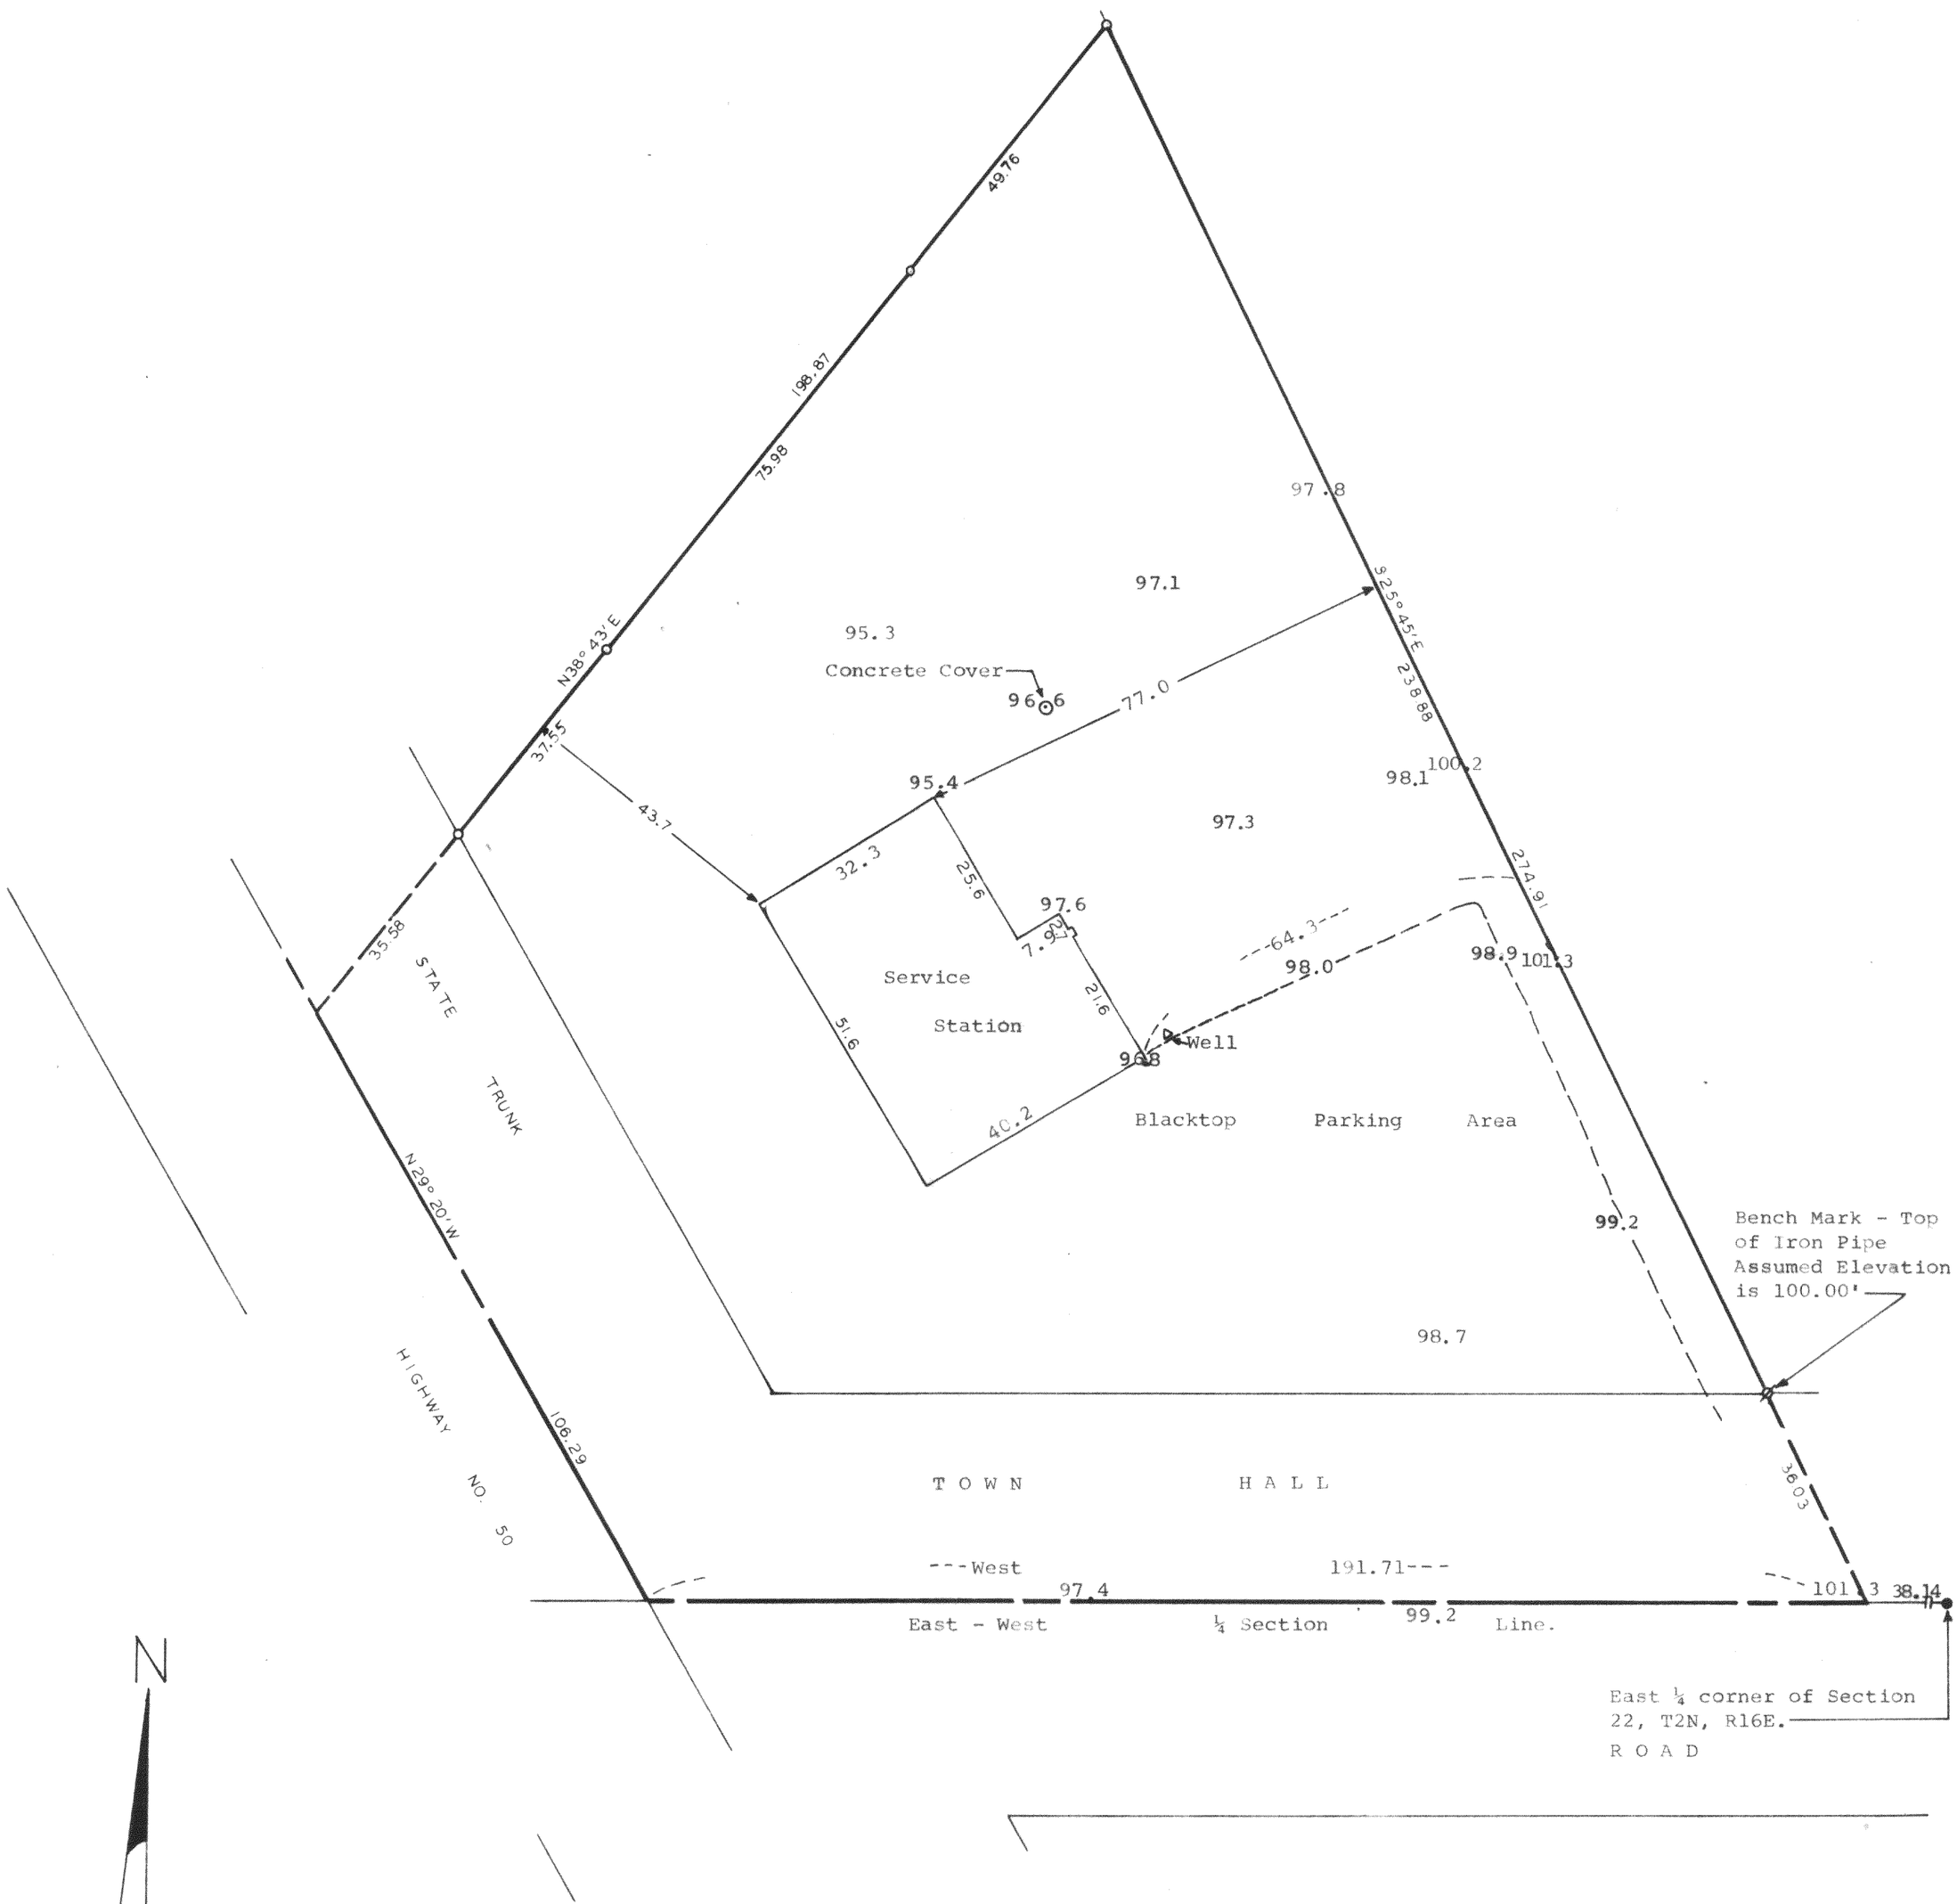

Plat of a Survey of:
A parcel of land located in the Northeast ¼ of Fractional Section 22, T2N, R16E, Walworth County, Wisconsin, described as follows: Commencing at the East ¼ Section corner of said Section 22; thence West, along the ¼ Section line, 38.14 feet to the place of beginning; thence continue West on the ¼ Section line, 191.71 feet to a point in the centerline of State Trunk Highway No. 50; thence N29°20'W, along said centerline, 106.29 feet to a point; thence N38°43'E, 198.87 feet to a point; thence S25°45'E, 274.91 feet to said ¼ Section line and the place of beginning.
December 12, 1980

James M. Dunham

James M. Dunham, Surveyor

WISCONSIN
JAMES M. DUNHAM
S-1331
DELAVAN, WIS.
LAND SURVEYOR

Scale - 1" = 20'
● = Concrete Monument
o = Iron Pipe Found
ø = Iron Pipe Set

K & E 10-9155

D-22-6