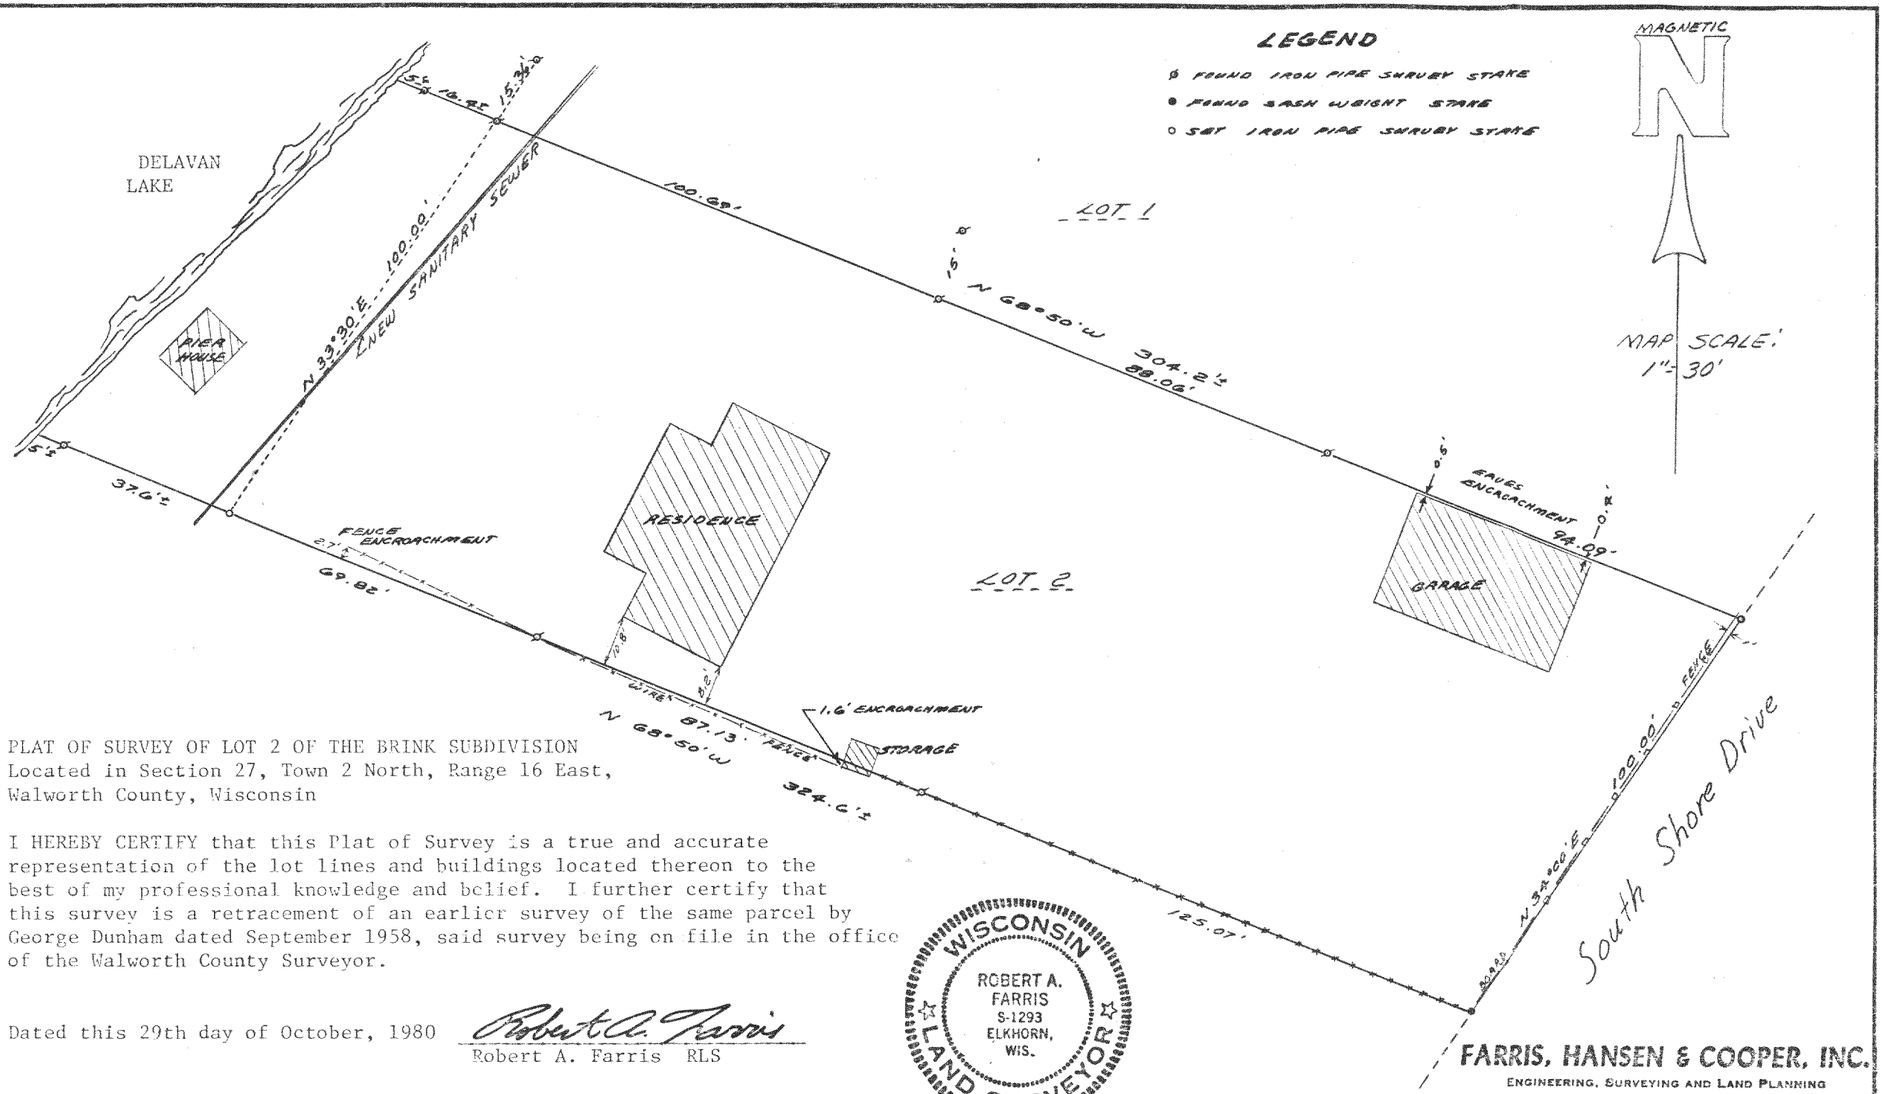

PLAT OF SURVEY OF LOT 2 OF THE BRINK SUBDIVISION
Located in Section 27, Town 2 North, Range 16 East,
Walworth County, Wisconsin

I HEREBY CERTIFY that this Plat of Survey is a true and accurate representation of the lot lines and buildings located thereon to the best of my professional knowledge and belief. I further certify that this survey is a retracement of an earlier survey of the same parcel by George Dunham dated September 1958, said survey being on file in the office of the Walworth County Surveyor.

Dated this 29th day of October, 1980 Robert A. Farris

Robert A. Farris RLS

WISCONSIN ROBERT A. FARRIS S-1293 ELKHORN, WIS. LAND SURVEYOR

FARRIS, HANSEN & COOPER, INC.
ENGINEERING, SURVEYING AND LAND PLANNING
715 W. WALWORTH ST. - P.O. BOX 487 - ELKHORN, WI 53121

PROJECT 1769
216-741-F

FBS-2