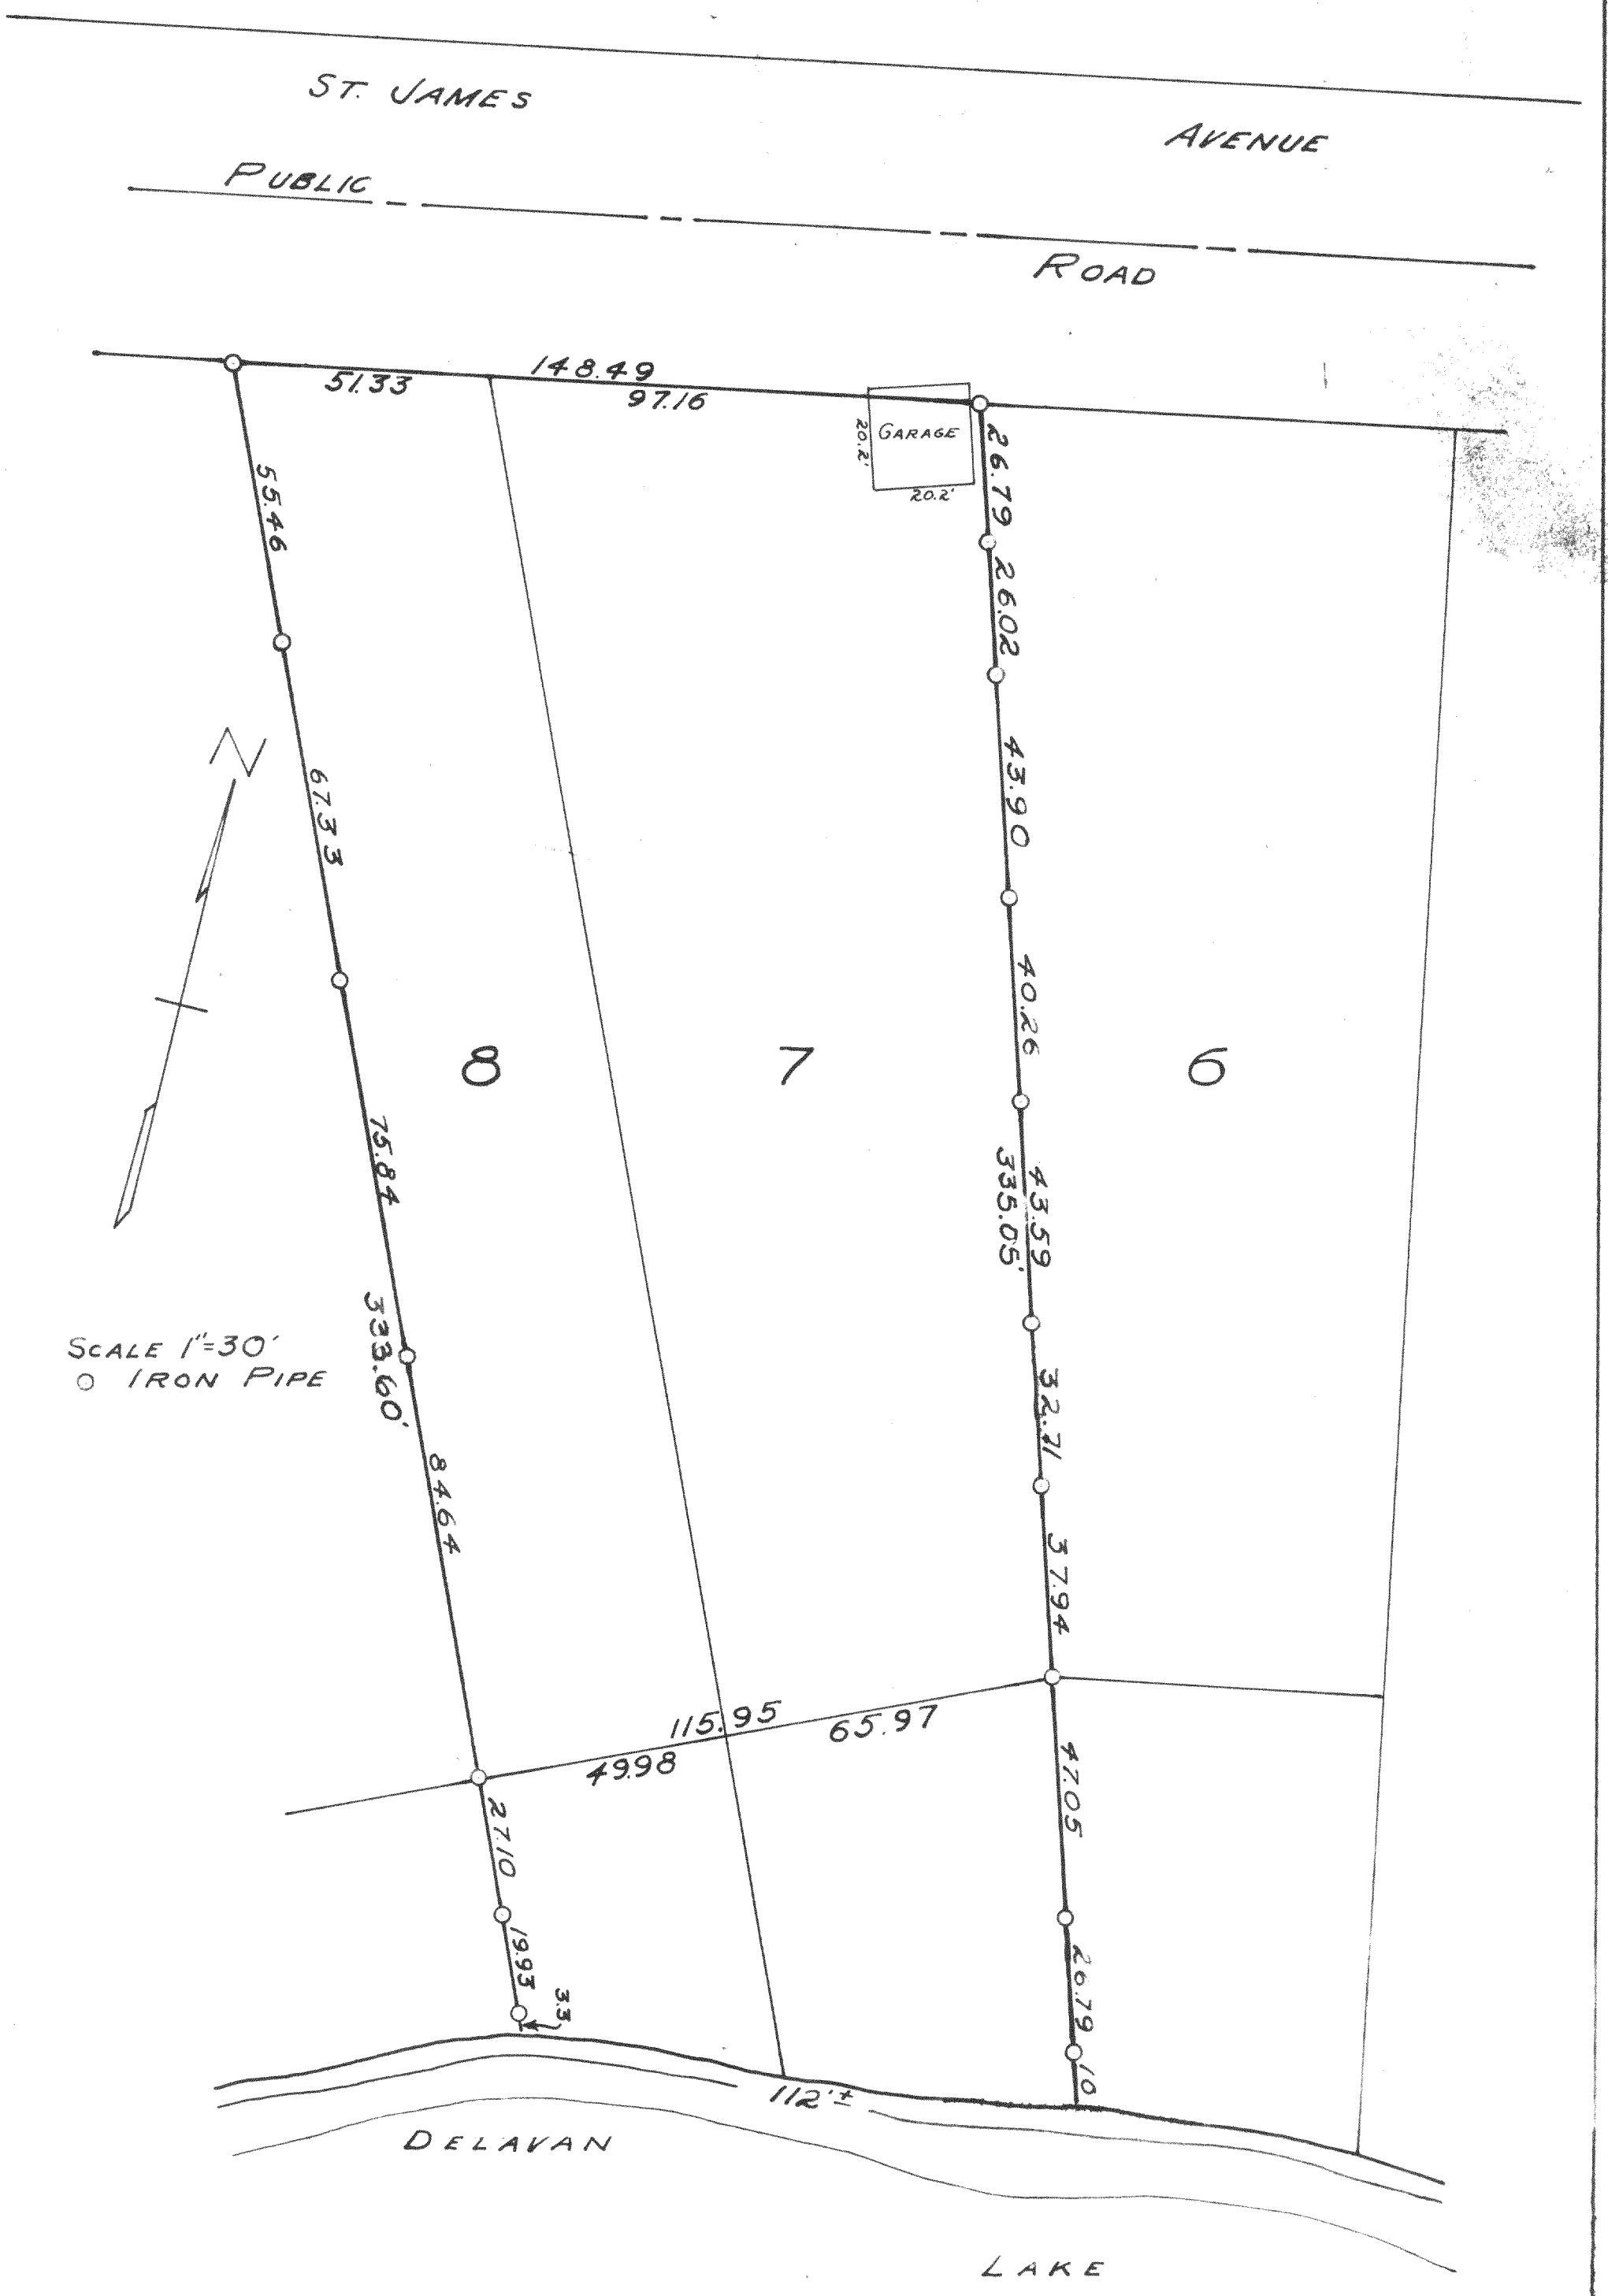


PLAT OF SURVEY OF LOTS 7 AND 8 IN ST. MARY'S SUBDIVISION LOCATED IN SECTION 28, T2N, R16E OF WALWORTH COUNTY, WISCONSIN.

SEPT. 1948

Lloyd L. Jensen
COUNTY SURVEYOR

FS-4

216-75.1