

DUNHAM SURVEYING, S. C.

SURVEYING & SUBDIVIDING

DELAVAN, WISCONSIN 53115

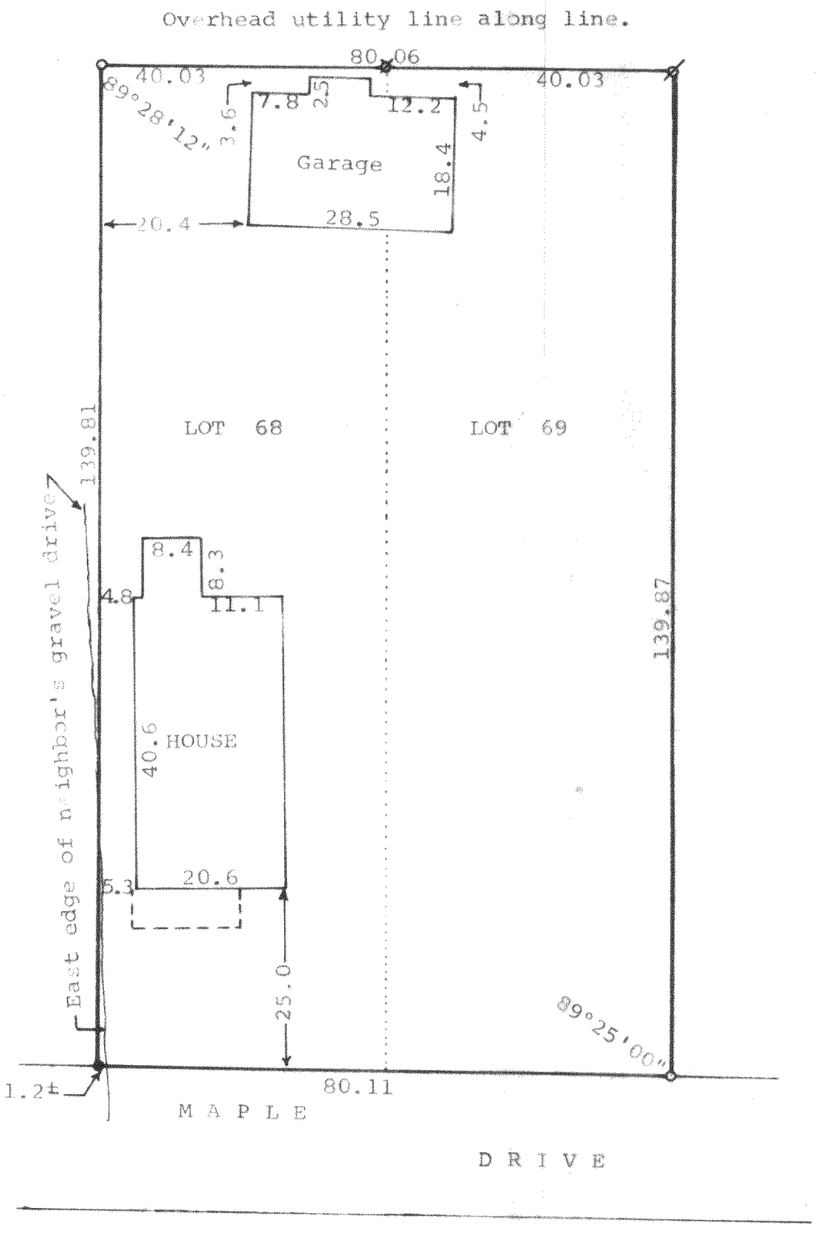

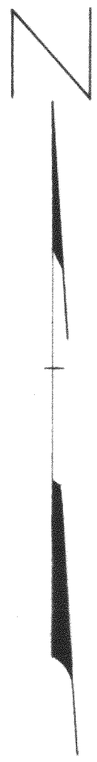

Scale - 1" = 20'

ø = Iron Pipe Found

o = Iron Pipe Set

● = Iron Rod

STATE OF WISCONSIN)
COUNTY OF WALWORTH) SS

I, James M. Dunham, Surveyor, certify that I have surveyed the property described as follows,

Lots 68 and 69 of Krumhaar's 3rd Addition to Ravenswood, a subdivision located in Section 31, T 2 N, R 16 E, Walworth County, Wisconsin,

and that the above map is a true representation thereof and shows the size and location of the property, its exterior boundaries, the location of all visible structures and dimensions of all principal buildings thereon, boundary fences, apparent easements, roadways and visible encroachments, if any.

This survey is made for the use of the present owners of the property, and also those who purchase, mortgage, or guarantee the title thereto within one (1) year from date hereof.

February 22, 1982

James M Dunham

James M. Dunham, Surveyor

WISCONSIN
JAMES M. DUNHAM
S-1331
DELAVAN, WIS.
LAND SURVEYOR

FRA3-11,12

K & E 10-9155

Lots 68 + 69 of Krumhaar's 3rd add.

216-770