
DUNHAM SURVEYING, S. C.

SURVEYING & SUBDIVIDING

DELAVAN, WISCONSIN 53115

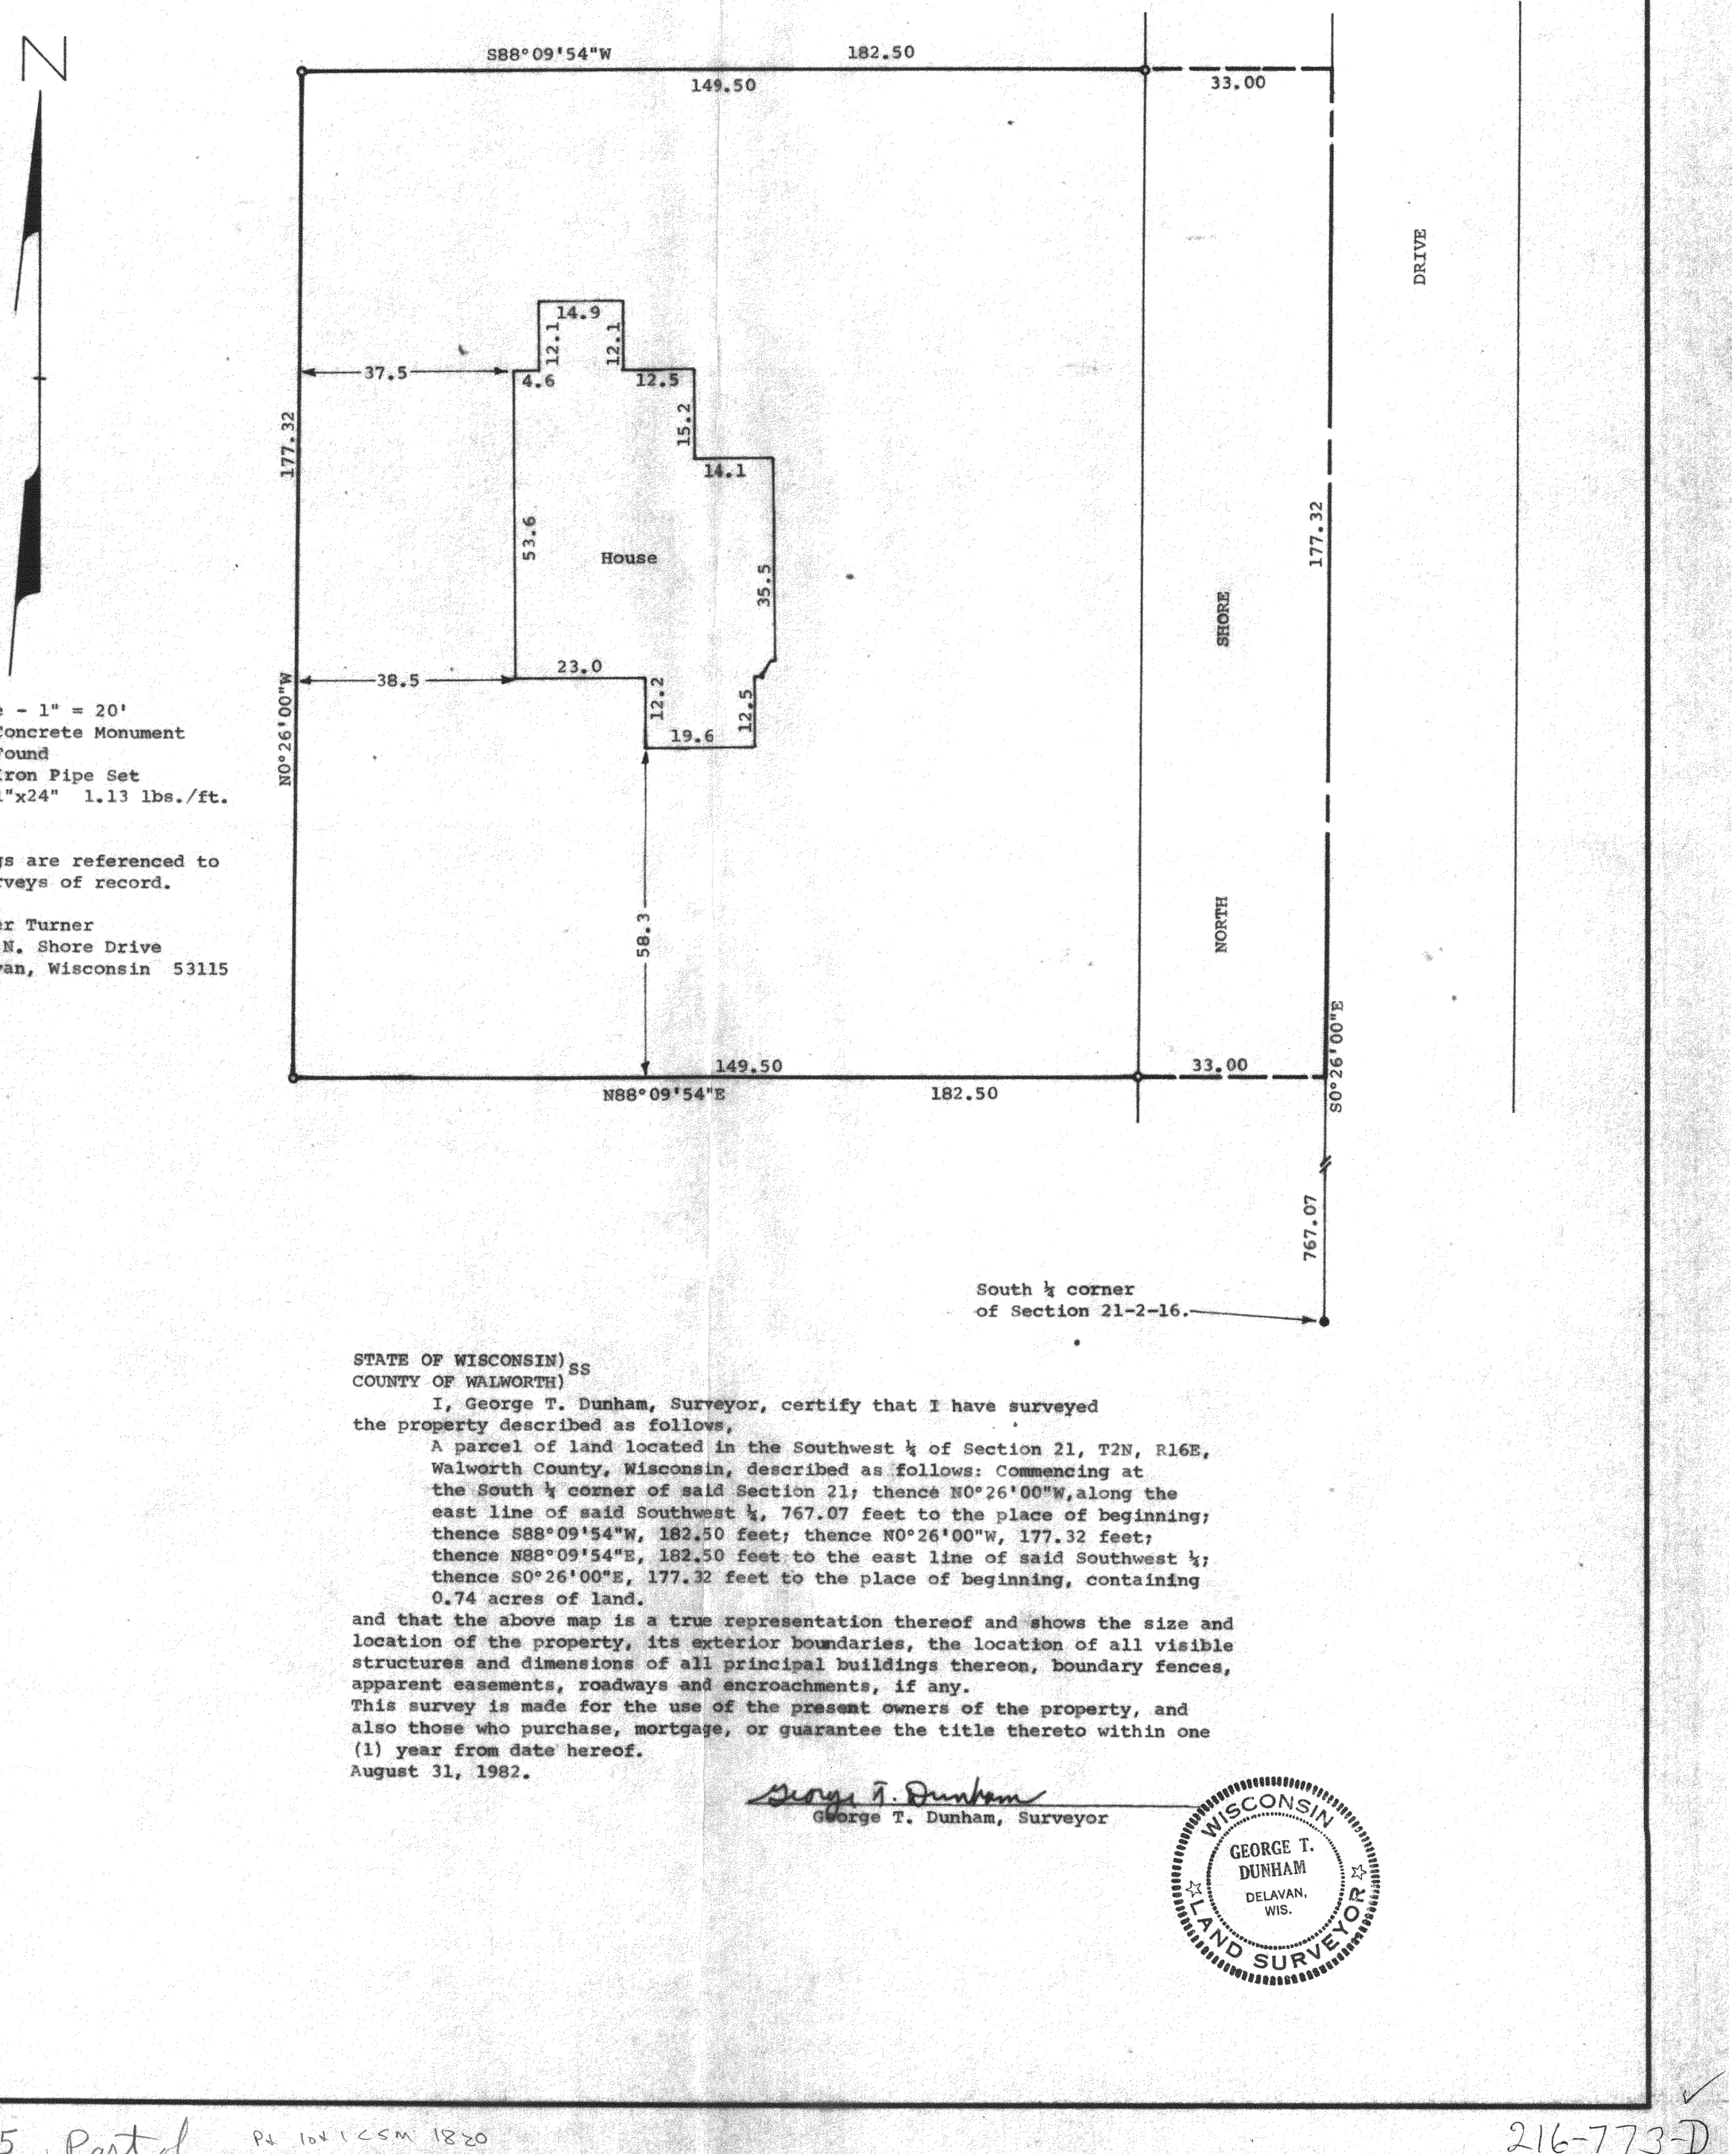

Scale - 1" = 20'

● = Concrete Monument Found

o = Iron Pipe Set 1"x24" 1.13 lbs./ft.

Note: Bearings are referenced to the surveys of record.

Owner: Walter Turner
1815 N. Shore Drive
Delavan, Wisconsin 53115

STATE OF WISCONSIN) SS
COUNTY OF WALWORTH)

I, George T. Dunham, Surveyor, certify that I have surveyed the property described as follows,

A parcel of land located in the Southwest ¼ of Section 21, T2N, R16E, Walworth County, Wisconsin, described as follows: Commencing at the South ¼ corner of said Section 21; thence N0°26'00"W, along the east line of said Southwest ¼, 767.07 feet to the place of beginning; thence S88°09'54"W, 182.50 feet; thence N0°26'00"W, 177.32 feet; thence N88°09'54"E, 182.50 feet to the east line of said Southwest ¼; thence S0°26'00"E, 177.32 feet to the place of beginning, containing 0.74 acres of land.

and that the above map is a true representation thereof and shows the size and location of the property, its exterior boundaries, the location of all visible structures and dimensions of all principal buildings thereon, boundary fences, apparent easements, roadways and encroachments, if any.

This survey is made for the use of the present owners of the property, and also those who purchase, mortgage, or guarantee the title thereto within one (1) year from date hereof.

August 31, 1982.

George T. Dunham
George T. Dunham, Surveyor

WISCONSIN
GEORGE T. DUNHAM
DELAVAN, WIS.
LAND SURVEYOR

M & E 109155

D-21-245, Part of Pt lot 1 CSM 1820

216-773-D