
KOLB LAND CONSULTING, INC.

LAND SURVEYING · SUBDIVIDING · LAND PLANNING

LAKE GENEVA, WISCONSIN 53147

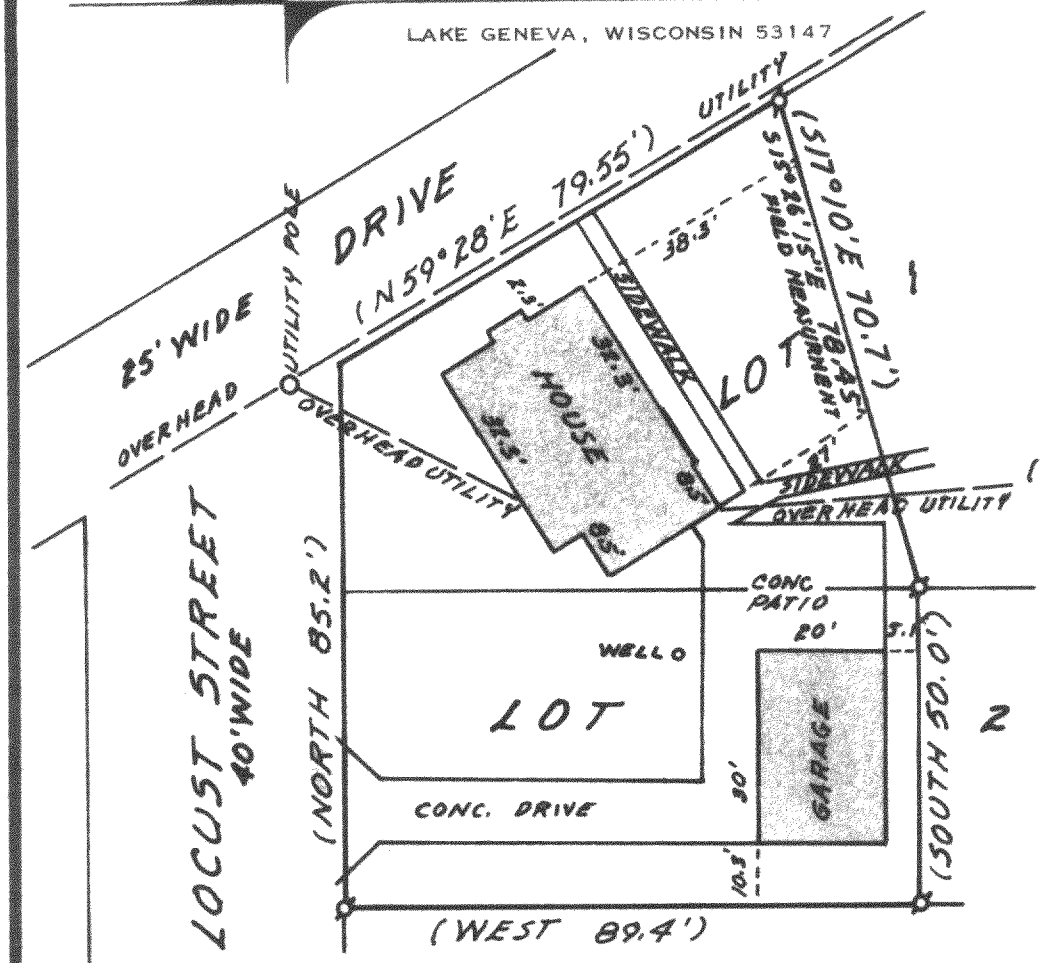

SCALE: 1"=30'

LEGEND
Ø IRON PIPE FOUND
( ) AS RECORDED

PLAT OF SURVEY OF

PART OF LOTS 1 & 2, LAKE VIEW SUBDIVISION, LOCATED IN SECTION 32, T 2 N, R 16 E, TOWN OF DELAVAN, WALWORTH COUNTY, WISCONSIN. TAX KEY NO. FLAS-2

ORDERED BY: I.D.L. MORTGAGE CORP
P.O. BOX 1256
KENOSHA, WI. 53141
FOR: JAMES V. & EVELYN M. LARSEN
4230 LOCUST STREET
DELAVAN, WI. 53115

NOTE: THE PLACEMENT OF MONUMENTS HAS BEEN WAIVED BY THE CLIENT AS PERMITTED IN A-E 5.01(B)

I HEREBY CERTIFY THAT I HAVE SURVEYED THE ABOVE DESCRIBED PROPERTY AND THAT THE ABOVE MAP IS A TRUE REPRESENTATION THEREOF AND SHOWS THE SIZE AND LOCATION OF THE PROPERTY, ITS EXTERIOR BOUNDARIES, THE LOCATION OF ALL VISIBLE STRICTURES AND DIMENSIONS OF ALL PRINCIPAL BUILDINGS THEREON, BOUNDARY FENCES, APPARENT EASEMENTS, ROADWAYS AND VISIBLE ENCROACHMENTS, IF ANY.

THIS SURVEY IS MADE FOR THE USE OF THE PRESENT OWNERS OF THE PROPERTY, AND ALSO THOSE WHO PURCHASE, MORTGAGE, OR GUARANTEE THE TITLE THERETO WITHIN ONE (1) YEAR FROM THE DATE HEREOF.

WISCONSIN HAROLD H. KOLB S-187 LAKE GENEVA, WIS. LAND SURVEYOR

Harold H. Kolb

WISCONSIN REGISTERED LAND SURVEYOR, S- 187

DATE APRIL 4, 1938

216-774-K

FLAS-00002

2-16-FLAS-2